


SECTION NO 3

370
N 1000

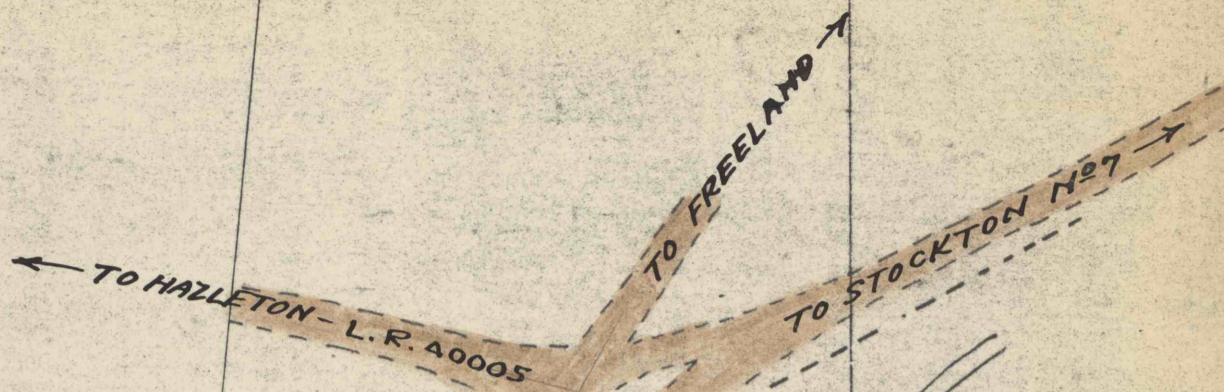

FACE OF OLD MAMMOTH
BREAST AT OUTCROP
CAVED 2-25-43

BURG.
ST.

MOTH

STRIPPING

ST

WHARTON GWY.

No. 1222

No. 3968

STRIPPING

COAL

EDGE

TUNNEL

No 9 ROCK GWY.

TO STOCKTON

45

JEDDO-HIGHLAND COAL CO.
MINING DEPARTMENT
JEDDO, PA.
STOCKTON MINE
PRINT OF MAMMOTH VEIN
SHOWING CROP CAVE UNDER
HIGHWAY - LEG. RT. #4000A
SCALE 1" = 100' DATE 2-26-43

