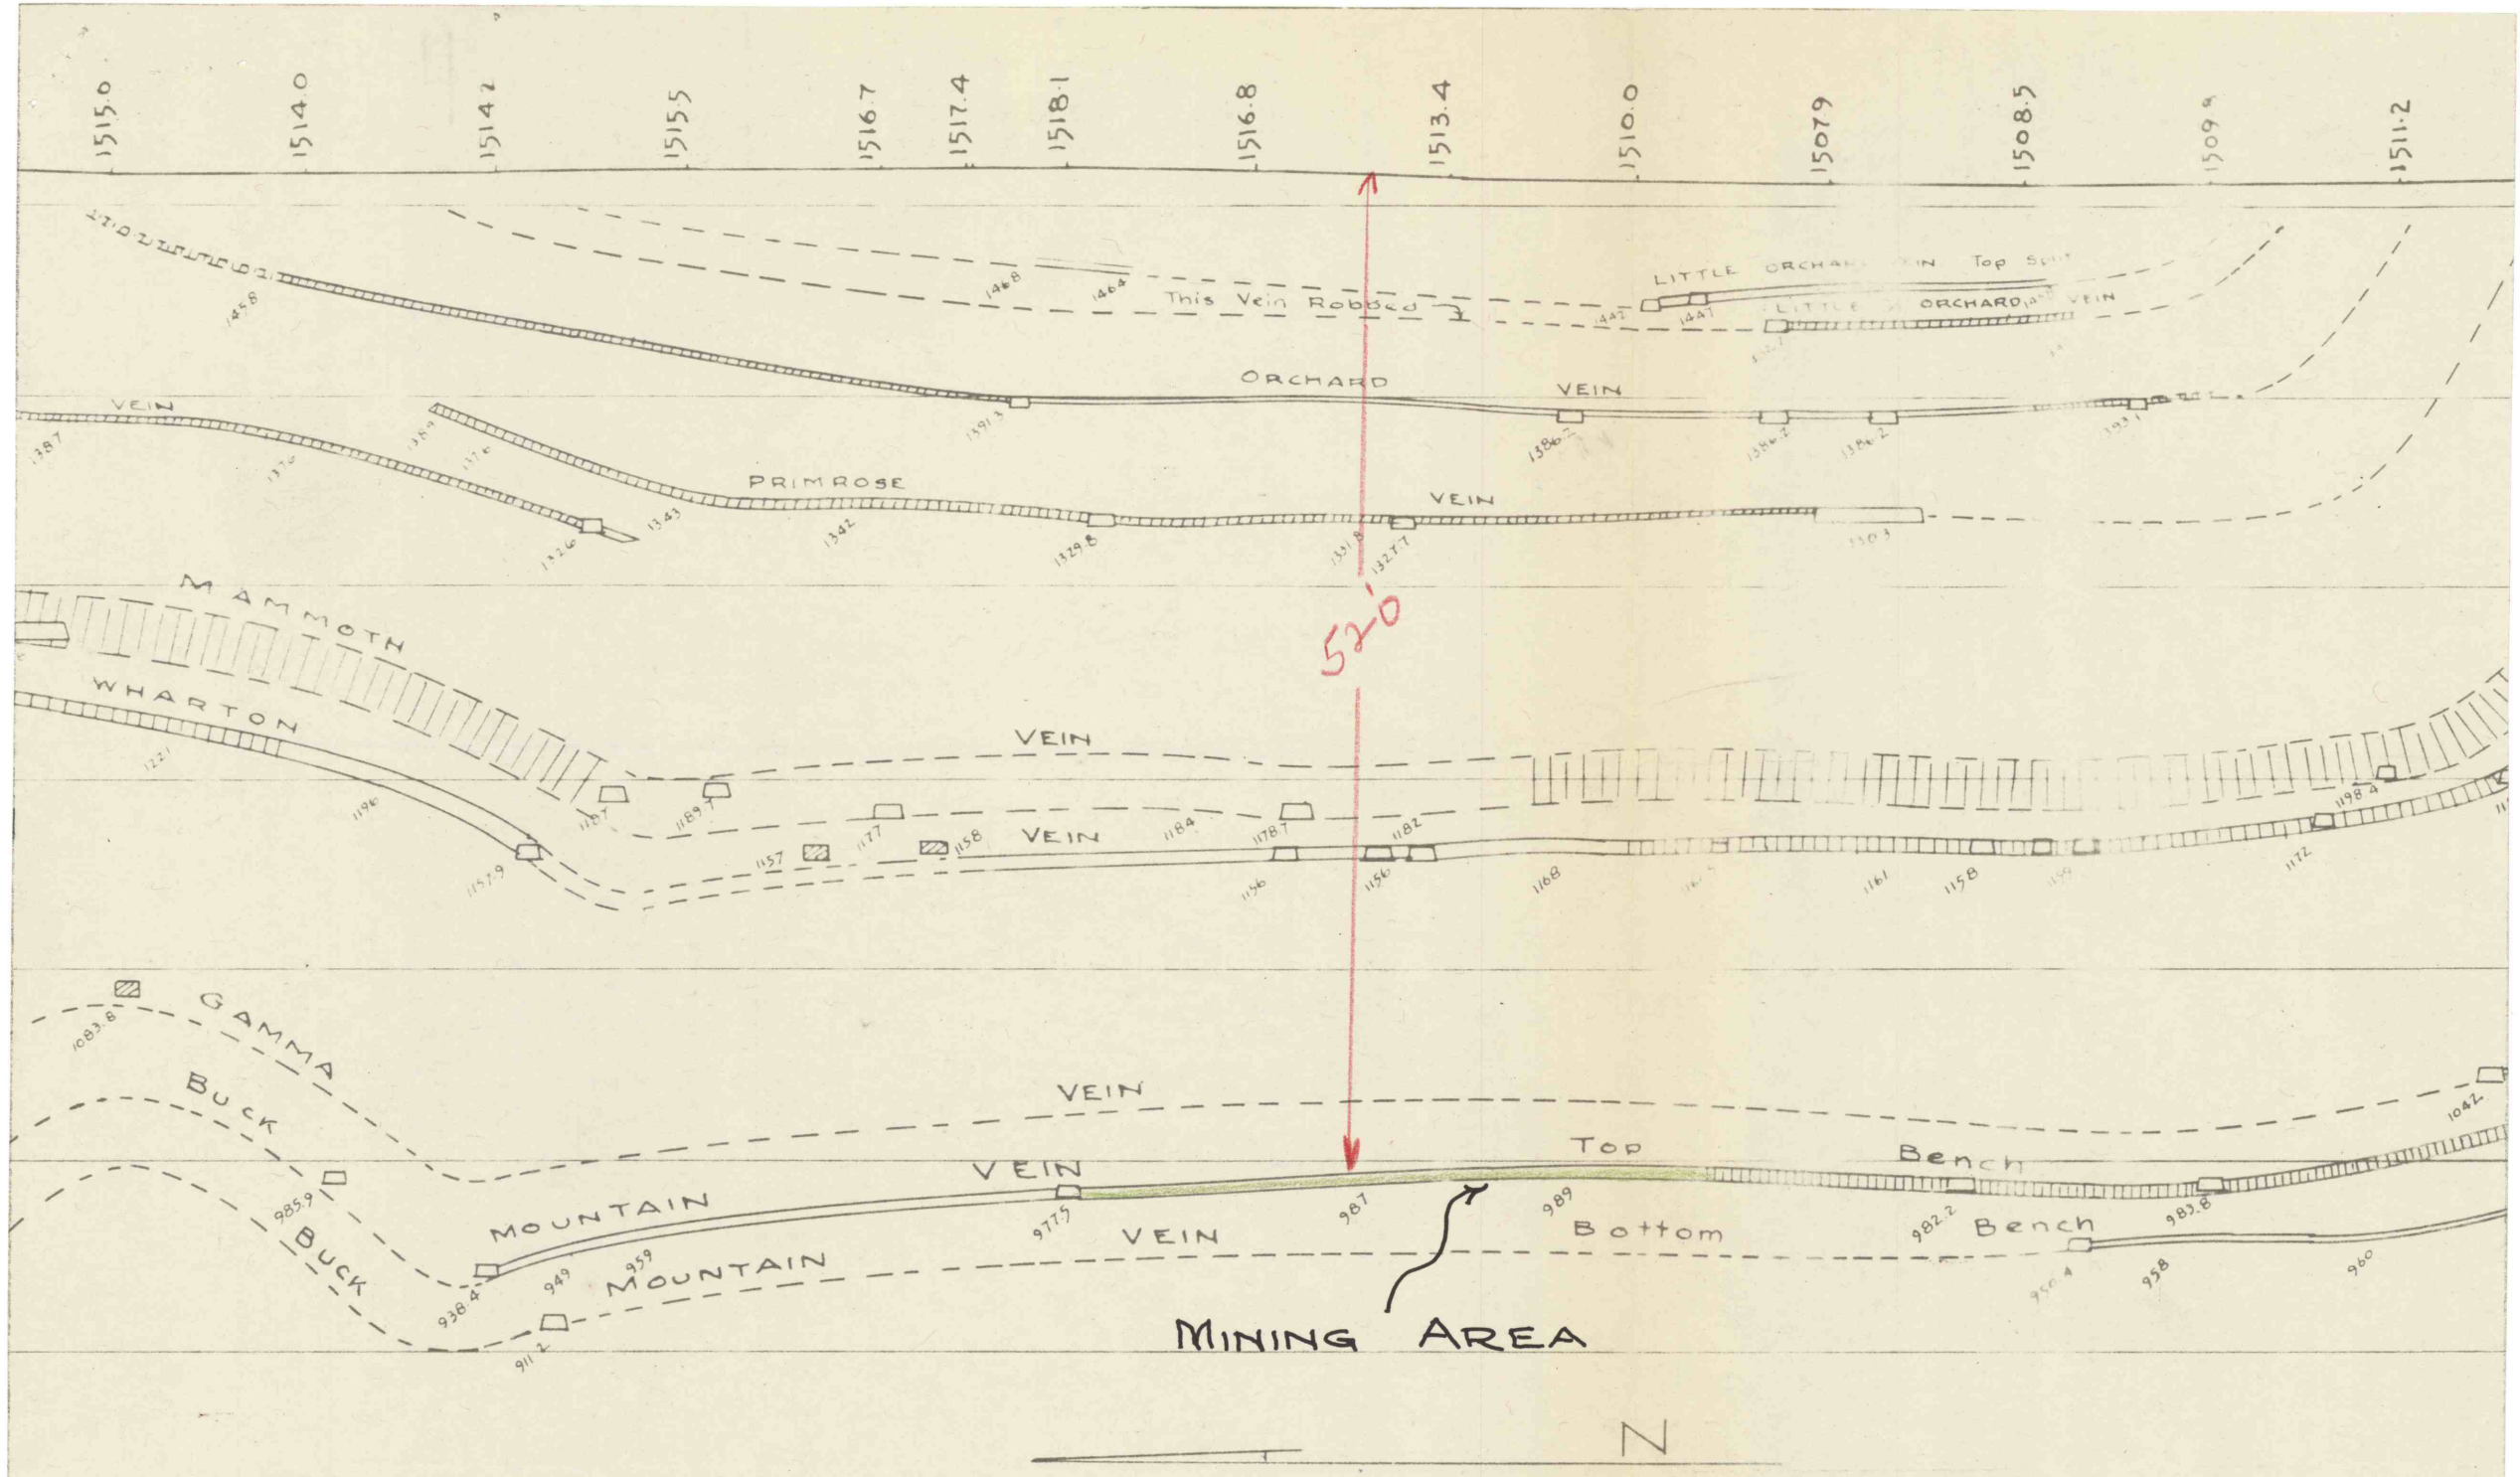

Cross section thru ℄ Highway

JEDDO № 4 COLLIERY, LUZERNE COUNTY, PA.
OWNER (Surface & Mineral) – Union Improvement Co., 1416 Chestnut Street, Phila., Pa.
UNDER LEASE to Jeddo-Highland Coal Co., Jeddo, Pa.
OPERATOR – JEDDO-HIGHLAND COAL CO., JEDDO, PA.
MINING ENGINEER – Mr. E. B. Snyder, Jeddo, Pa.
GEN. SUPERINTENDENT – Mr. W. C. Jones, Jeddo, Pa.
Scale 1" = 100'

April 23, 1945.