


1584 ← To Hazleton Leg. Rte. 40102 1589 + To Jeddo → 1591.4

1567
1562

N

Scale 1"=100'

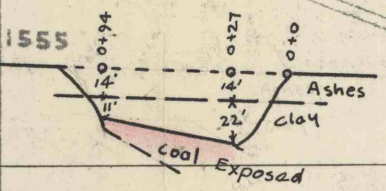


Cross-Section thru Highway

1571.4

Leg. Rte. 40004 E 18000

Highway

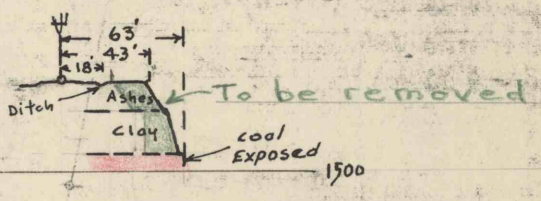

Cross-Section at 0+27

1553

15538 +

Edge of Stripping
Coal Exposed

MAMMOTH VEIN

Jeddo No 1

West Gangway

Skyline

15+5