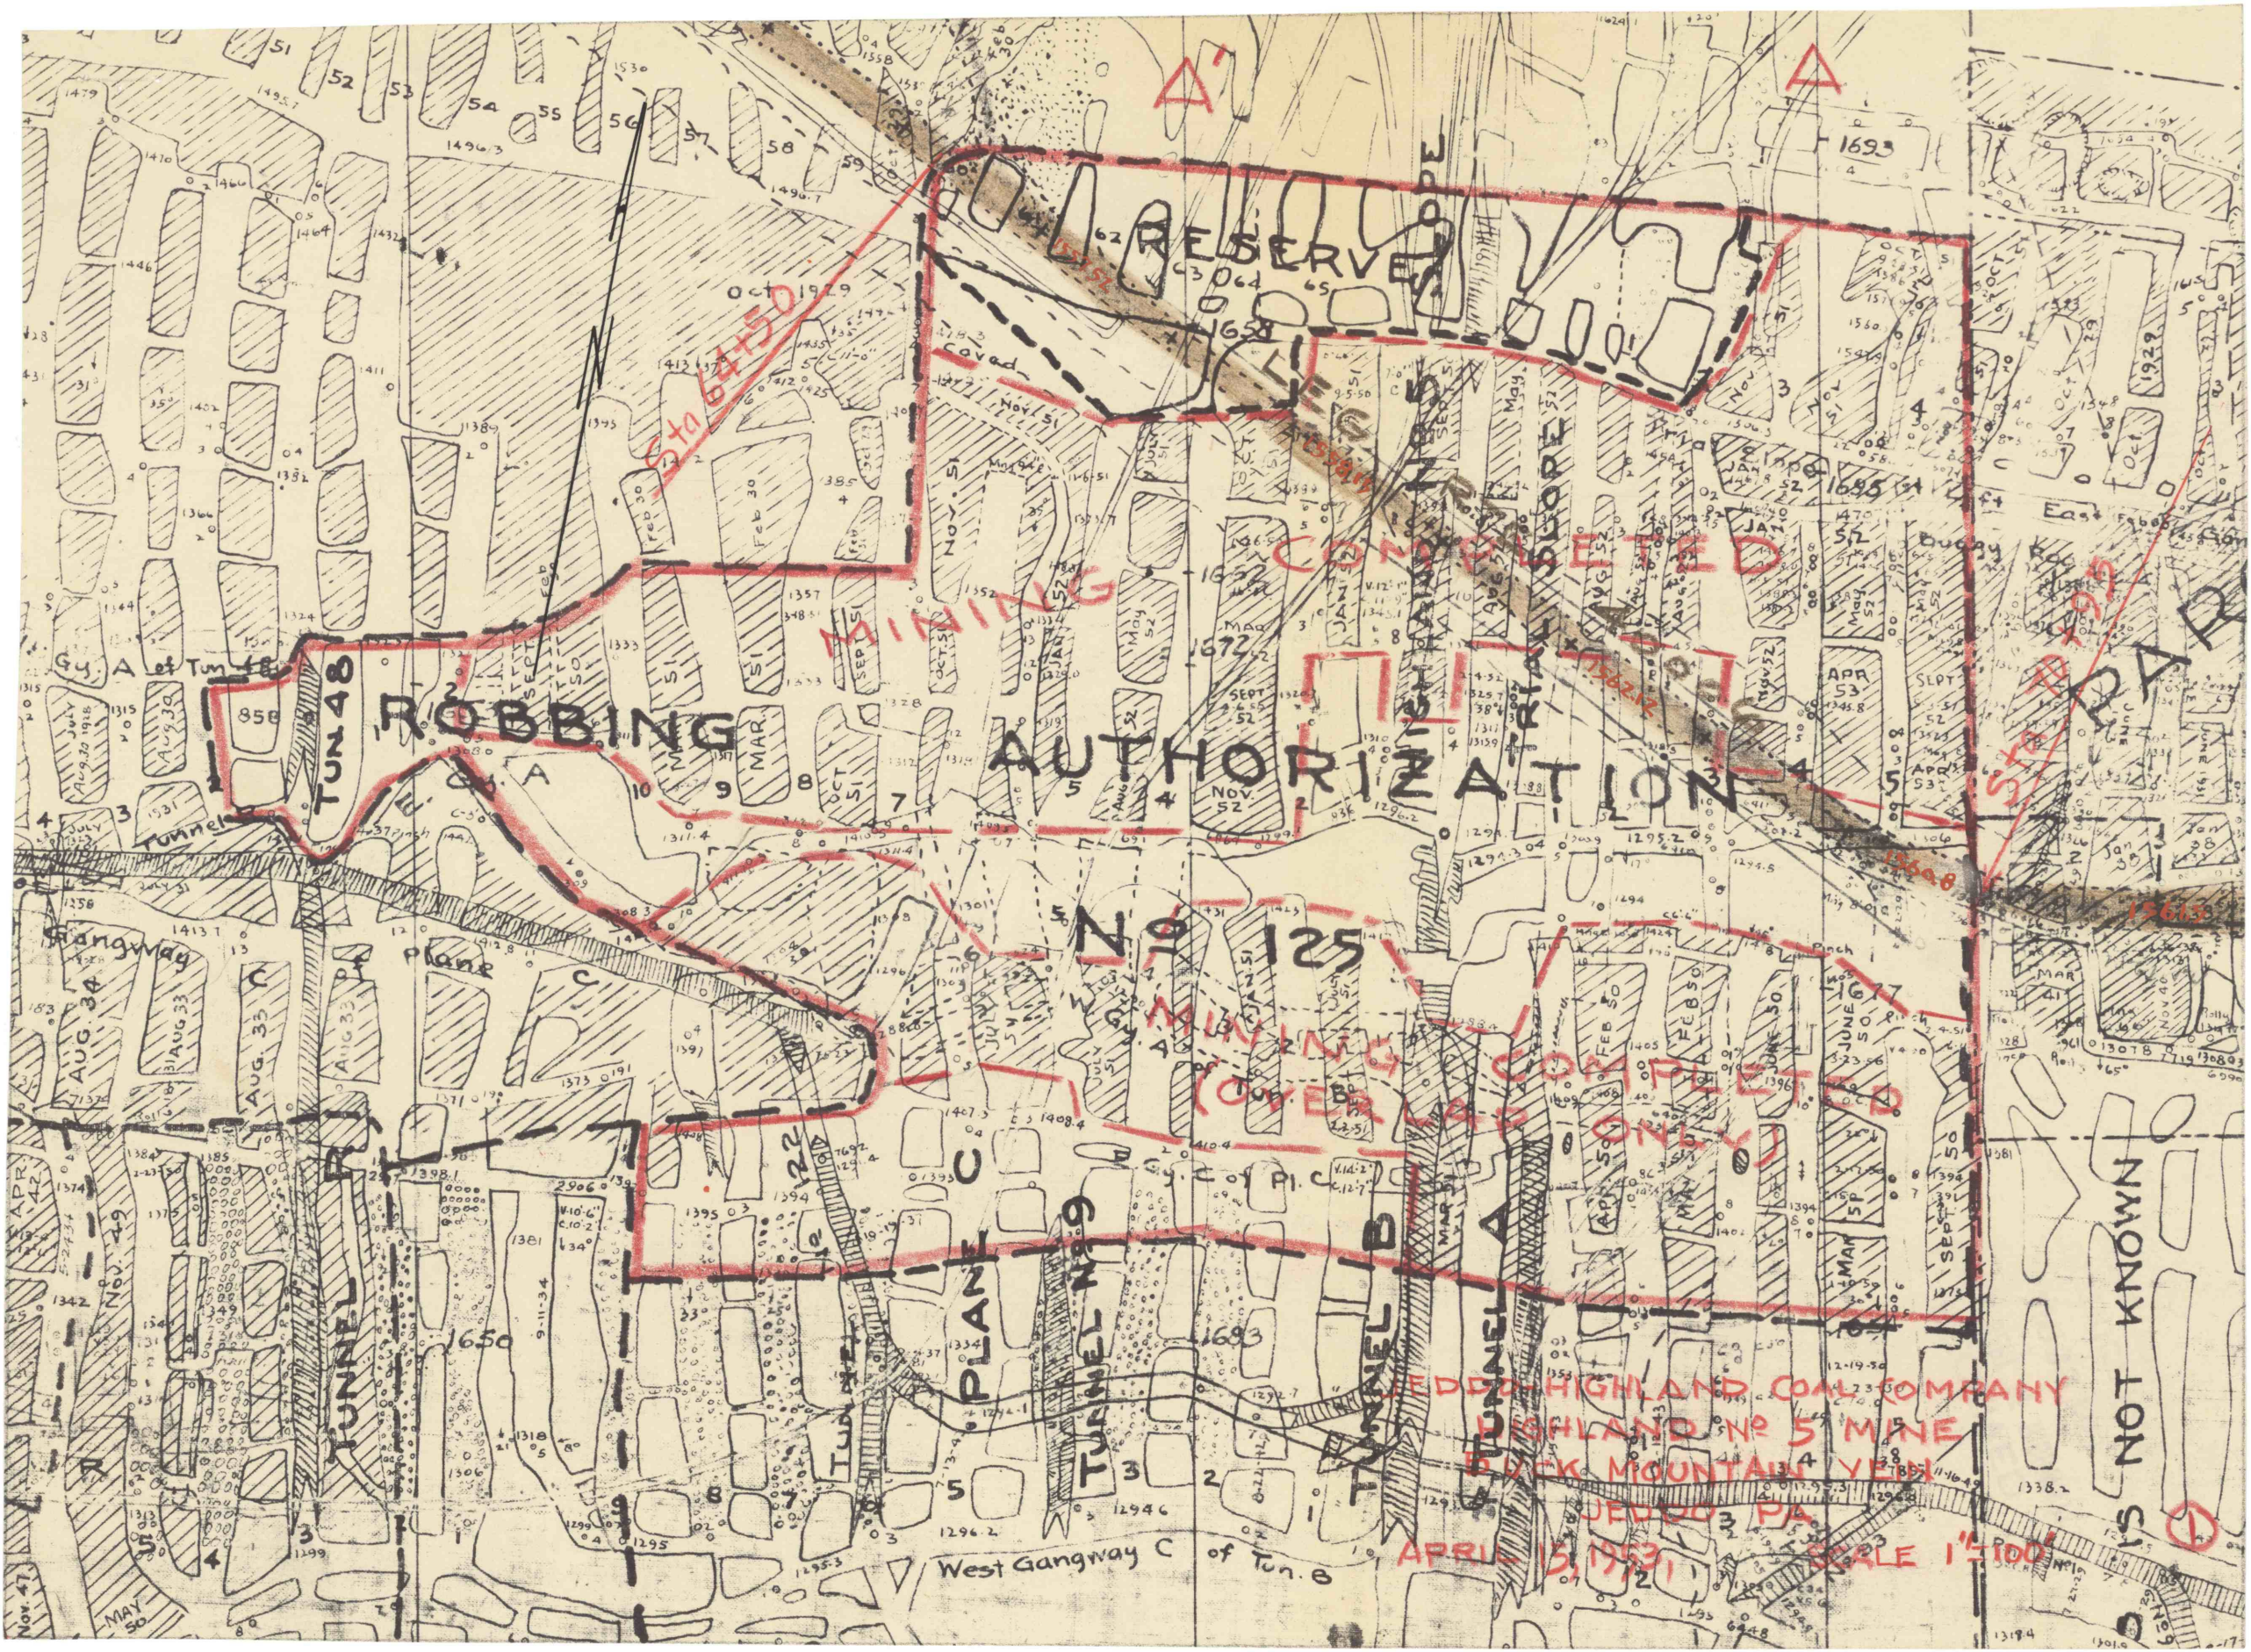

A'
A
RESERVE
Sta 64+50
MINING COMPLETED
ROBBING
AUTHORIZATION
No 125
MINING COMPLETED
(OVERLAP ONLY)
TUN 48
Gangway C of Plane C
TUNNEL R
PLANE C
TUNNEL No 9
TUNNEL B
TUNNEL A
West Gangway C of Tun. B
NOT KNOWN
LEDDO-HIGHLAND COAL COMPANY
HIGHLAND No 5 MINE
BUCK MOUNTAIN VEIN
LEDDO, PA.
APRIL 15, 1953
SCALE 1"=100'