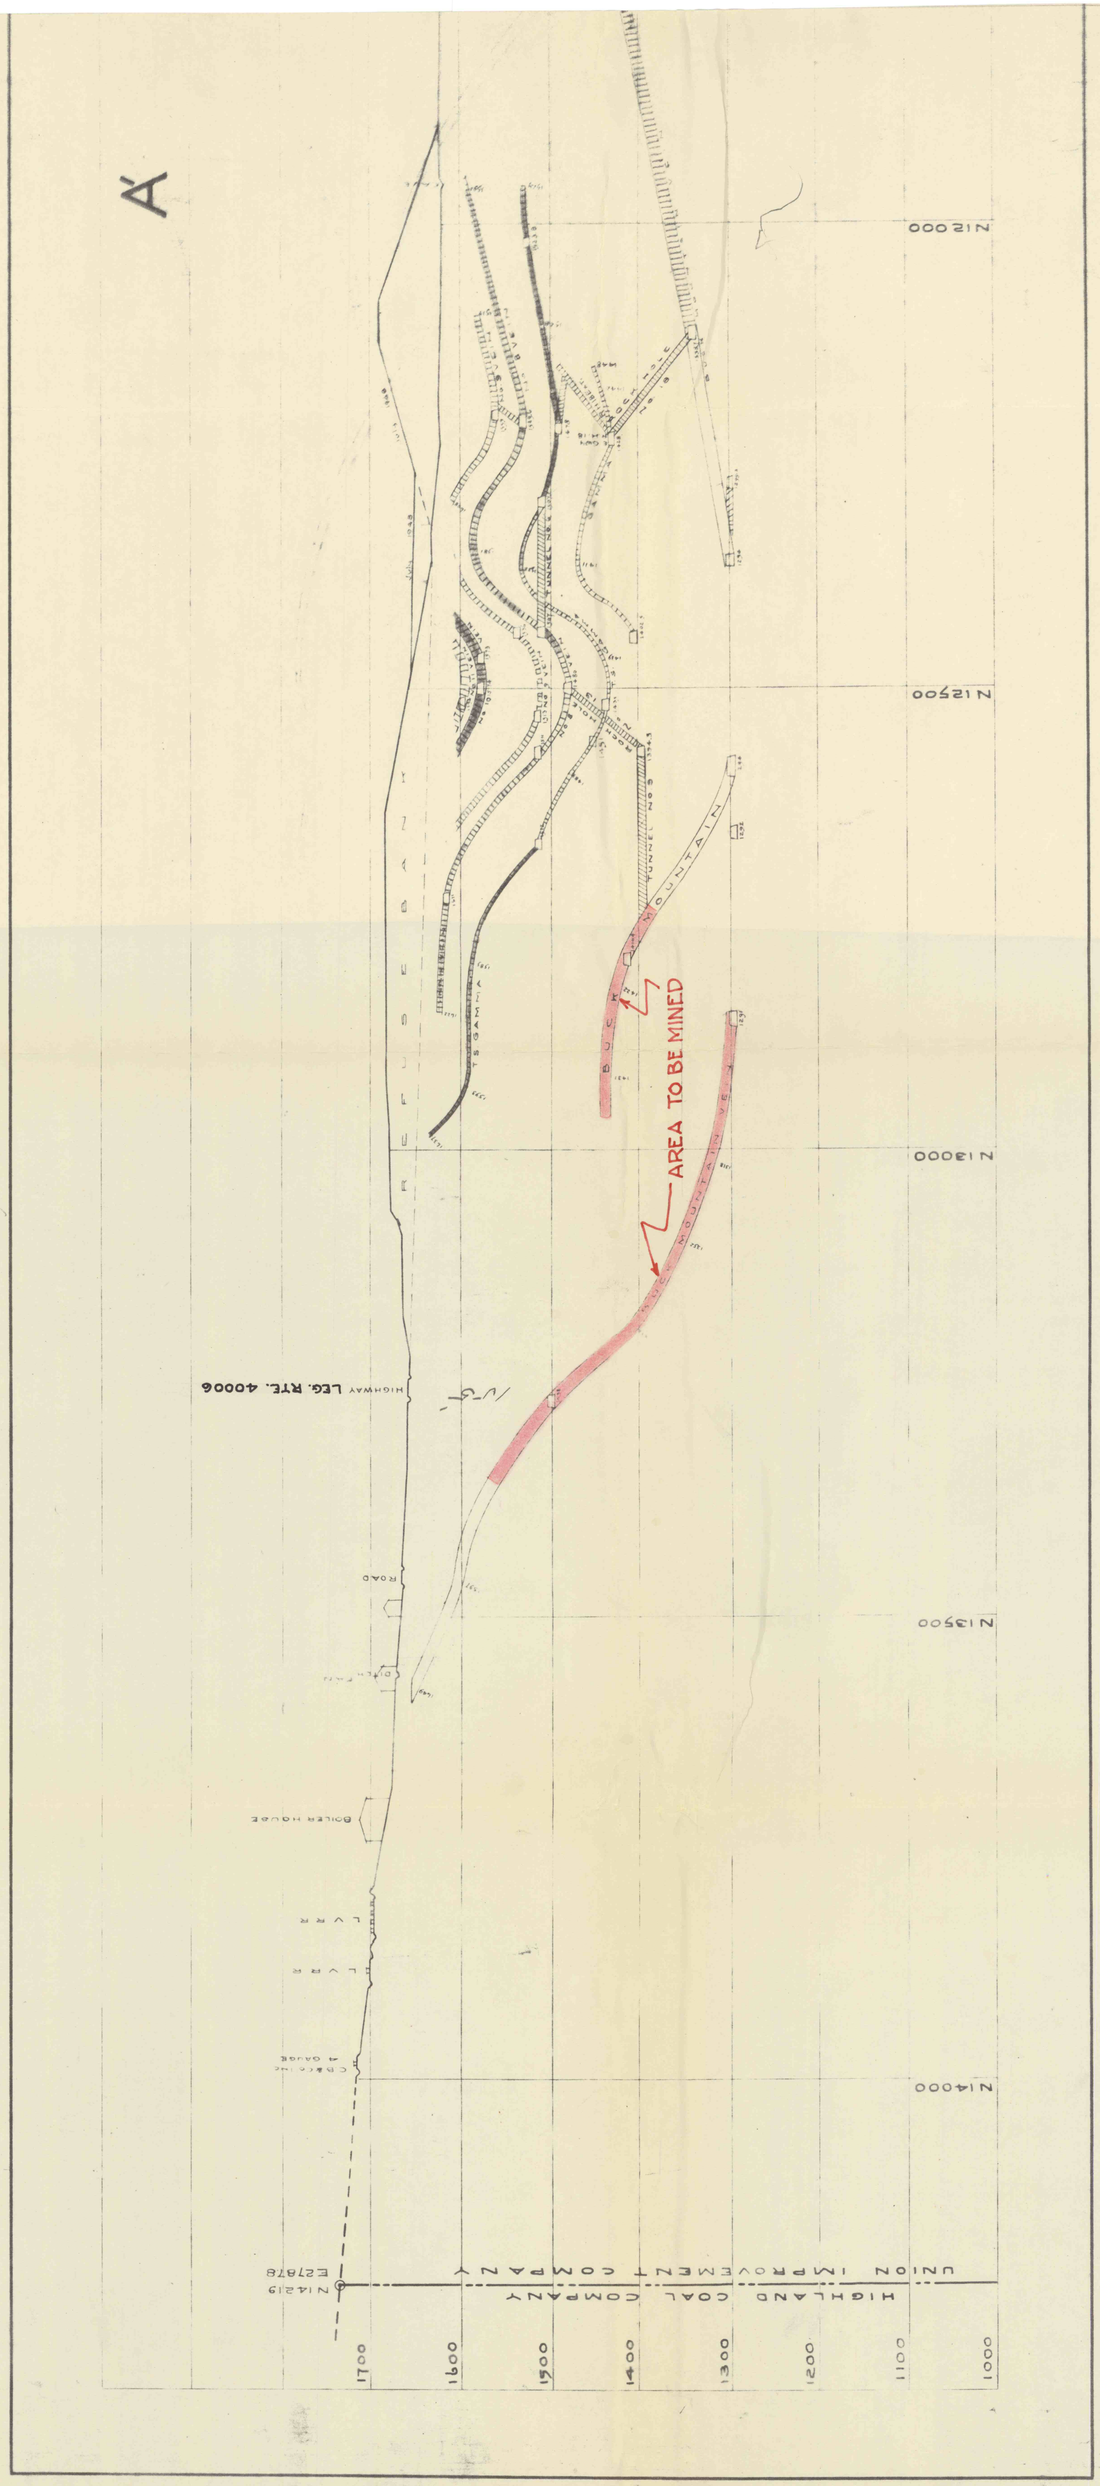
A'
N 12000
N 12500
N 13000
N 13500
N 14000
AREA TO BE MINED
BUCK MOUNTAIN
REFUSE BANK
SAMPLING
HIGHWAY LEG. RTE. 40006
ROAD
BOILER HOUSE
4 GAUGE
HIGHLAND COAL COMPANY
UNION IMPROVEMENT COMPANY
1700
1600
1500
1400
1300
1200
1100
1000