


JEDDO-HIGHLAND COAL CO.
MINING DEPARTMENT
JEDDO, PA.
ECKLEY COLLIERY
PRINT SHOWING MINING AREA
IN VICINITY OF LEG ROUTE 40006
SCALE 1"=100' DATE MAR. 27, 1941.

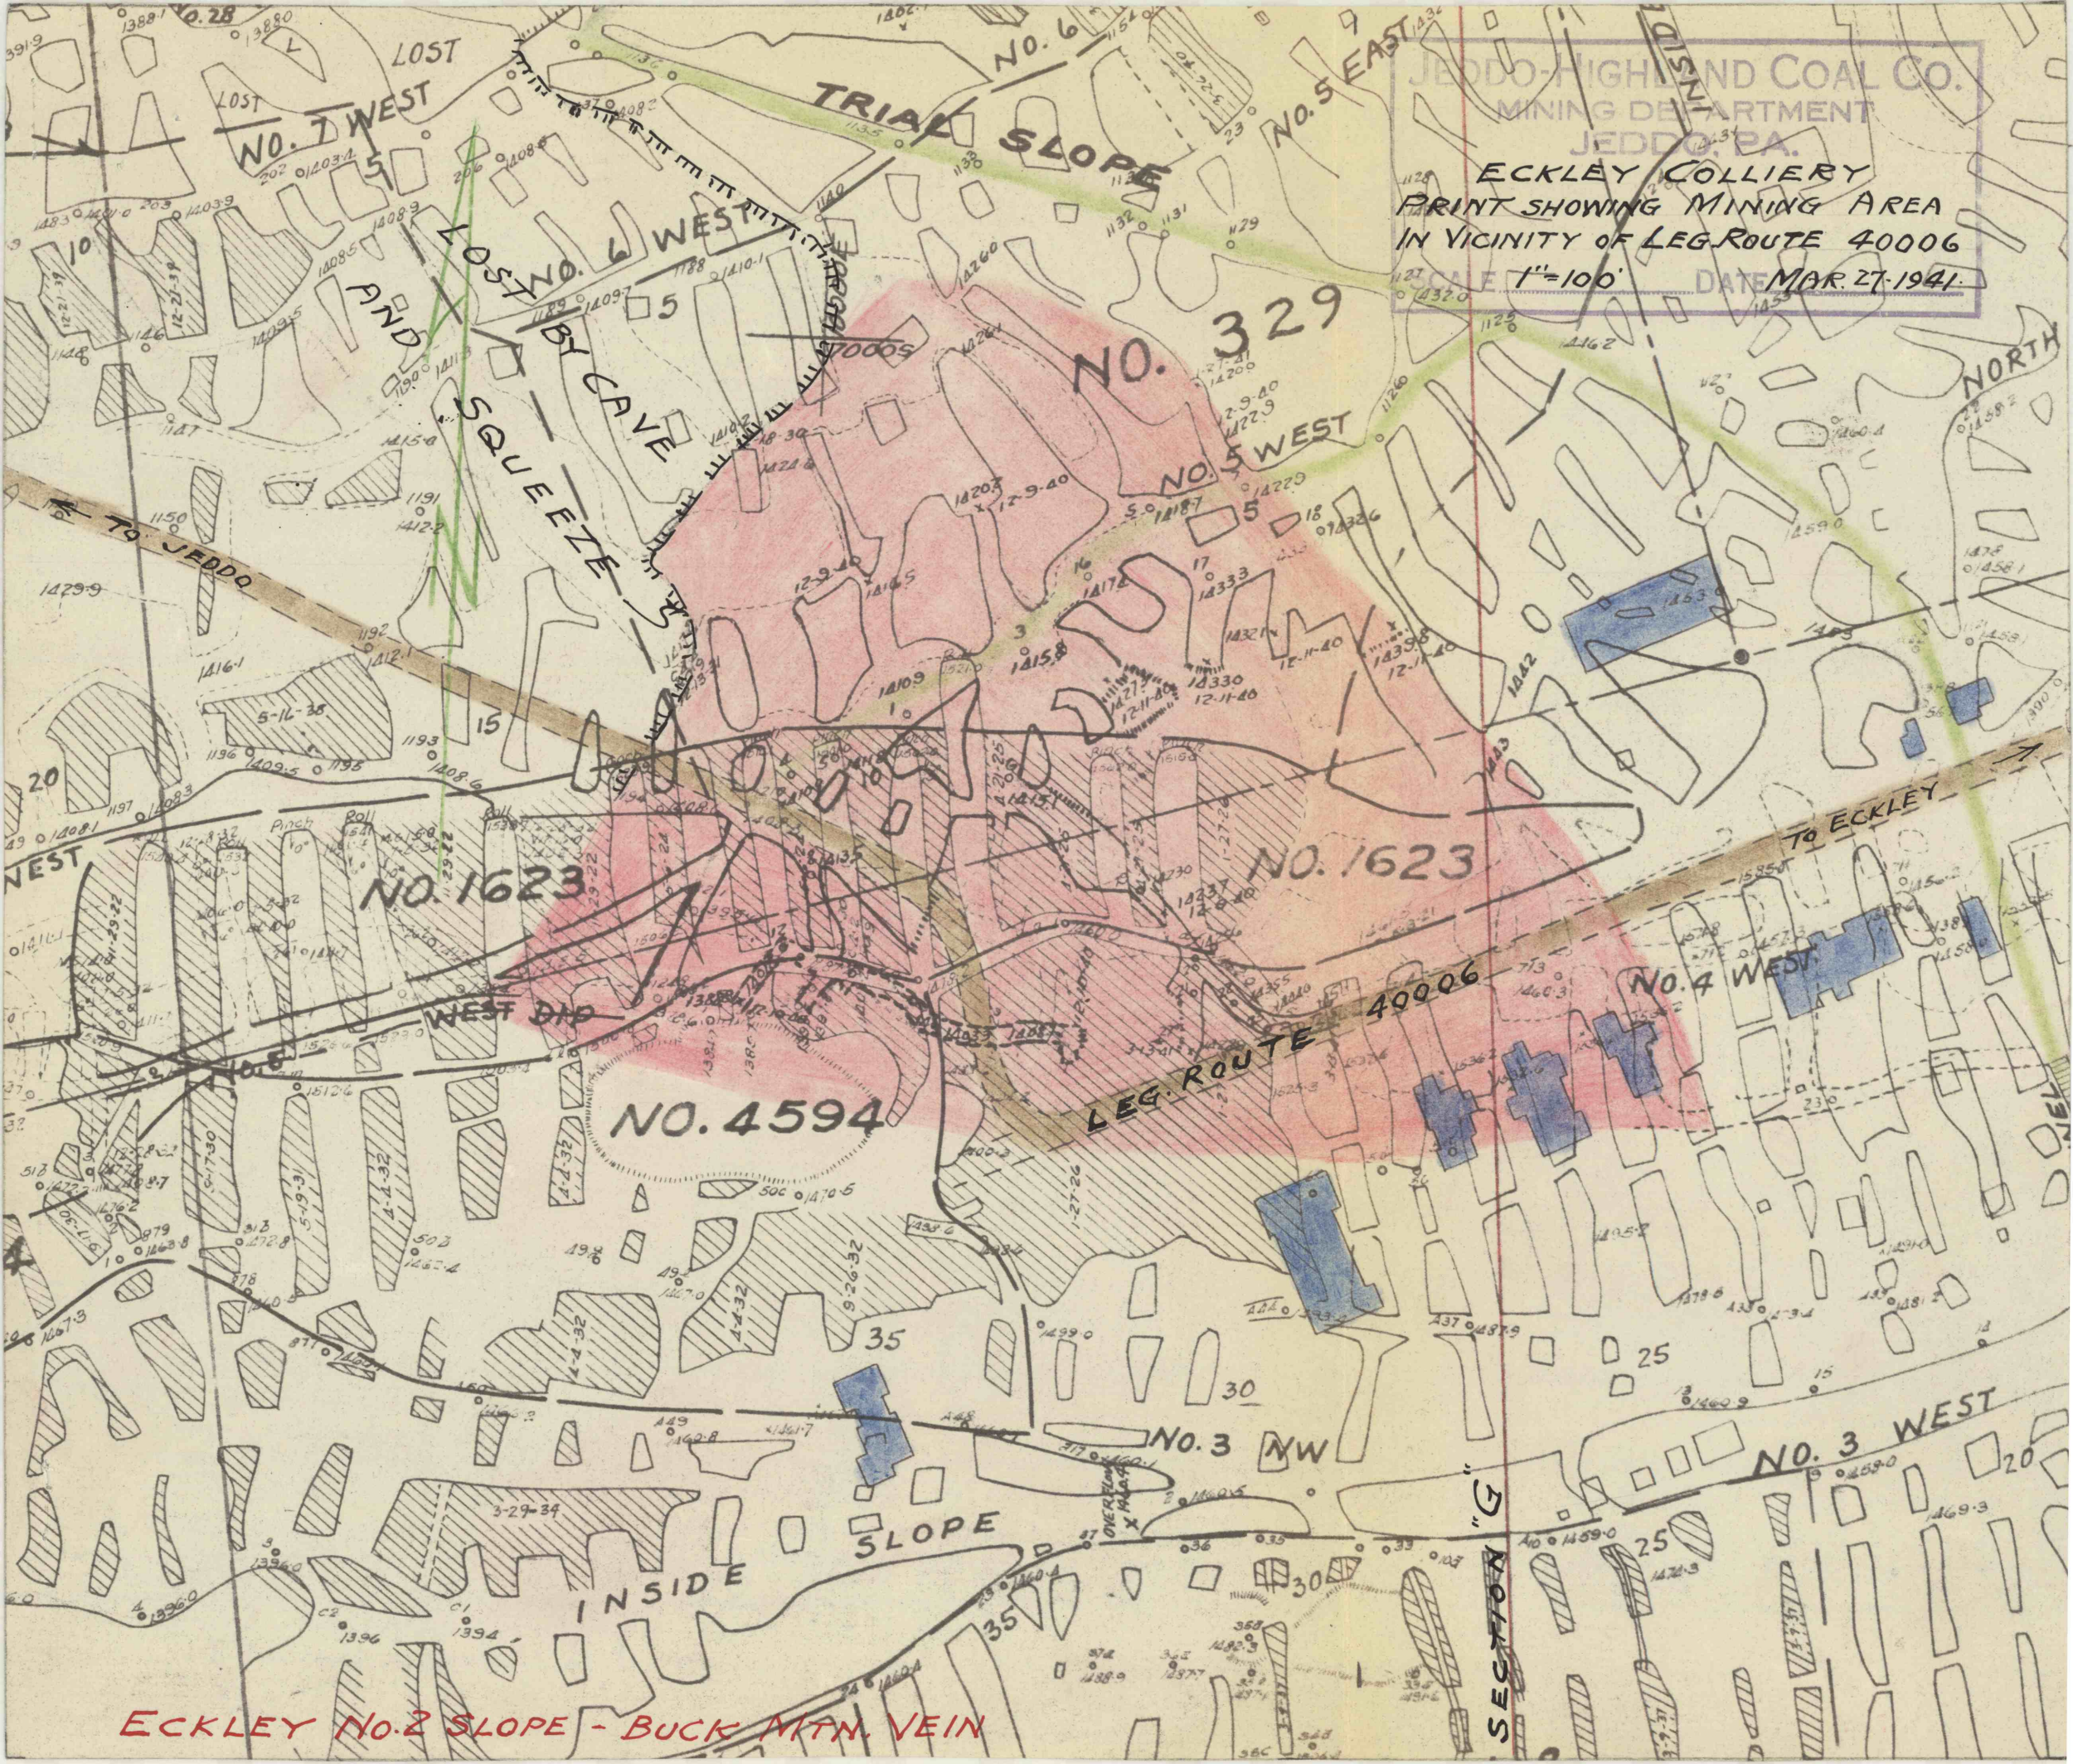

ECKLEY NO. 2 SLOPE - BUCK MTN. VEIN