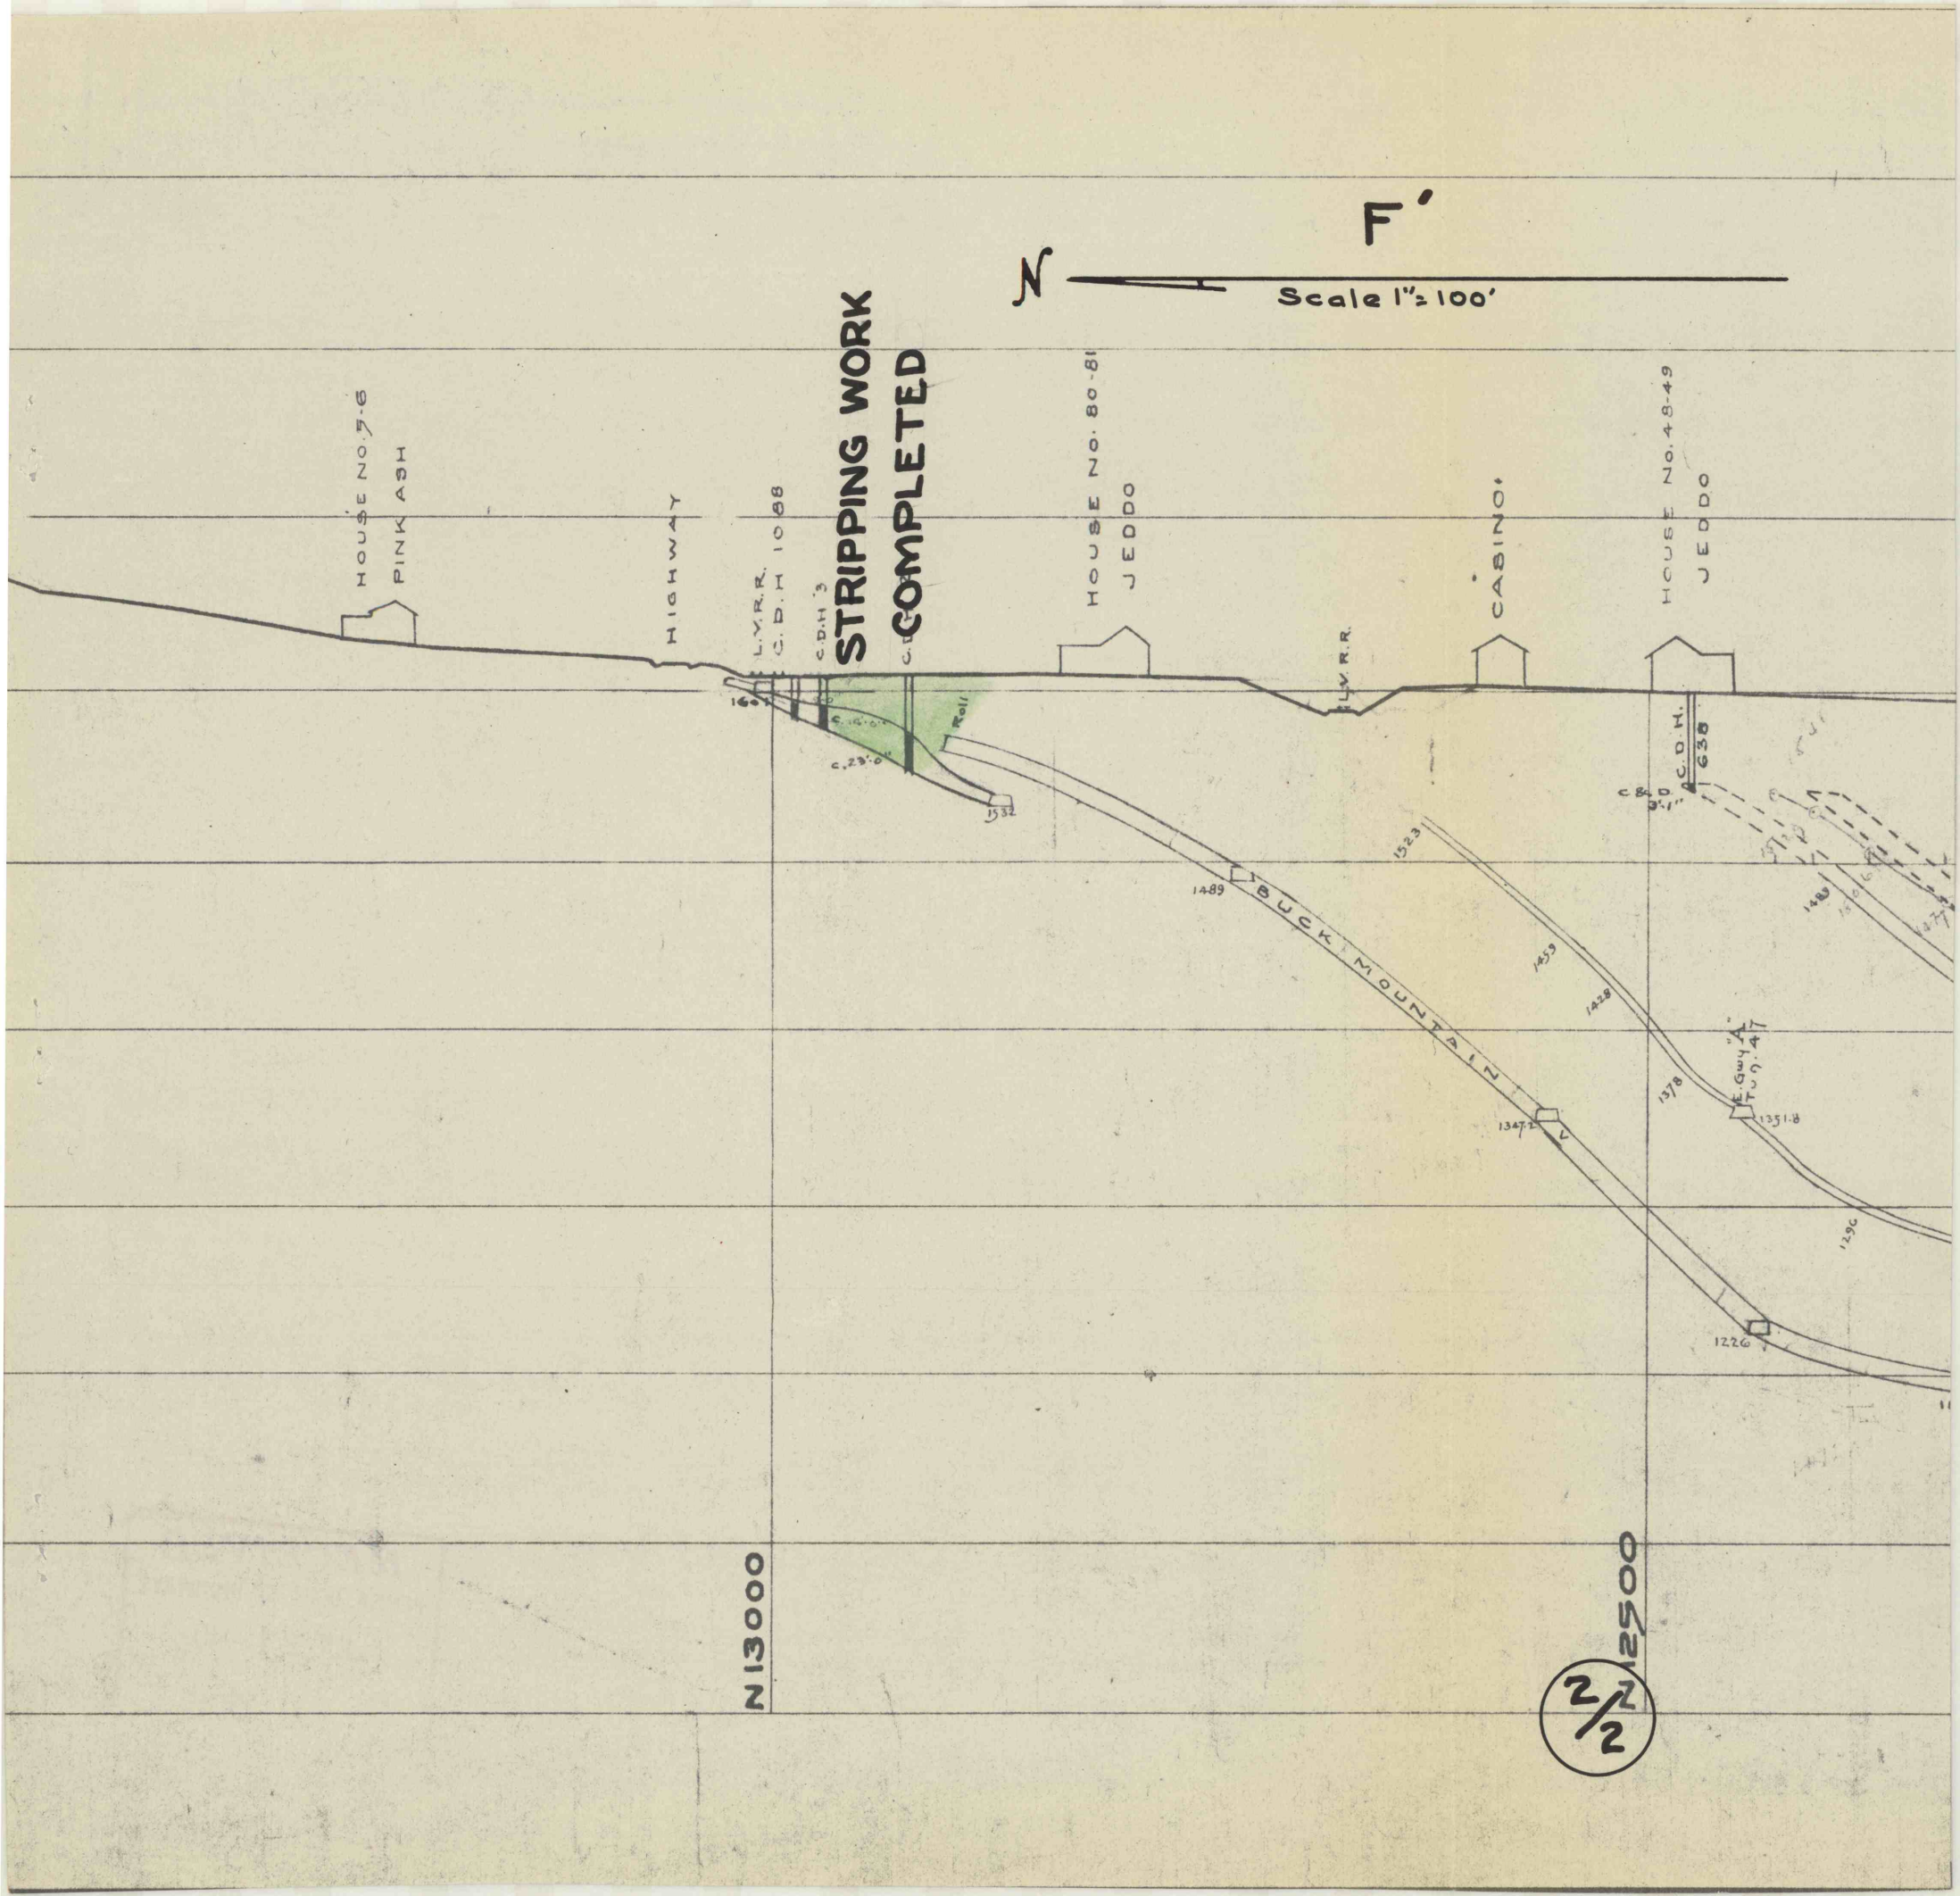
F'
N
Scale 1" = 100'
STRIPPING WORK COMPLETED
HOUSE NO. 5-6
PINK ASH
HIGHWAY
L.V.R.R.
C.D.H. 1088
C.D.H. 3
HOUSE NO. 80-81
JEDDO
L.V.R.R.
CASINO
HOUSE NO. 48-49
JEDDO
C.D.H. 638
Roll
1532
1489
BUCK MOUNTAIN
1523
1459
1428
1378
1347.2
1351.8
1226
N13000
N12500
2/2