


JEDDO-HIGHLAND COAL CO.
 MINING DEPARTMENT
 JEDDO, PA.
 ECKLEY COLLIERY No. 11 SLOPE
 Print showing Mining Area
 under Leg. Route 40006
 SCALE 1"=100' DATE April 14, 1941

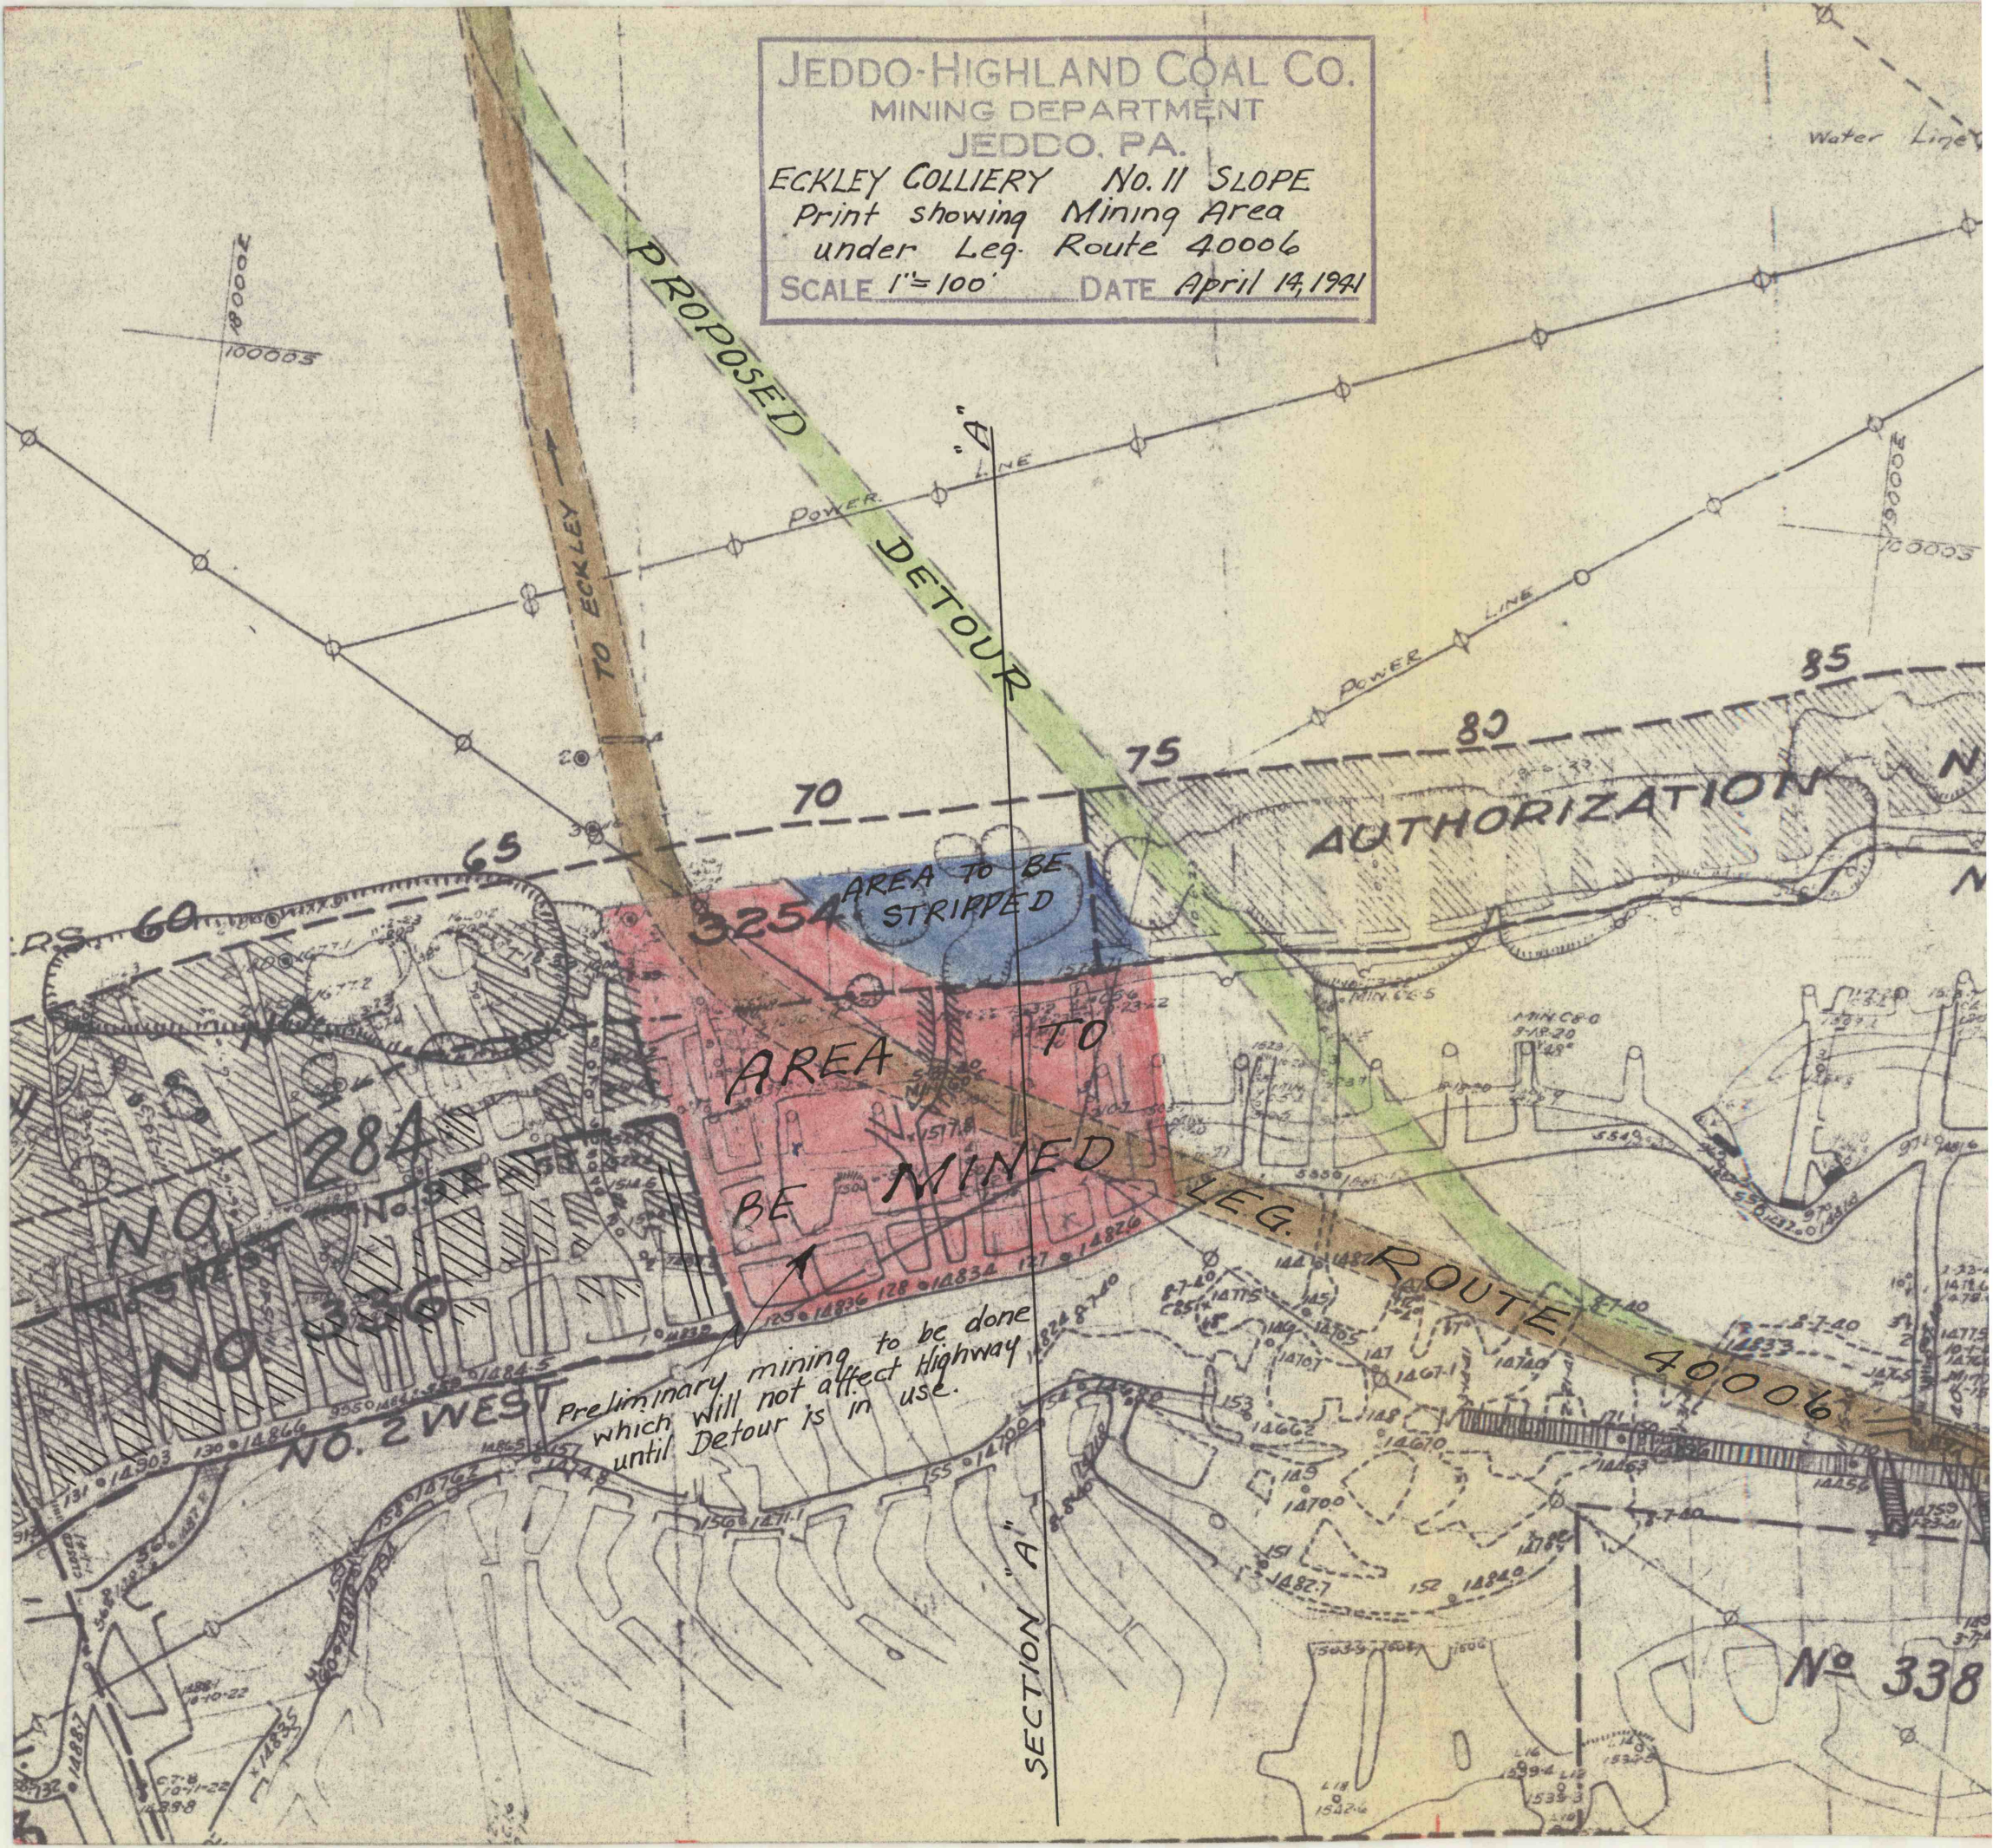

Preliminary mining to be done
 which will not affect highway
 until Detour is in use.

PROPOSED
 DETOUR

AUTHORIZATION

AREA
 TO
 BE MINED

AREA TO BE
 STRIPPED

SECTION "A"

LEG. ROUTE 40006

NO. 2 WEST

No 338

Water Line

TO ECKLEY

POWER LINE

POWER LINE

70

75

80

85

100003

100003

DS 60

NO 284

NO 336

130 14866

130 14803

153 14762

14748

3254

5178

128 14834

127 14826











14707

14707

