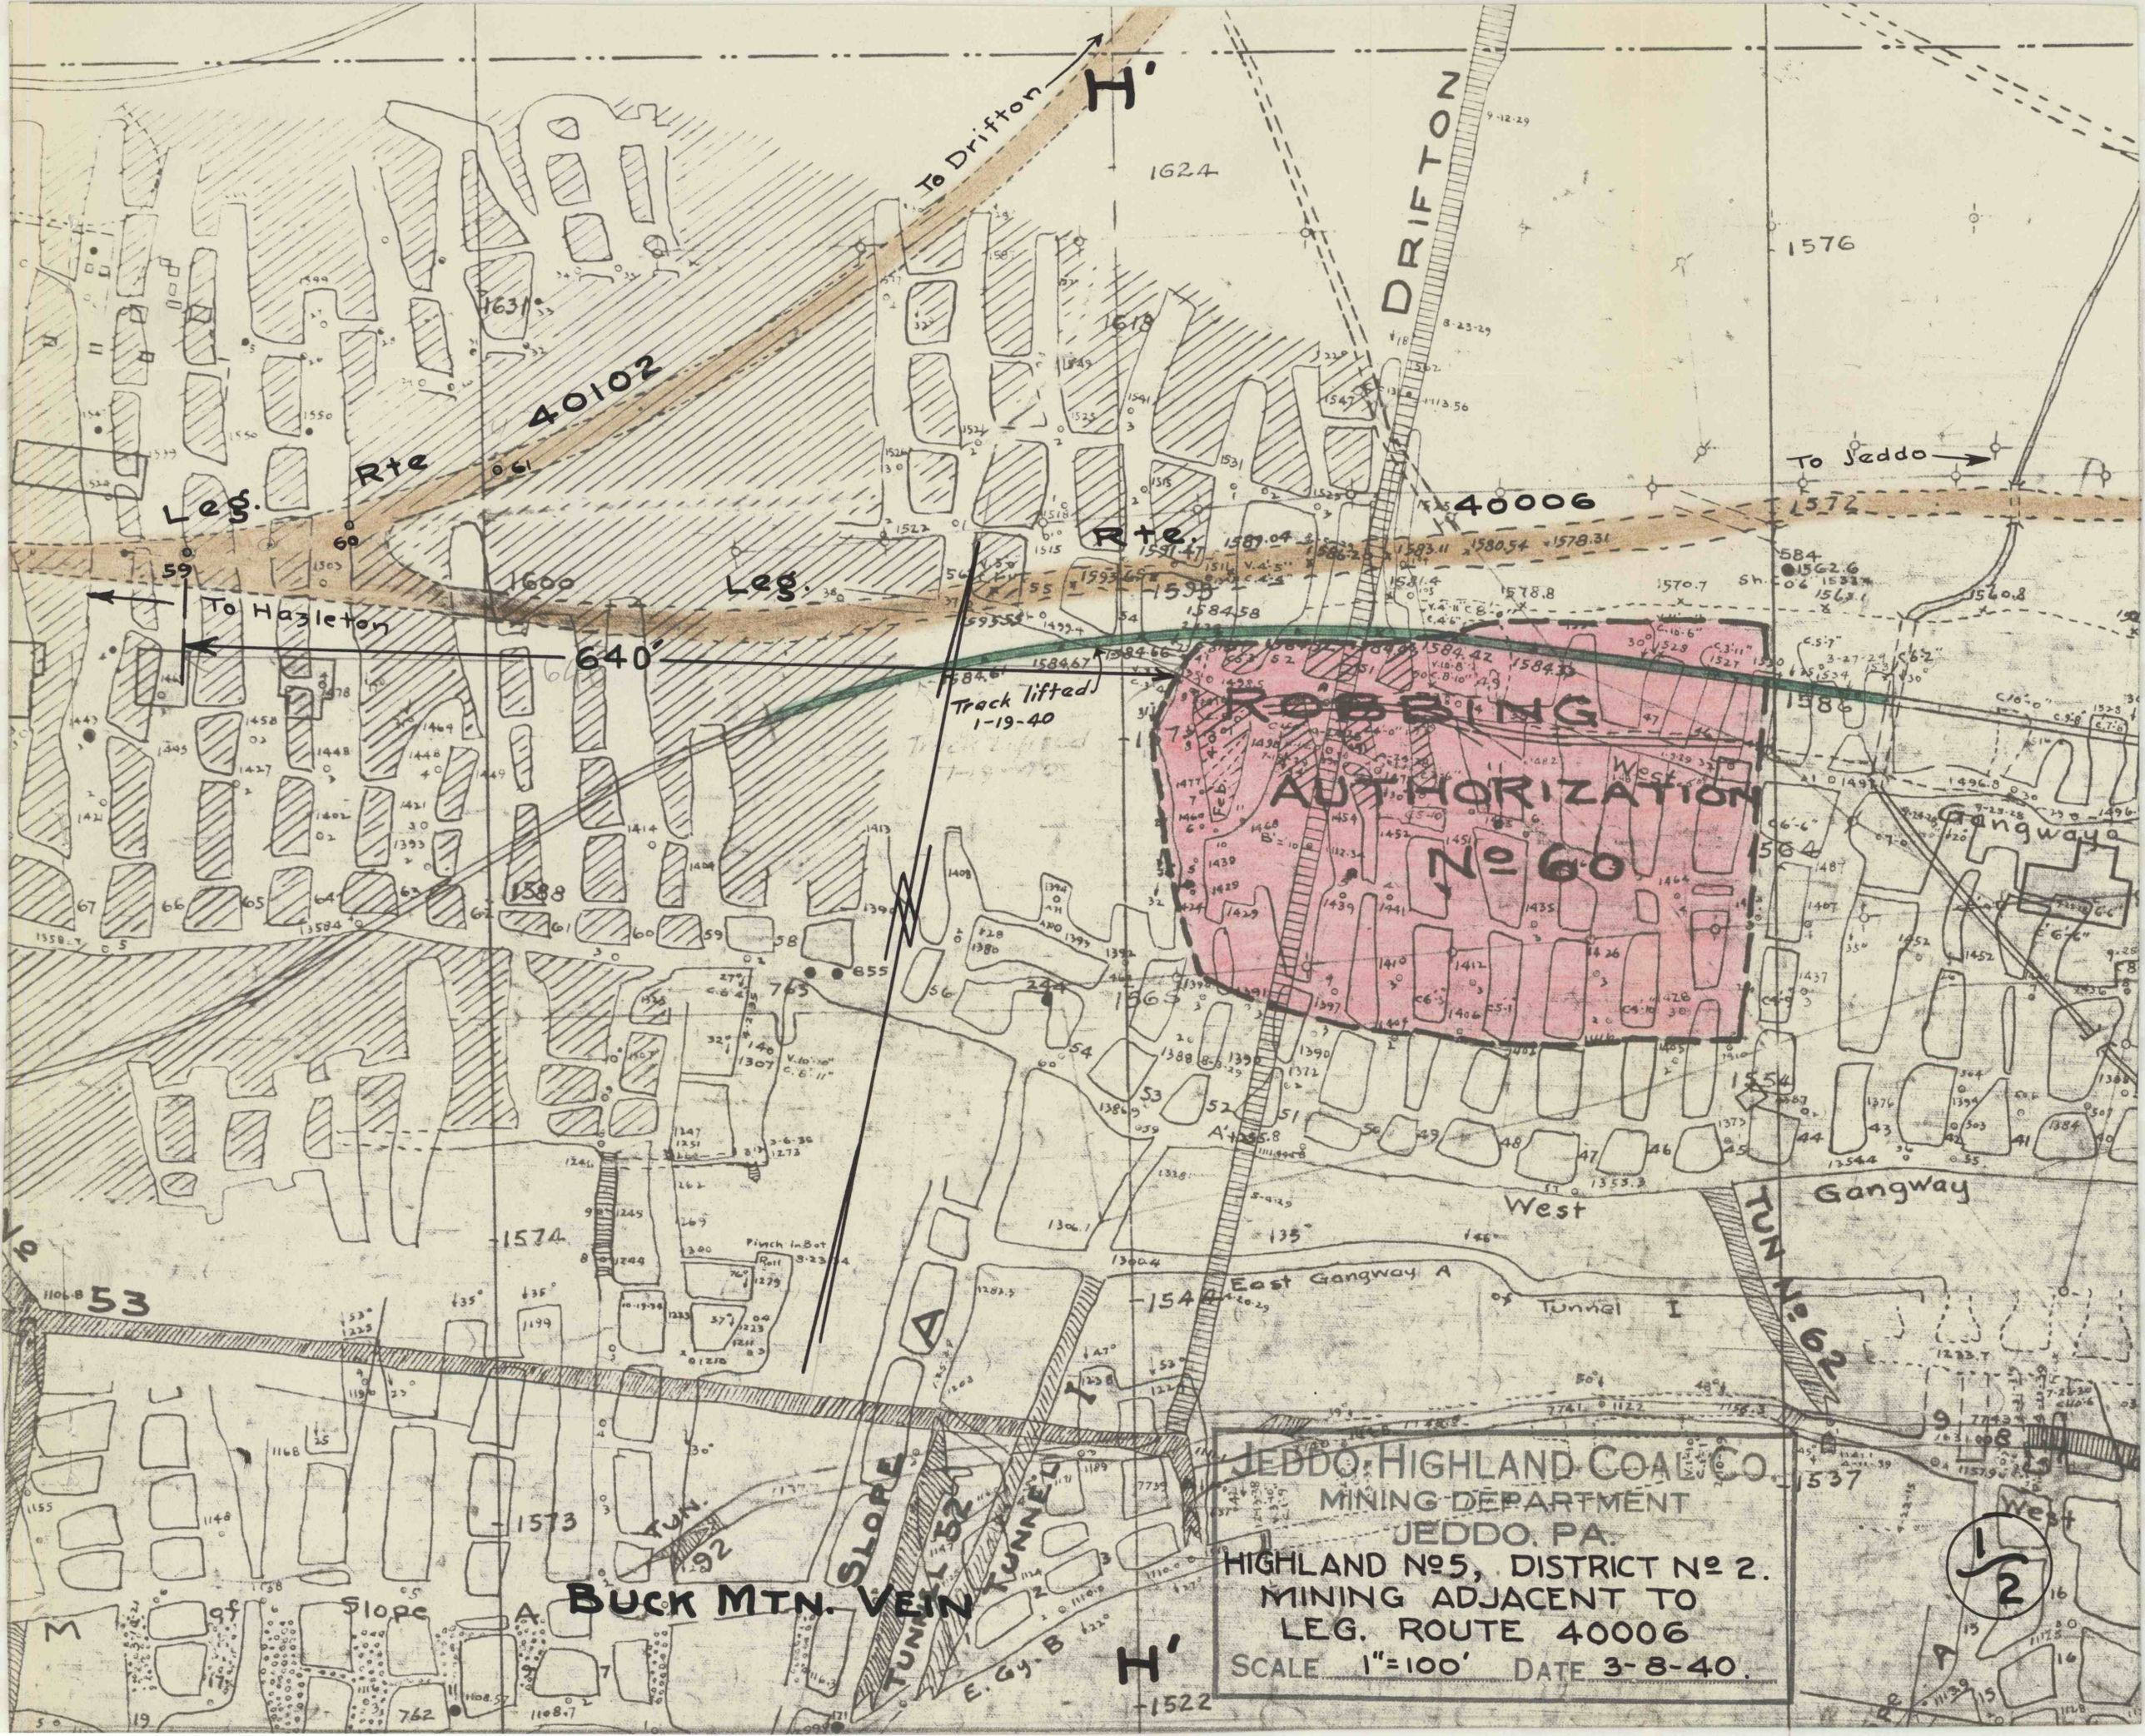

H'
To Drifton
DRIFTON
1624
1576
1631
1618
40102
Leg. Rte
To Jeddo
40006
1572
Leg. Rte.
To Hazleton
640'
Track lifted 1-19-40
ROBBING AUTHORIZATION No 60
West Gangway
Gangway
West
East Gangway A
Tunnel I
TUN No 62
Pinch in Bot Roll
53
1574
1573
1544
1537
1522
TUN. 92
SLOPE A
TUNNEL 52
TUNNEL I
E. Gy. B
BUCK MTN. VEIN
Slope A
JEDDO HIGHLAND COAL CO.
MINING DEPARTMENT
JEDDO, PA.
HIGHLAND No 5, DISTRICT No 2.
MINING ADJACENT TO
LEG. ROUTE 40006
SCALE 1"=100' DATE 3-8-40.
1/2