


N
Scale 1" = 100'

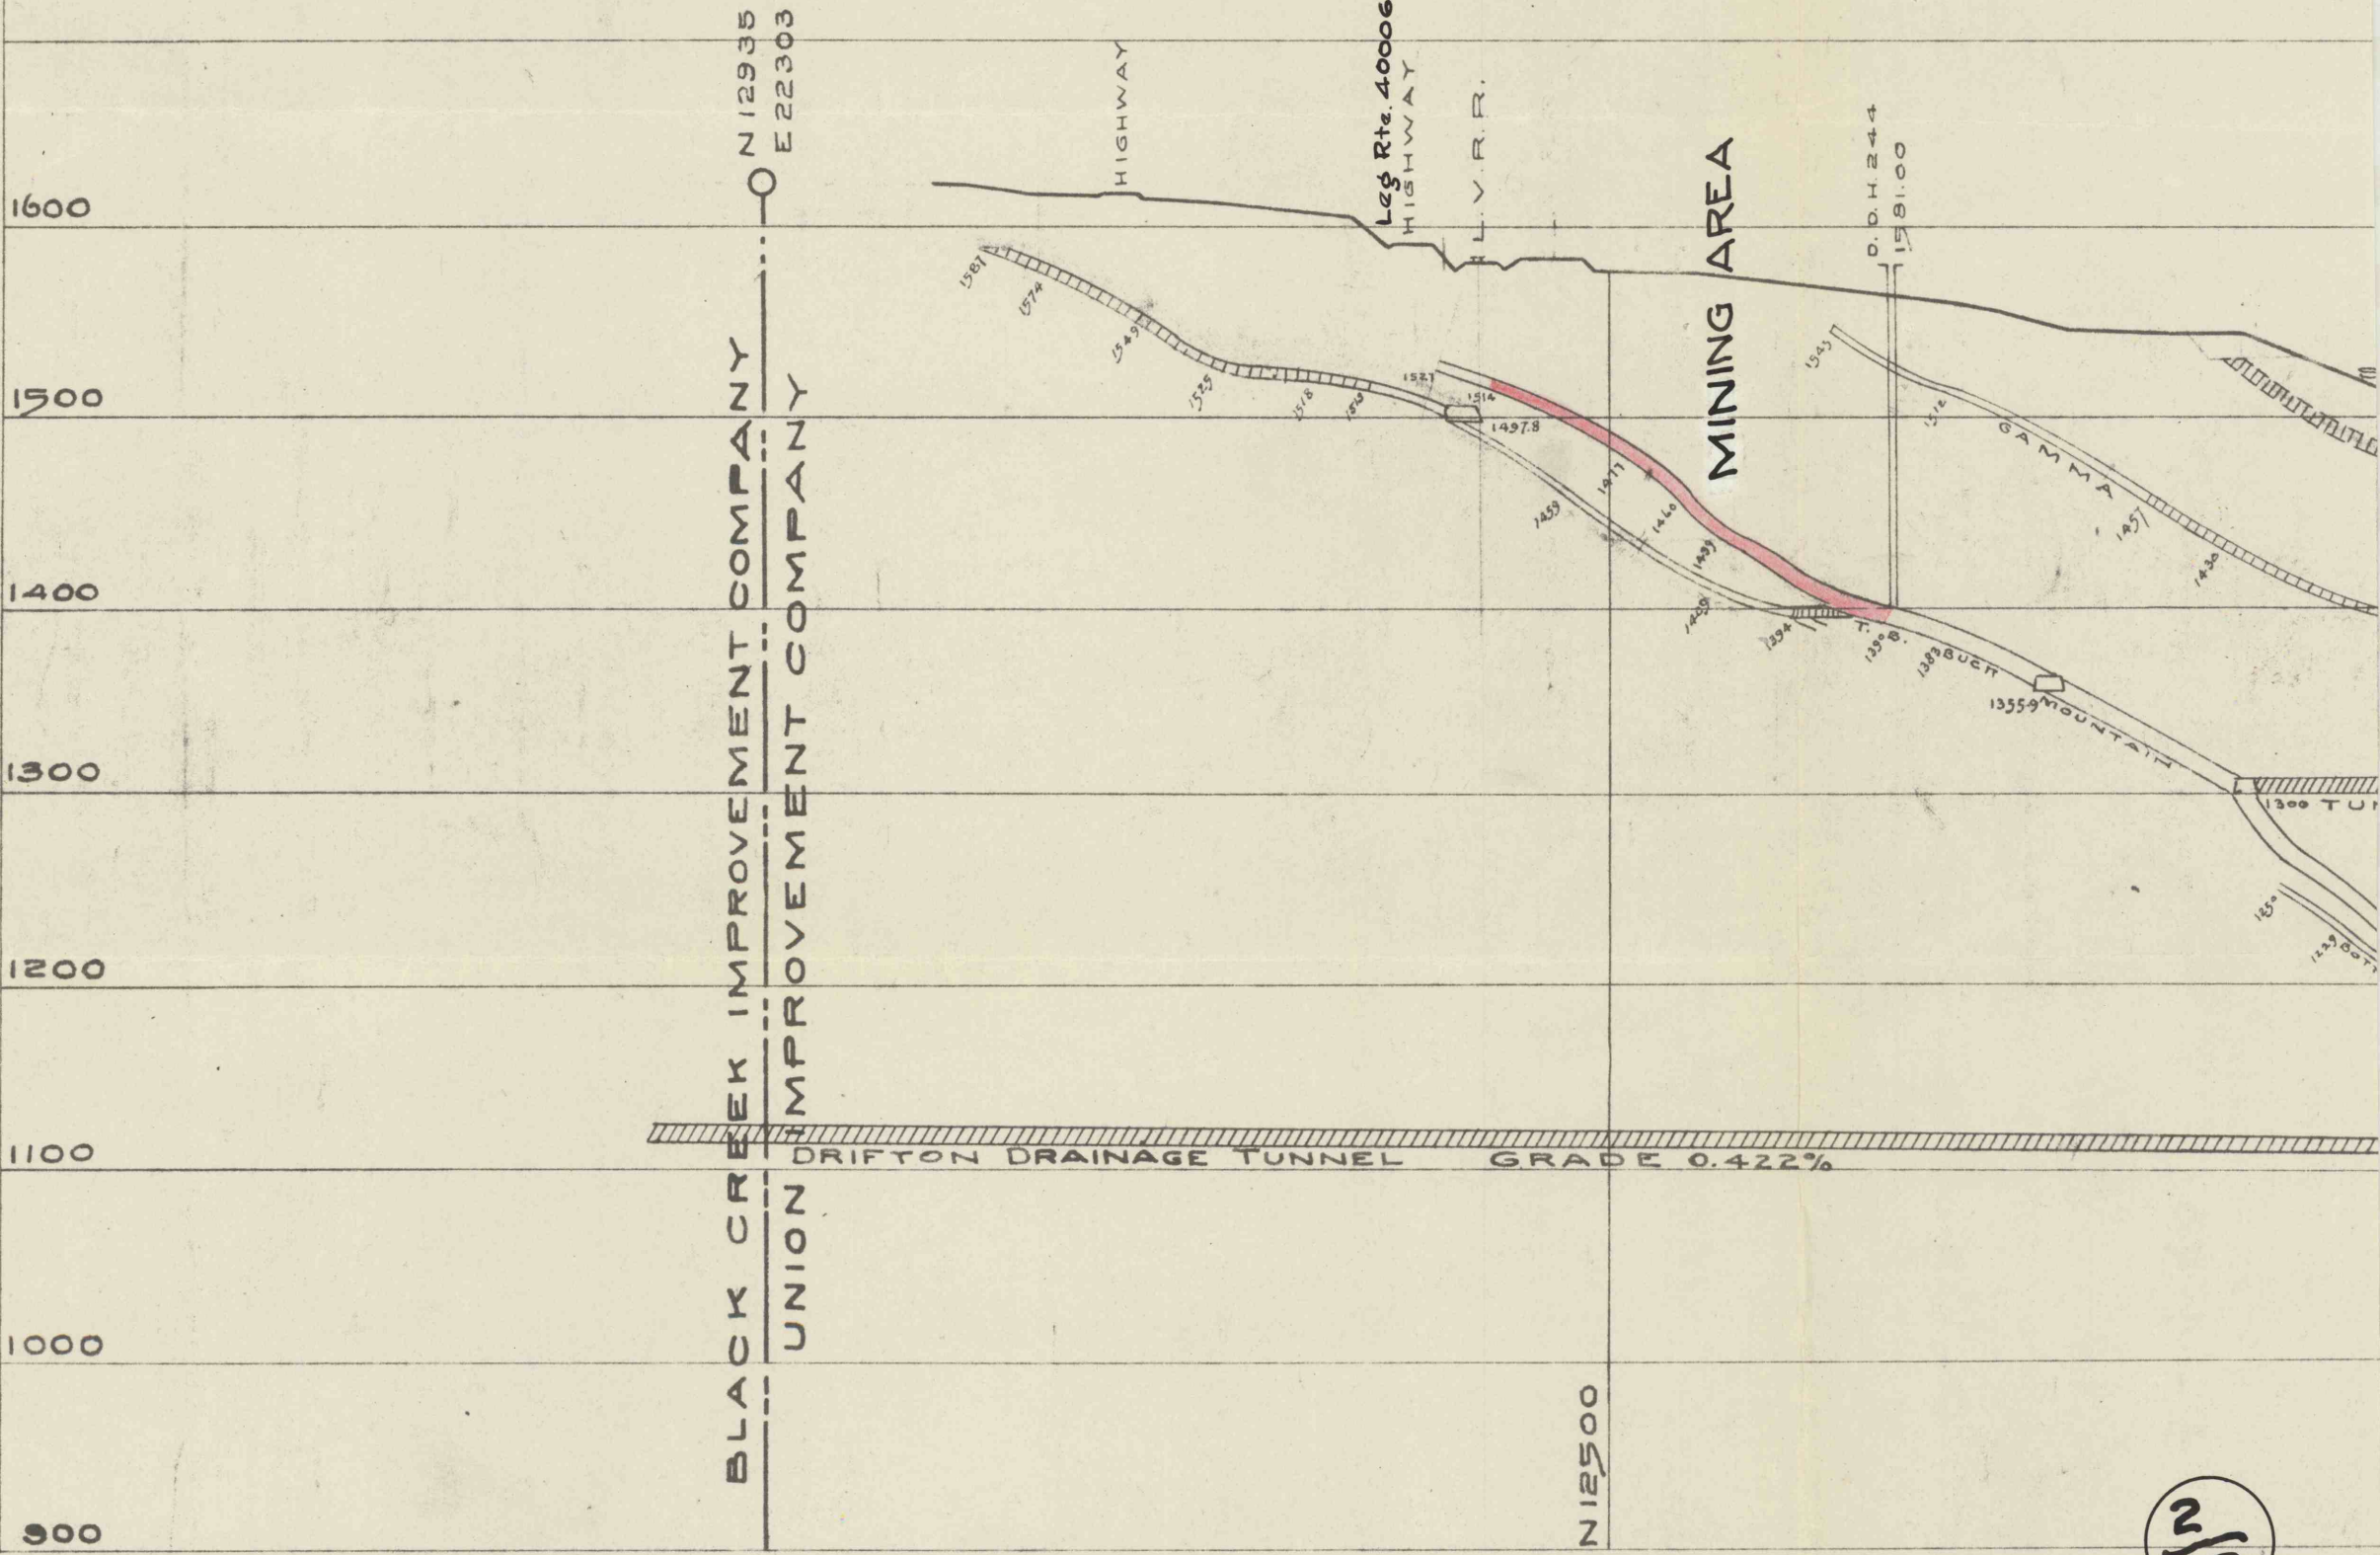

2/2