

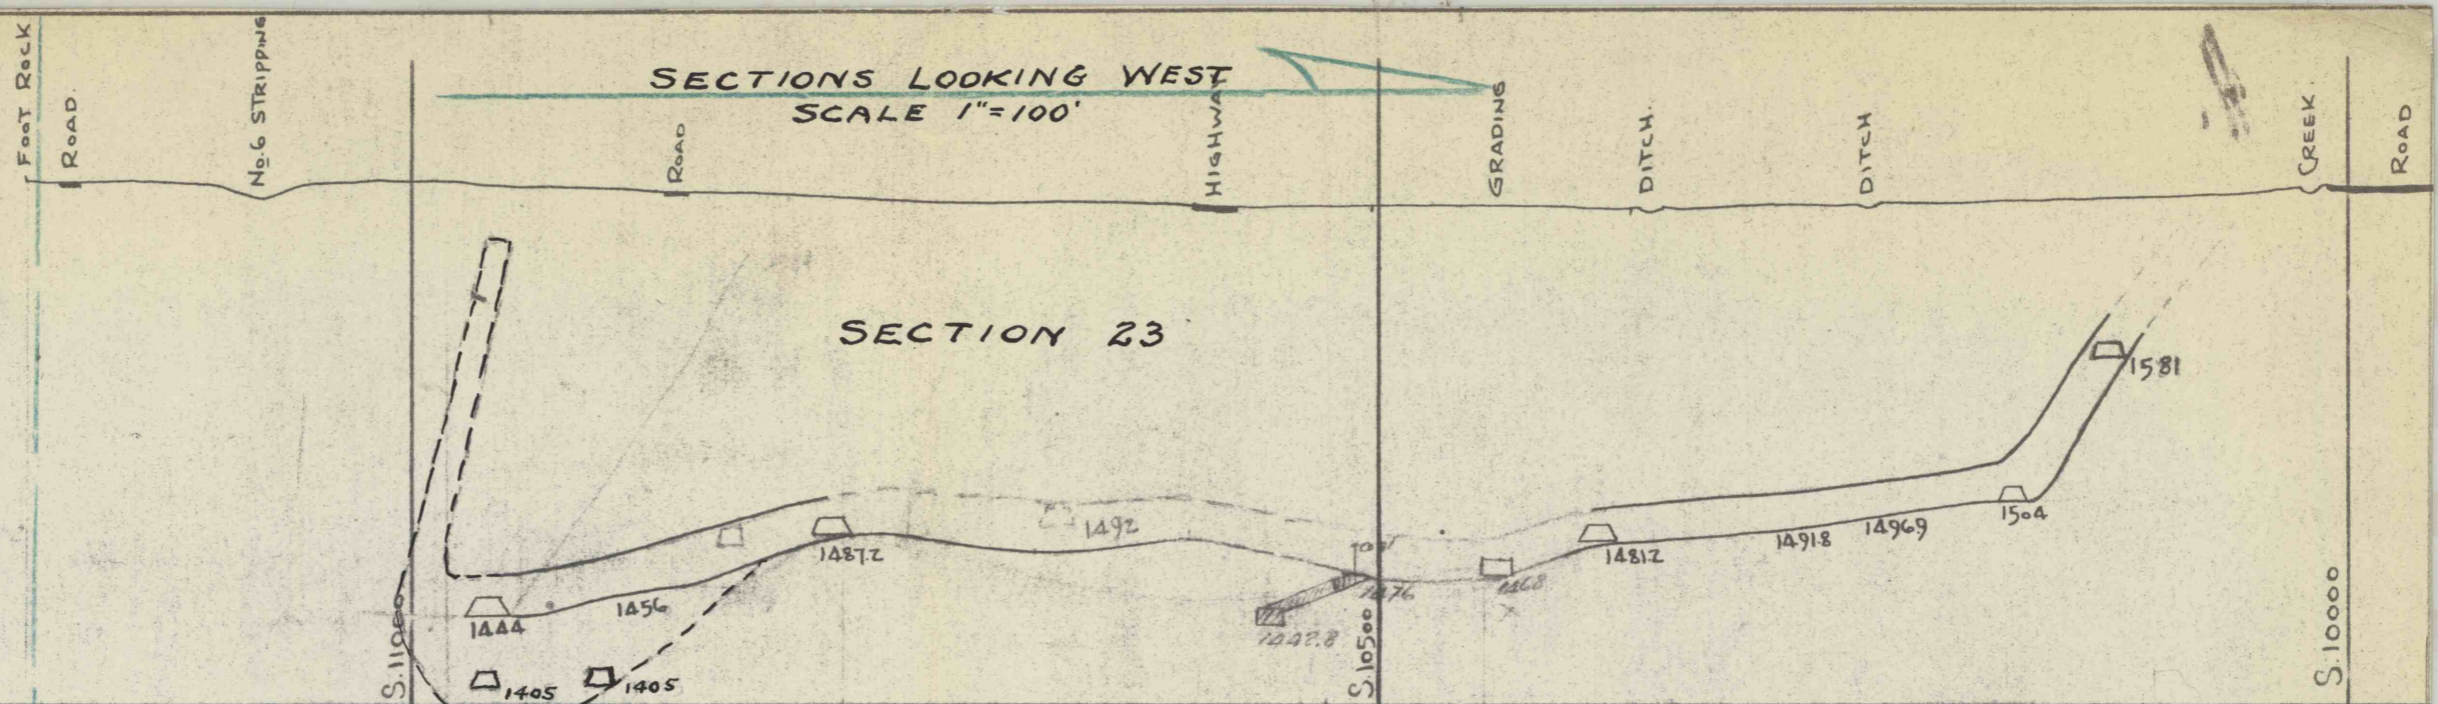
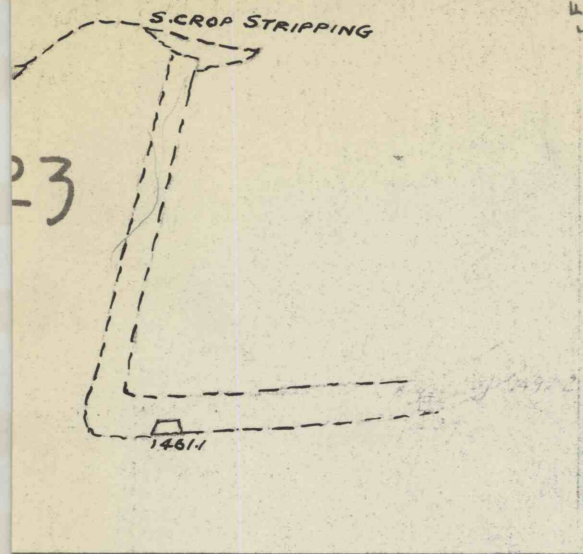


SECTION 23 1/2
180 FT. WEST OF 23

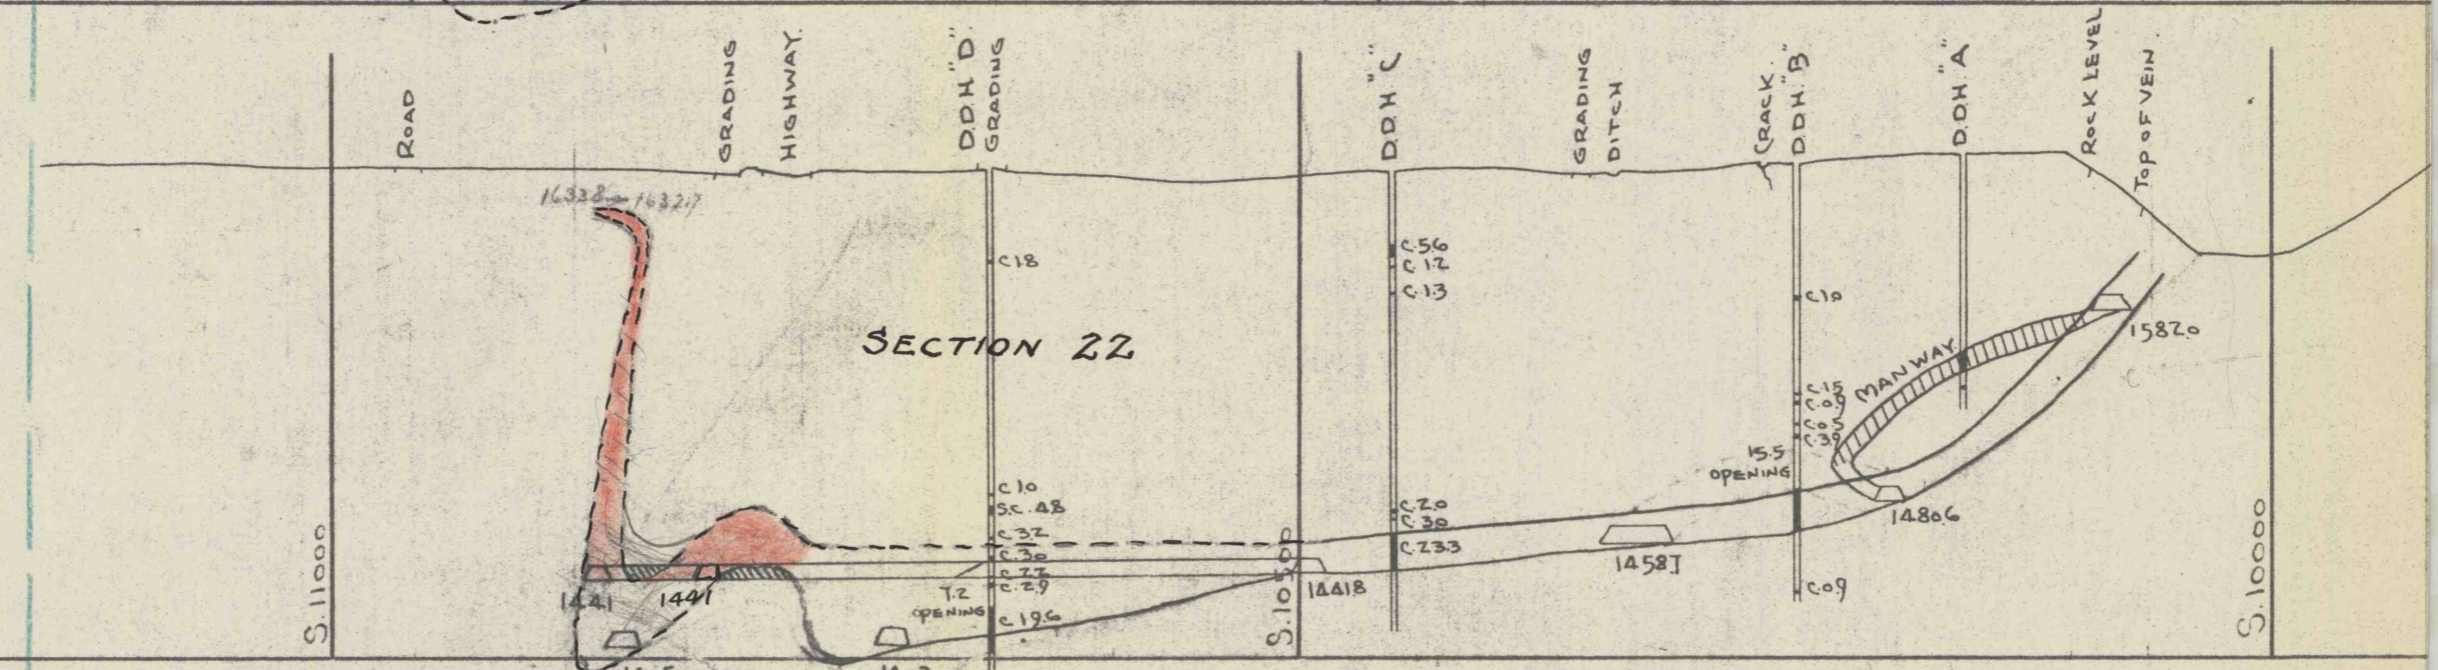

SECTION 22 1/2
170 FT. WEST OF 22

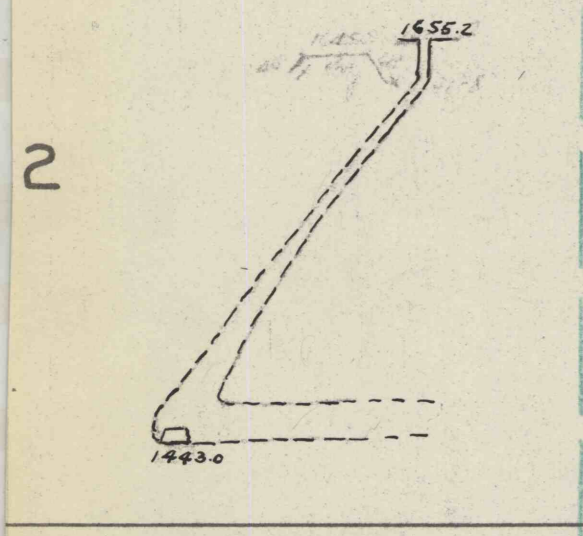

SECTION 21 1/2
280 FT. WEST OF 21

