


RECEIVED
PENNA. DEPT. OF HIGHWAYS
DISTRICT NO. 4
FEB 27 1954
SCRANTON, PA.

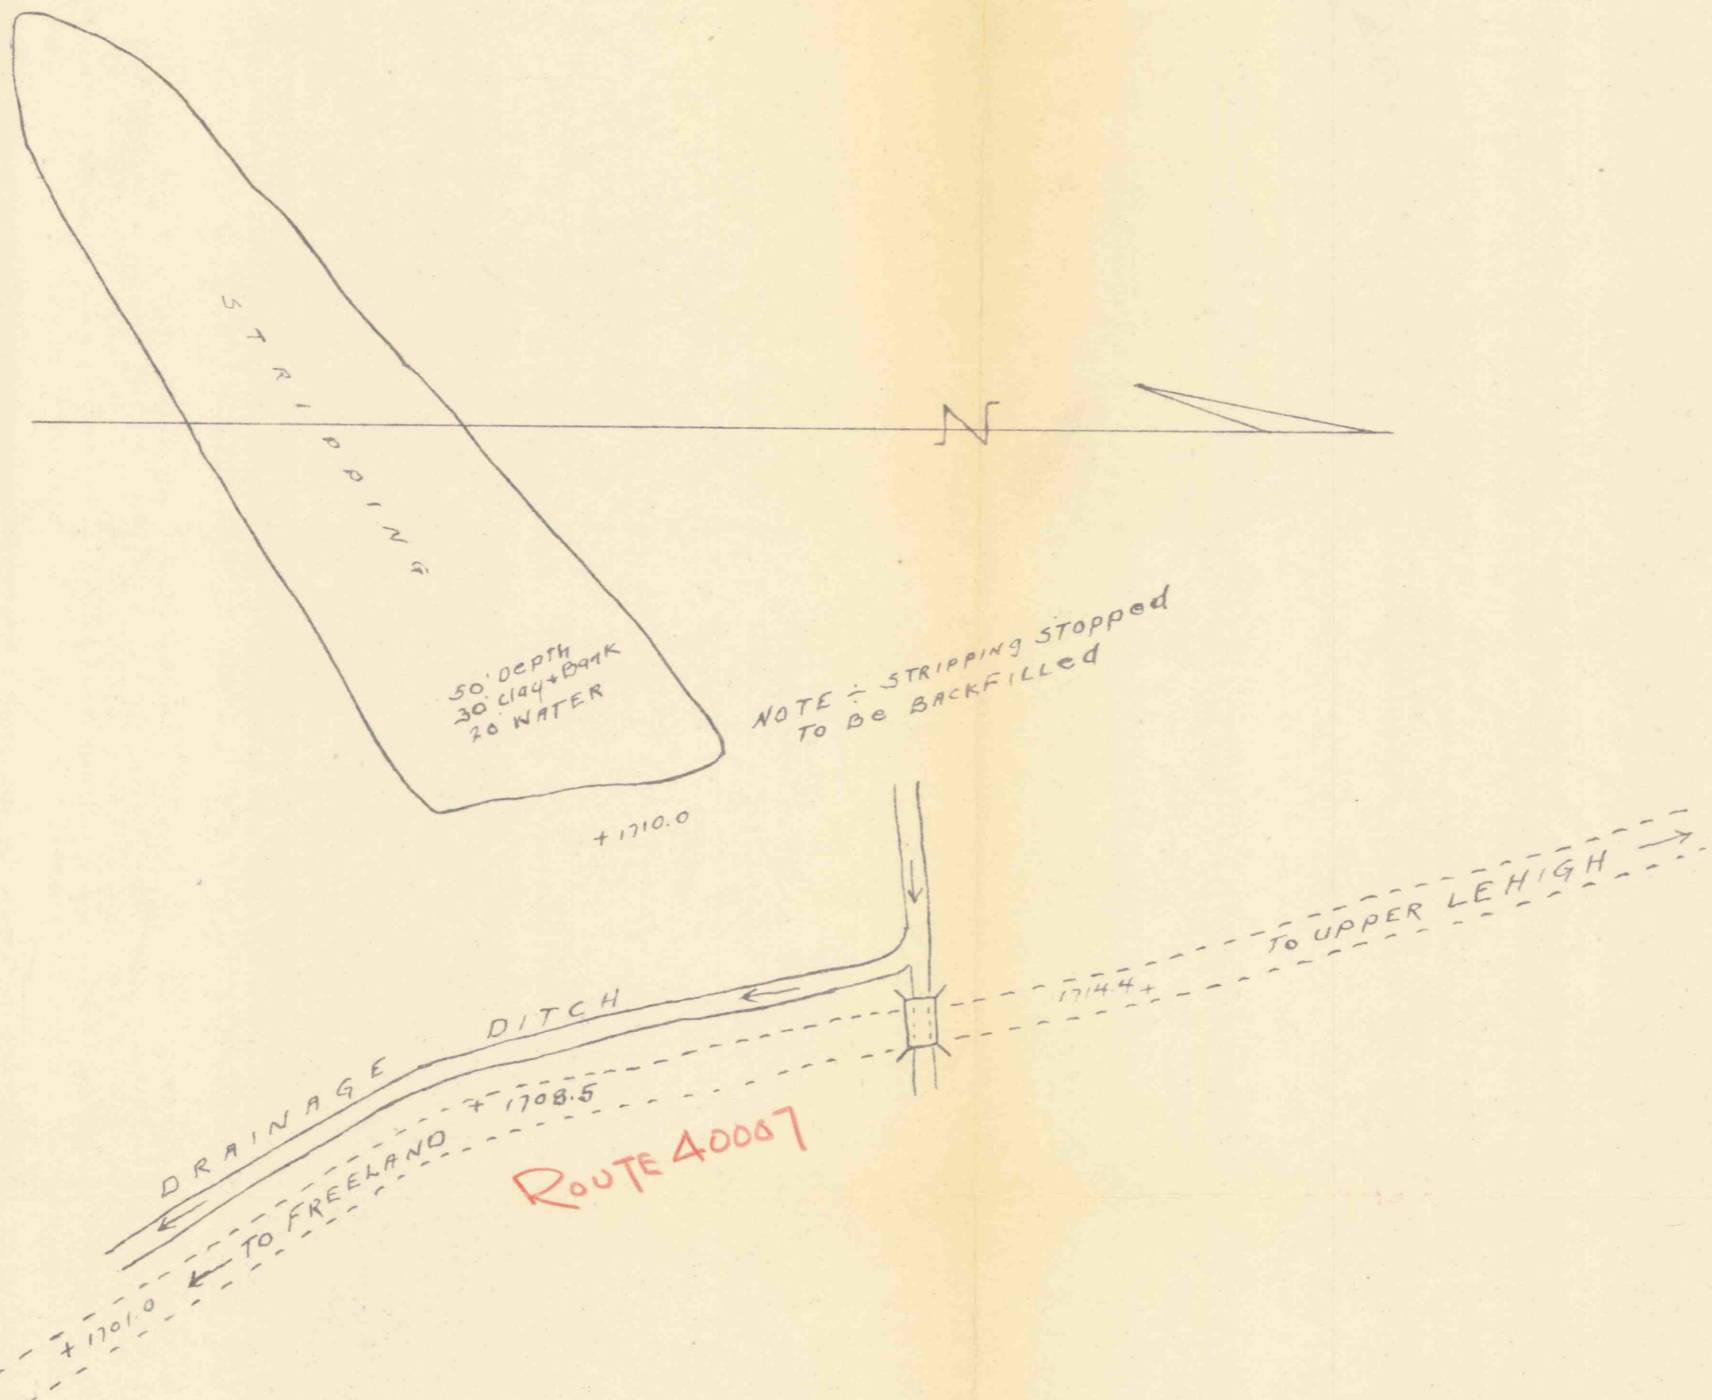

MAP SHOWING STRIPPING IN RELATION
TO HIGHWAY BETWEEN FREELAND + UPPER LEHIGH
PROPERTY OF SANDY RUN MINERS + PRODUCERS INC.
2-20-54 SCALE 1" = 100' JOHN W. WALTERS
STATE REG. PROF. ENGINEER #3499.