


pillars in these areas to be removed

B-12-2

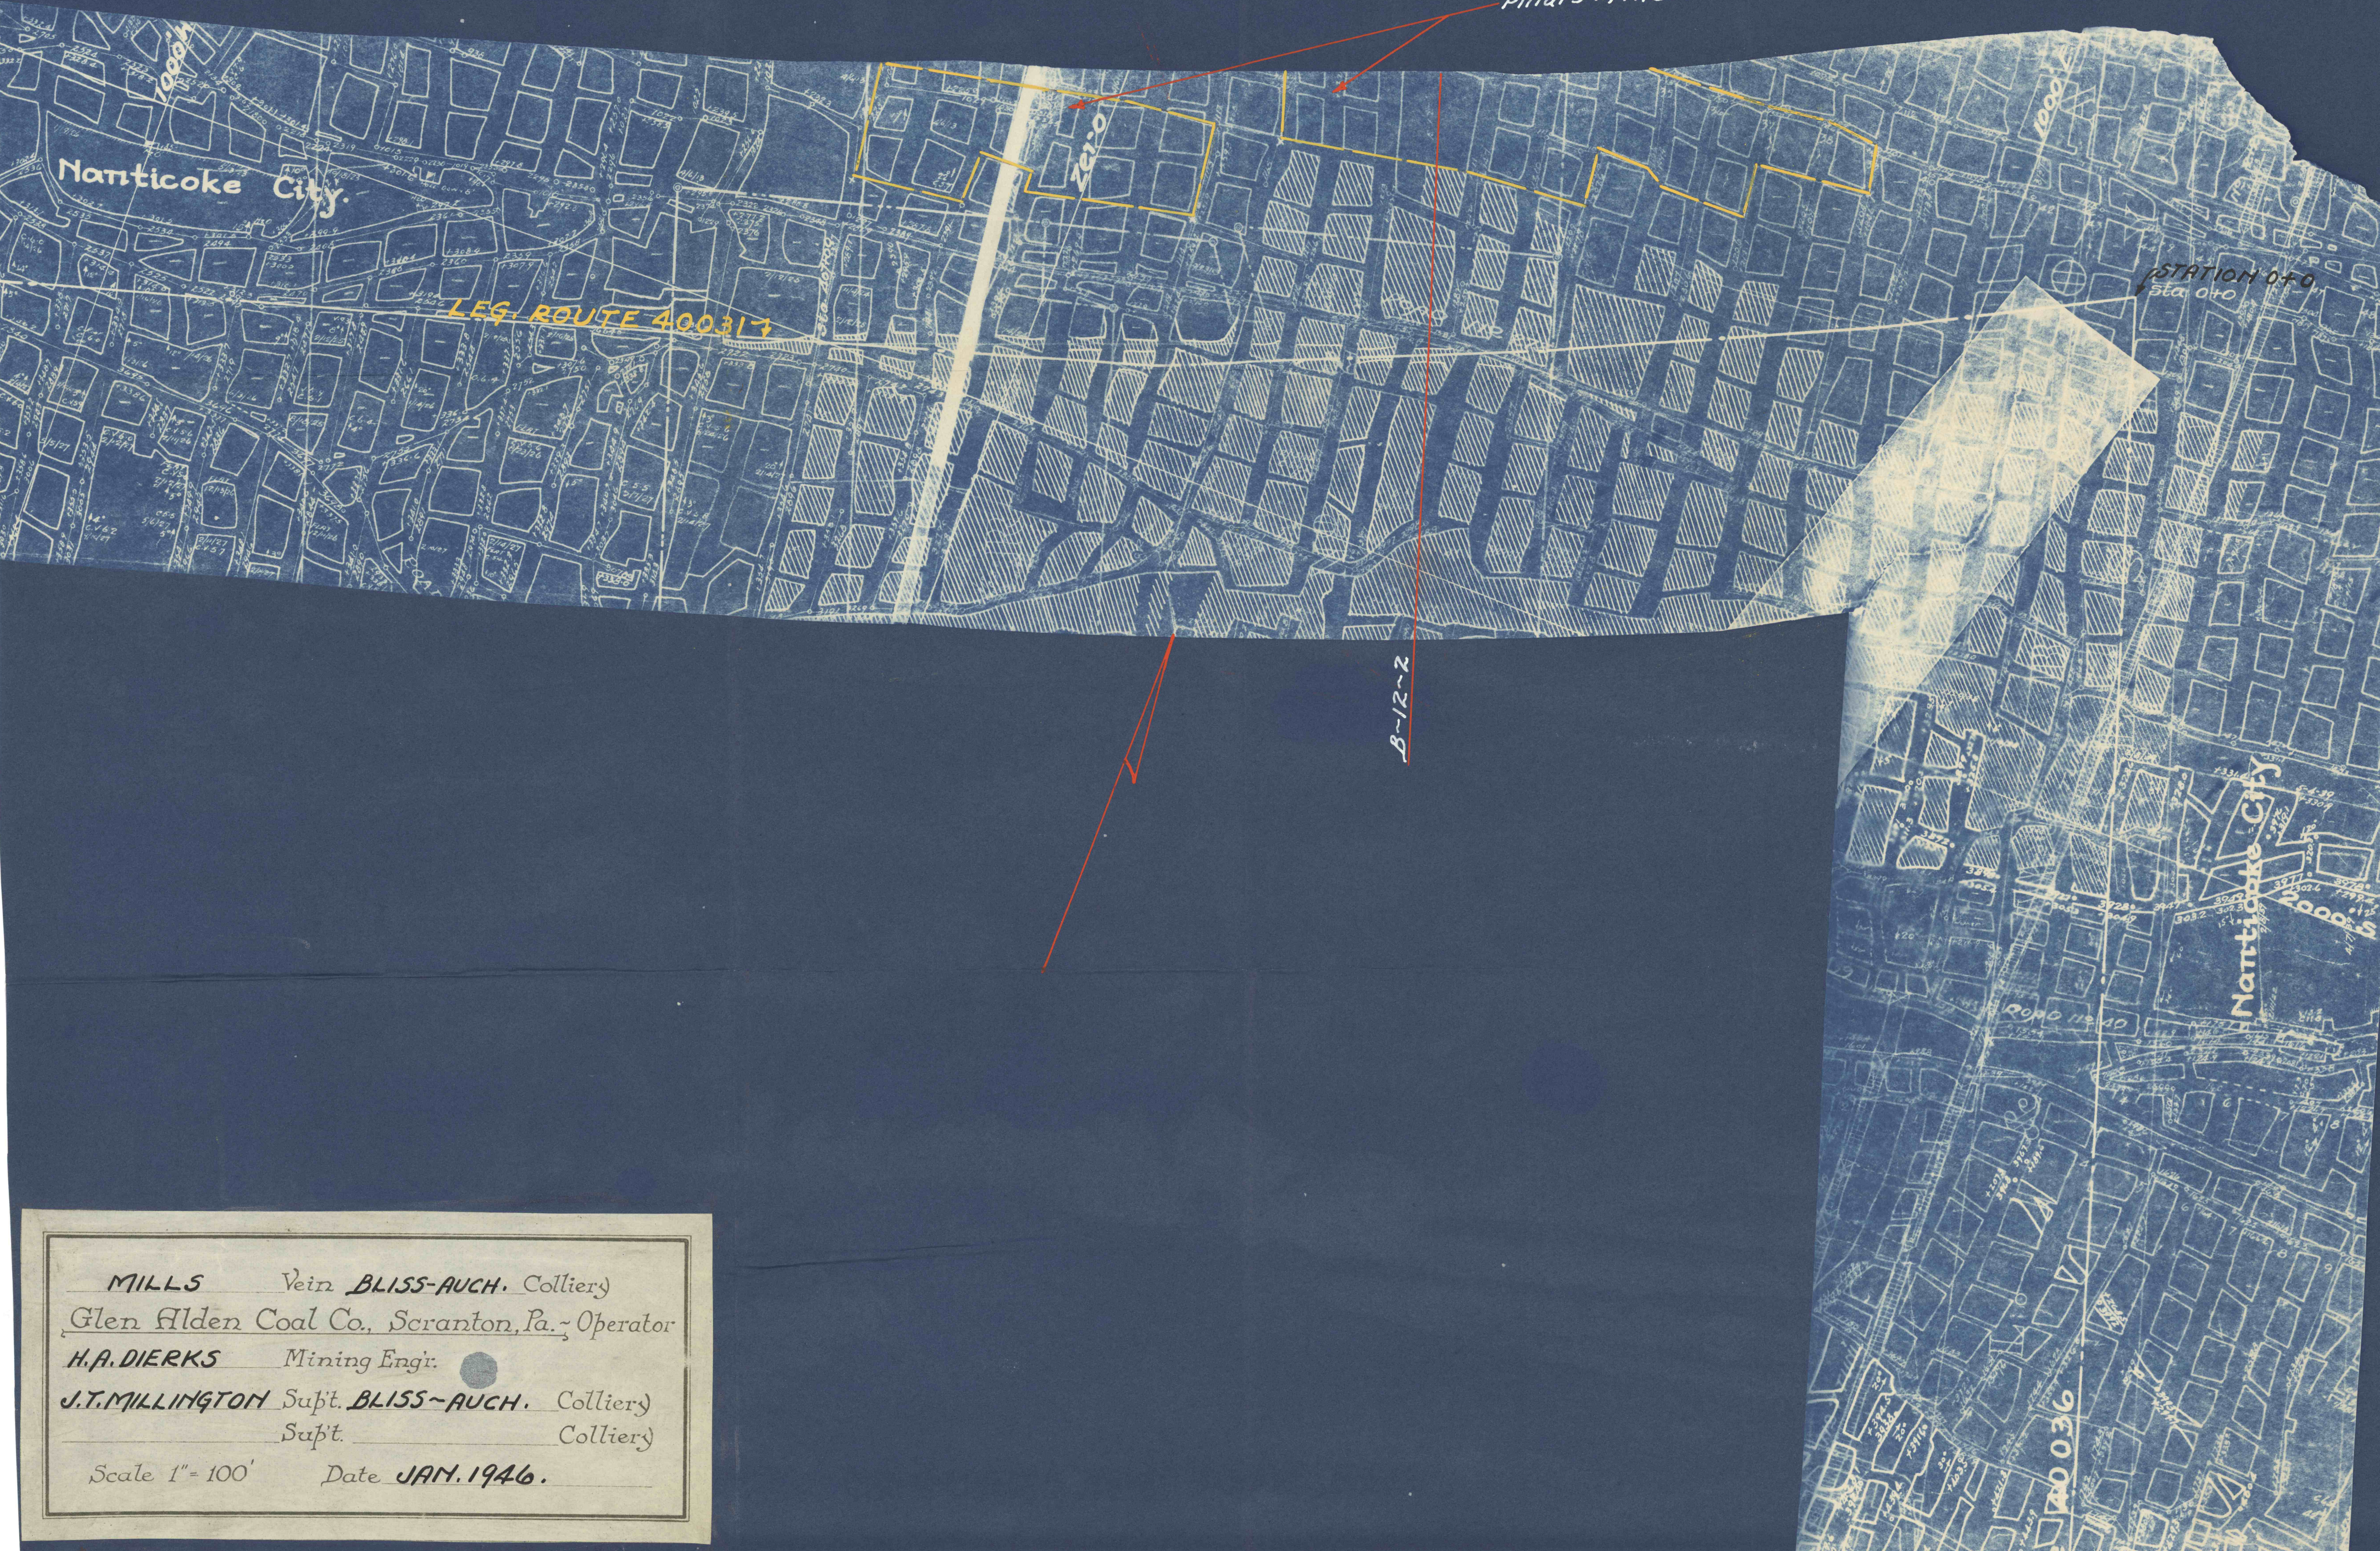

MILLS Vein *BLISS-AUCH.* Colliery
 Glen Alden Coal Co., Scranton, Pa. ~ Operator
 H.A. DIERKS Mining Engr.
 J.T. MILLINGTON Supt. *BLISS-AUCH.* Colliery
 Supt. Colliery
 Scale 1" = 100' Date *JAN. 1946.*