


*pillars in this area to be removed*

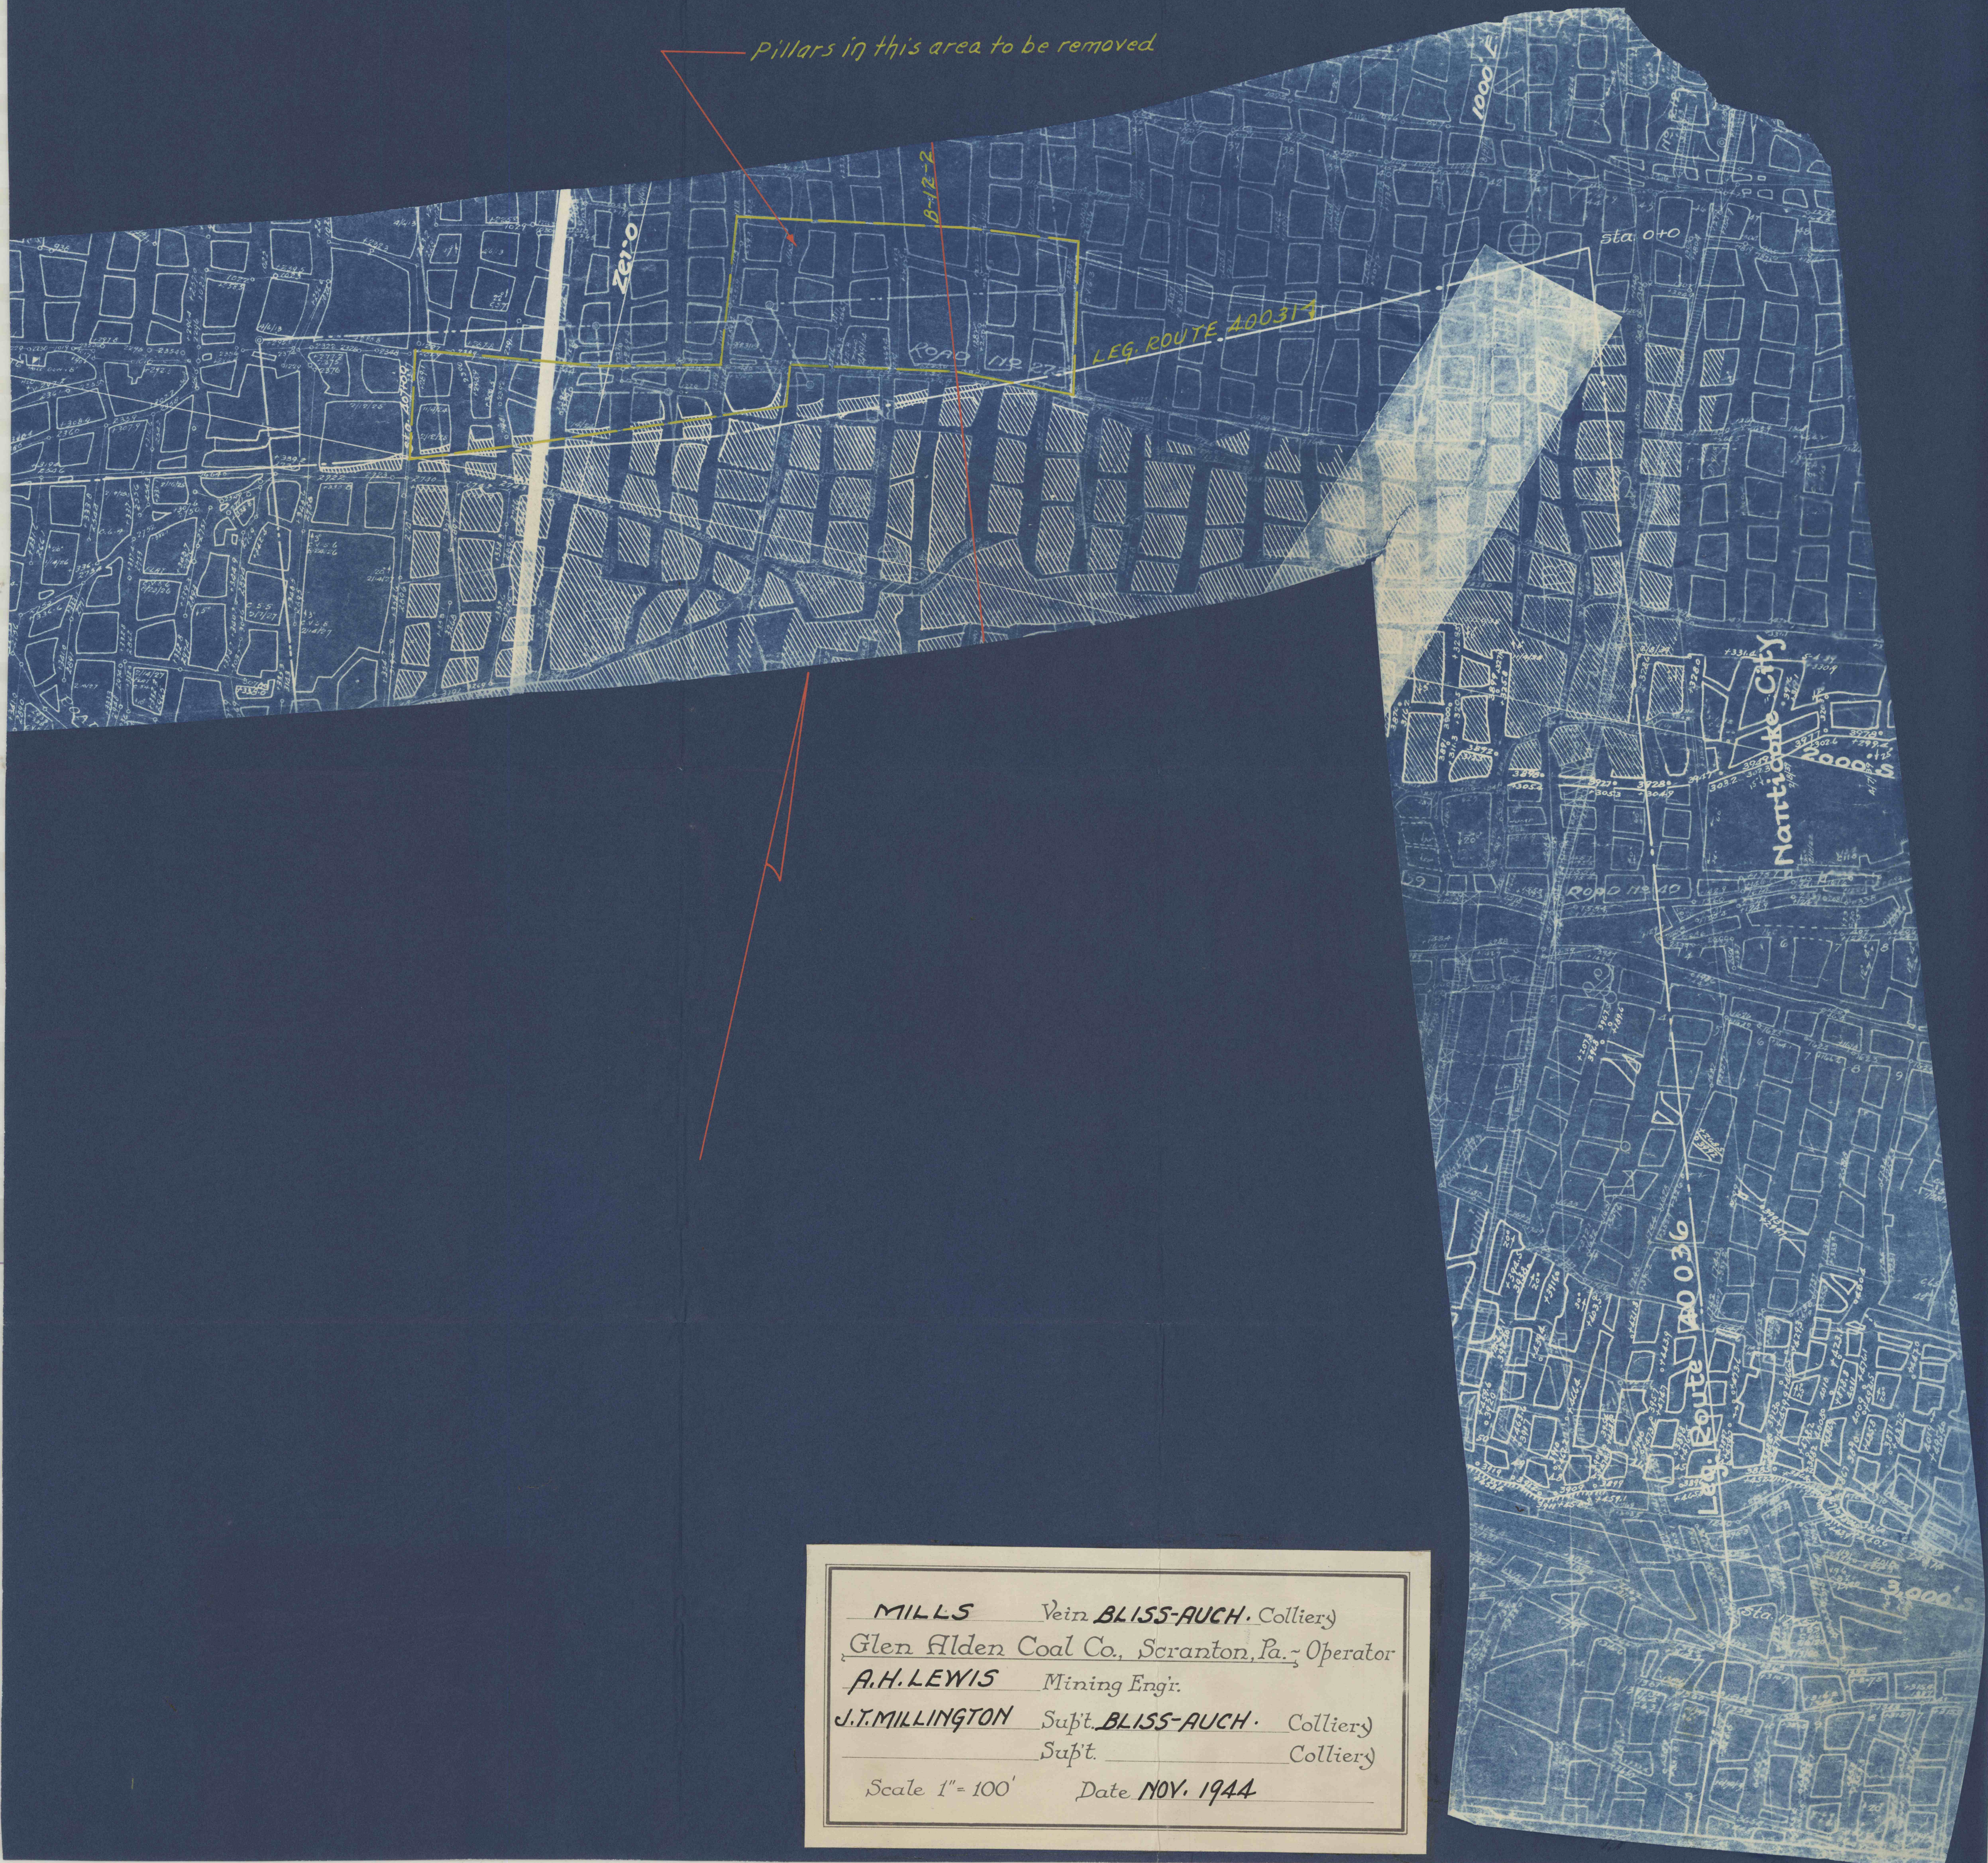

MILLS Vein BLISS-AUCH. Colliers  
Glen Alden Coal Co., Scranton, Pa., Operator  
A.H. LEWIS Mining Engr.  
J.T. MILLINGTON Supt. BLISS-AUCH. Colliers  
Supt. Colliers

Scale 1" = 100' Date NOV. 1944