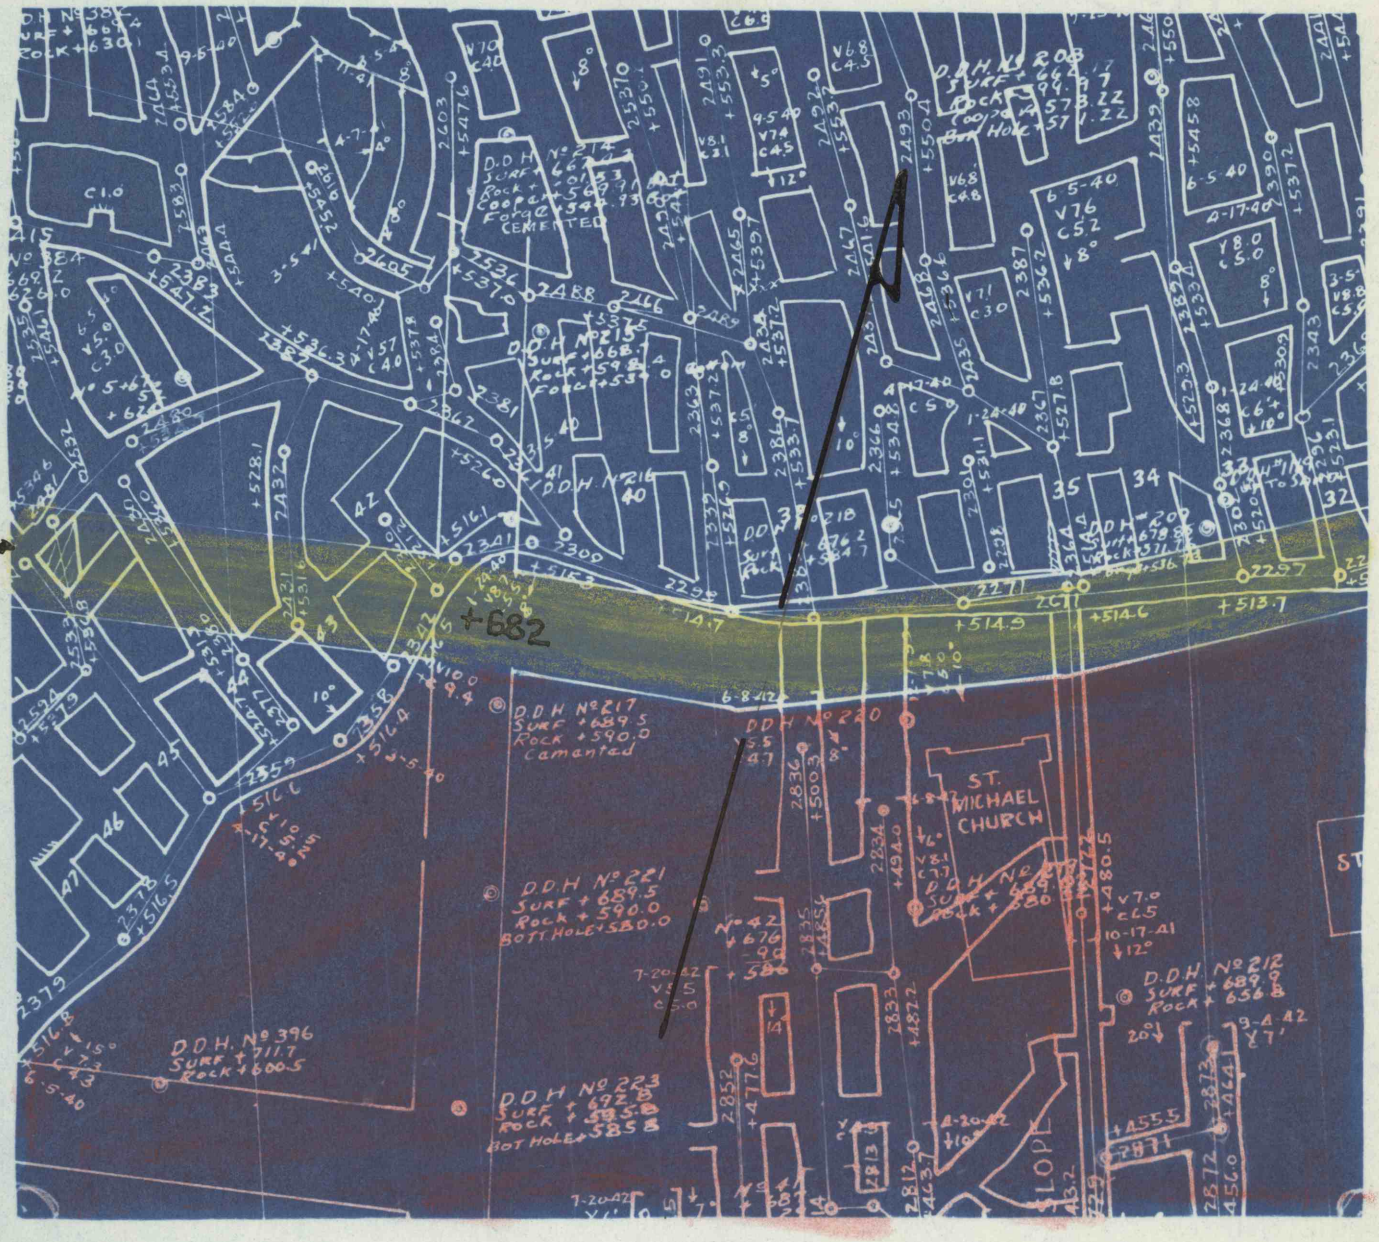

Highway

Proposed mining

SUSQUEHANNA COLLIERIES CO.
GLEN LYON COLLIERY

PRINT SHOWING PROPOSED MINING IN FORGE SEAM IN RELATION TO STATE HIGHWAY NO. 40031.

Scale 1"-100'. Oct. 6, 1942