


46
+85



681
535
146

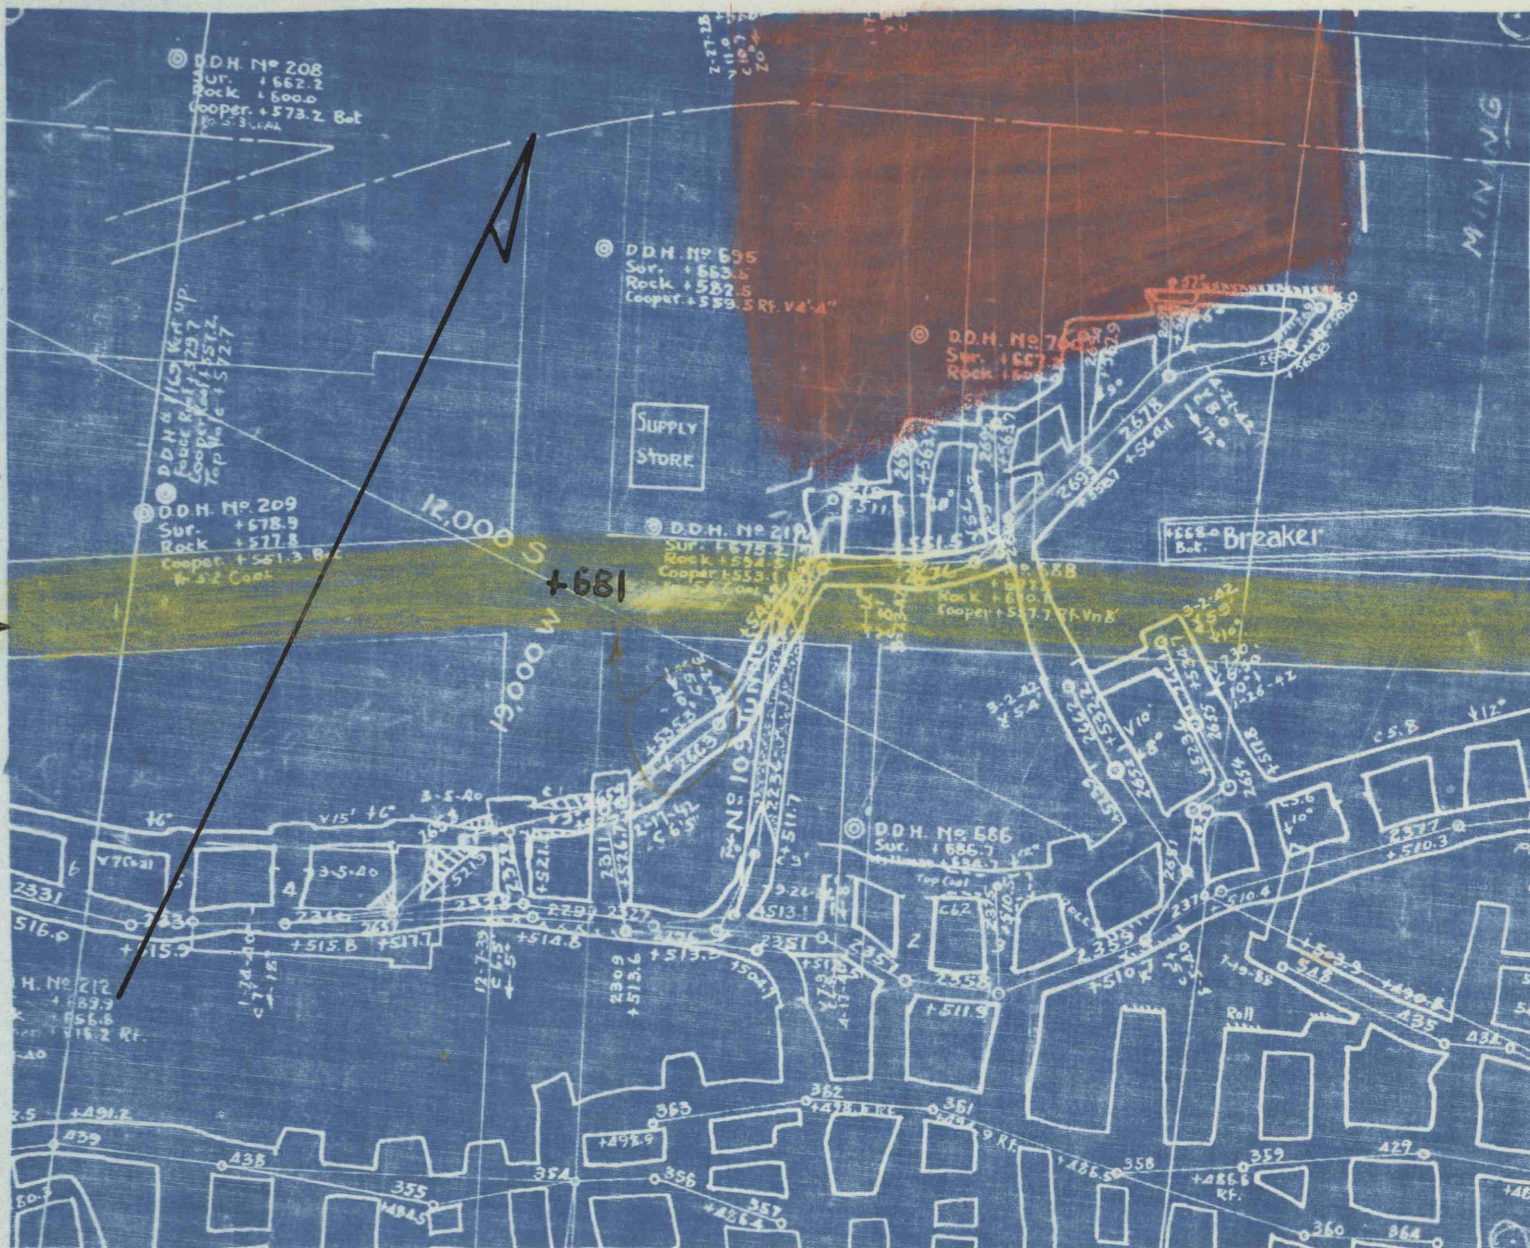

Highway

Proposed Mining

SUSQUEHANNA COLLIERIES CO.
GLEN LYON COLLIERY
PRINT SHOWING PROPOSED MINING
IN COOPER SEAM IN RELATION TO
STATE HIGHWAY NO. 40031.

Scale 1"-100'. Oct. 6, 1942.