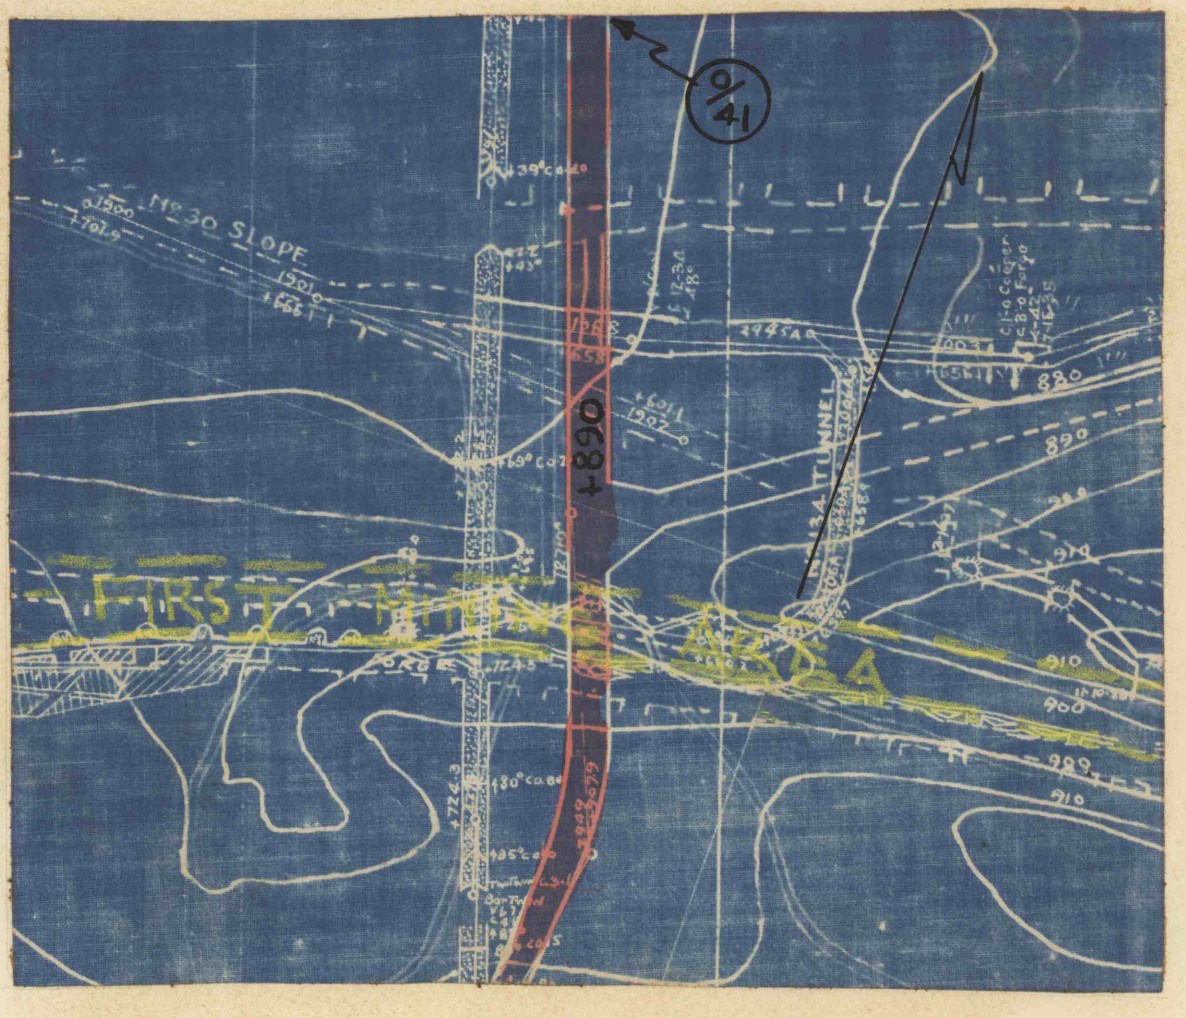

SUSQUEHANNA COLLIERIES DIVISION
THE M. A. HANNA COMPANY
GLEN LYON COLLIERY

PRINT SHOWING PROPOSED MINING
IN COOPER SEAM IN RELATION TO
STATE HIGHWAY NO. 40031

SCALE 1" - 100' Mar. 8, 1951

HIGHWAY

PROPOSED MINING