


MAY 23, 1946

ROUTE 40031 - STA 54+00
NEWPORT TOWNSHIP TOWNSHIP
BELOW GLEN LYON.

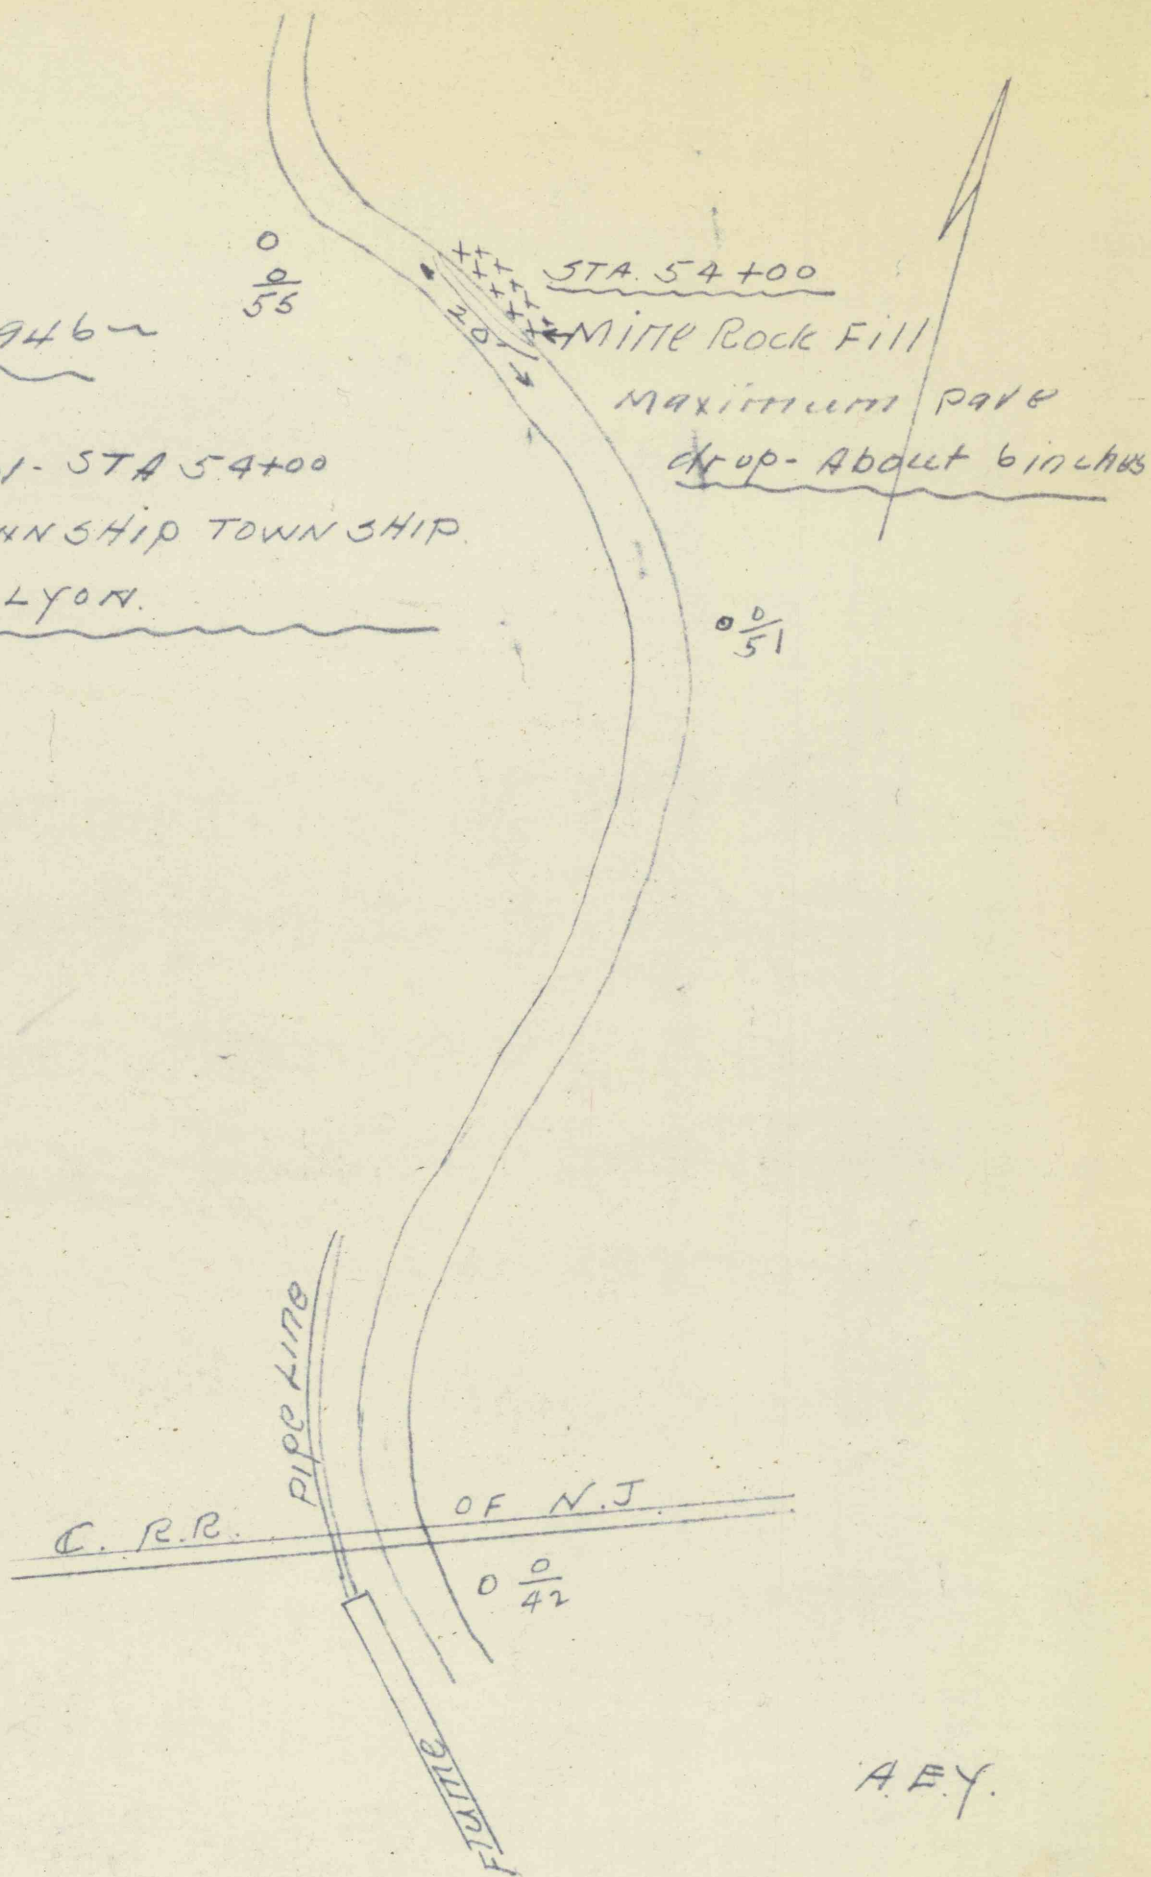

A.E.Y.