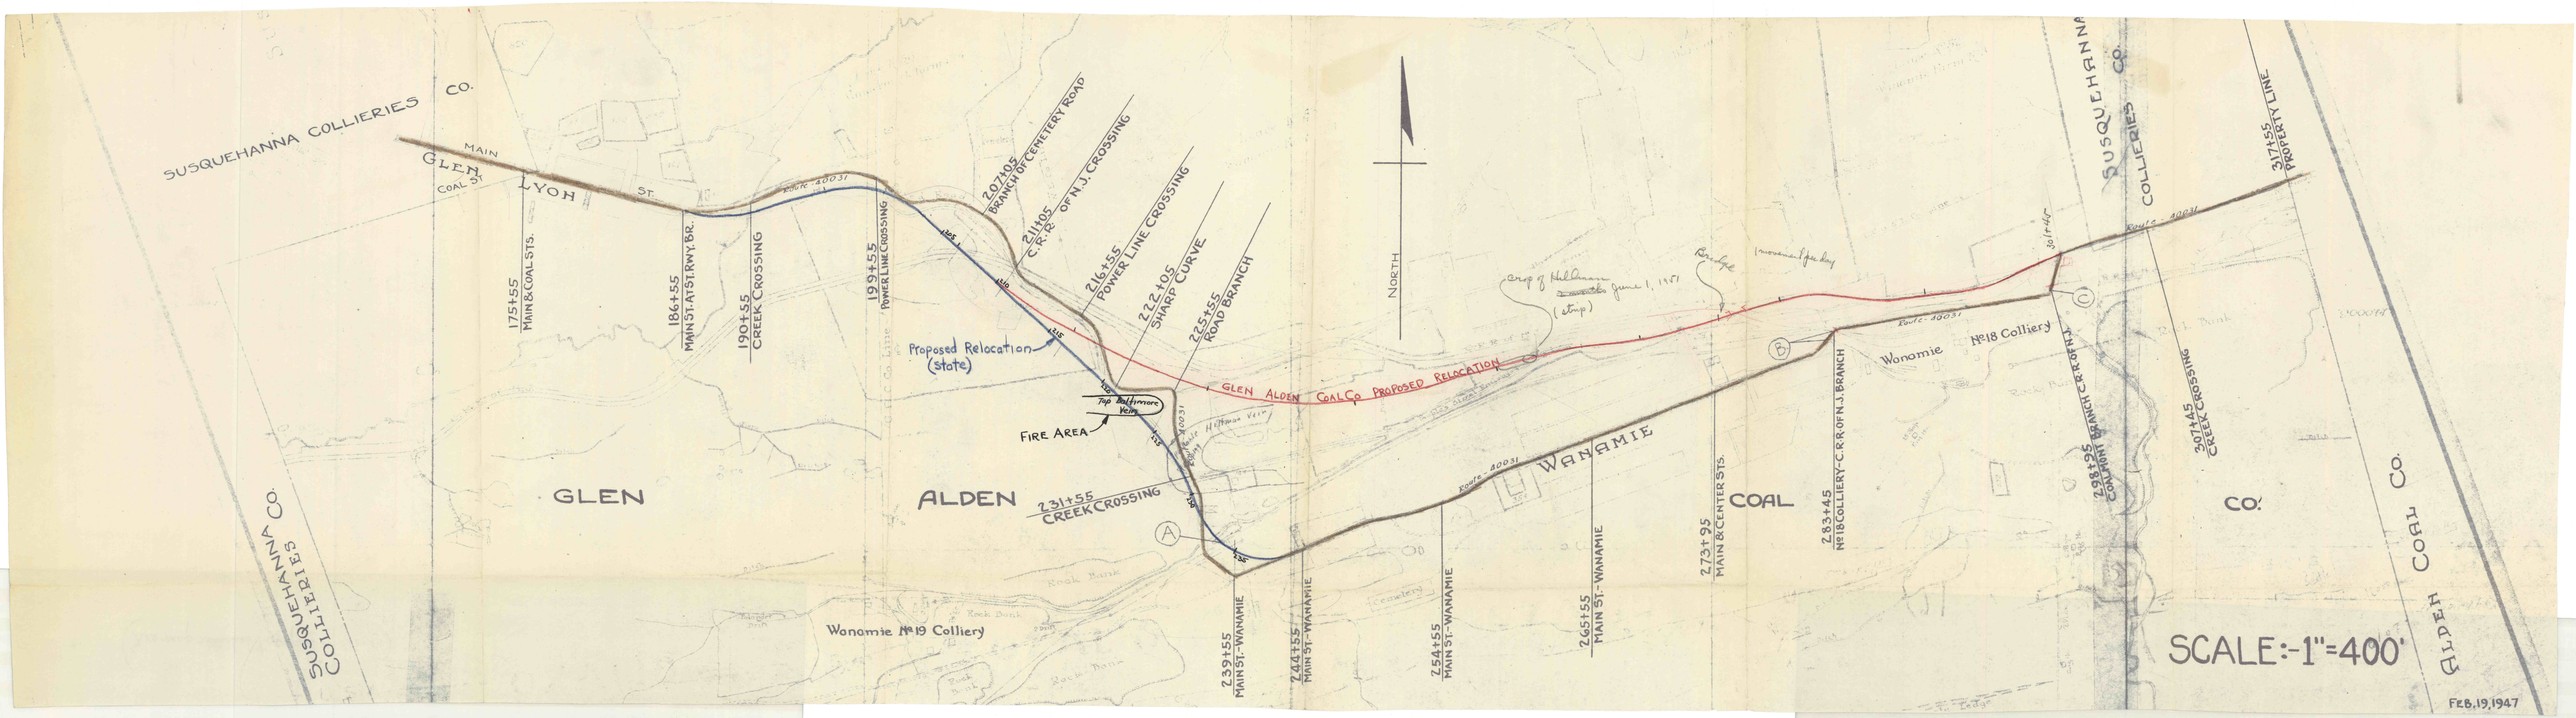
SUSQUEHANNA COLLIERIES CO.
MAIN
GLEN LYON
COAL ST.
ST.
175+55
MAIN & COAL STS.
186+55
MAIN ST. AT ST. RWY. BR.
190+55
CREEK CROSSING
193+55
POWER LINE CROSSING
207+05
BRANCH OF CEMETERY ROAD
211+05
C.R.R. OF N.J. CROSSING
216+55
POWER LINE CROSSING
222+05
SHARP CURVE
225+55
ROAD BRANCH
Proposed Relocation (state)
GLEN ALDEN COAL CO PROPOSED RELOCATION
Top Baltimore Vein
FIRE AREA
231+55
CREEK CROSSING
GLEN
ALDEN
Wanamie No 19 Colliery
239+55
MAIN ST.-WANAMIE
244+55
MAIN ST.-WANAMIE
254+55
MAIN ST.-WANAMIE
265+55
MAIN ST.-WANAMIE
273+95
MAIN & CENTER STS.
283+45
No 18 COLLIERY-C.R.R. OF N.J. BRANCH
Wanamie No 18 Colliery
298+95
COAL BRANCH C.R.R. OF N.J.
307+45
CREEK CROSSING
317+55
PROPERTY LINE
SUSQUEHANNA COLLIERIES CO.
COAL CO.
ALDEN
NORTH
SCALE:-1"=400'
FEB. 19, 1947