


Pillars to be removed
in this Area

Section Line

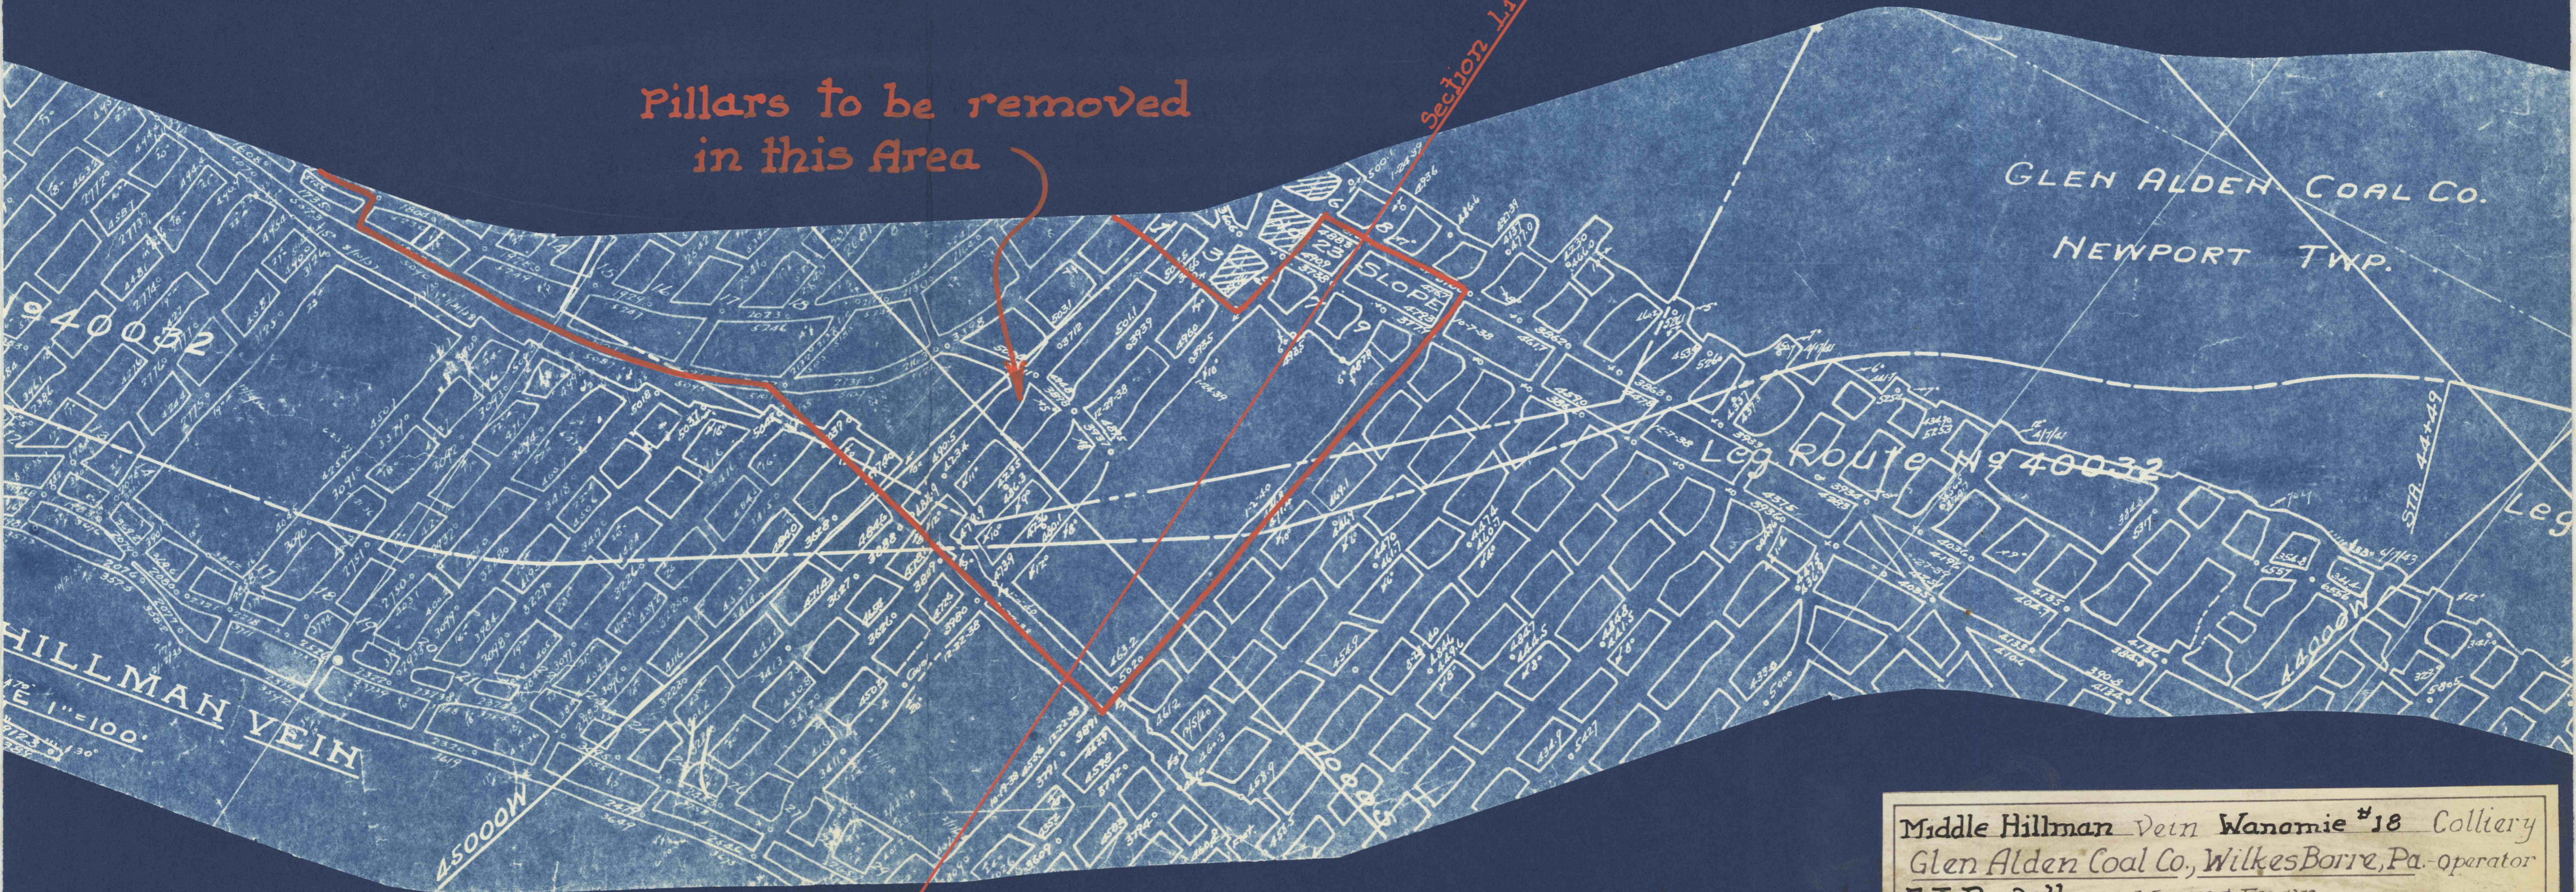

Middle Hillman Vein Wanamie #18 Colliery
Glen Alden Coal Co., Wilkes Barre, Pa. - operator
E. T. Powell Mining Engr.
J. Zimmerman Supt. Wanamie Colliery
Supt. Colliery
Scale 1" = 100' Date April 13, 1955