


GLEN ALDEN COAL CO.

THE M. A. HANNA CO.

N 68° 17' E

25° 00' W

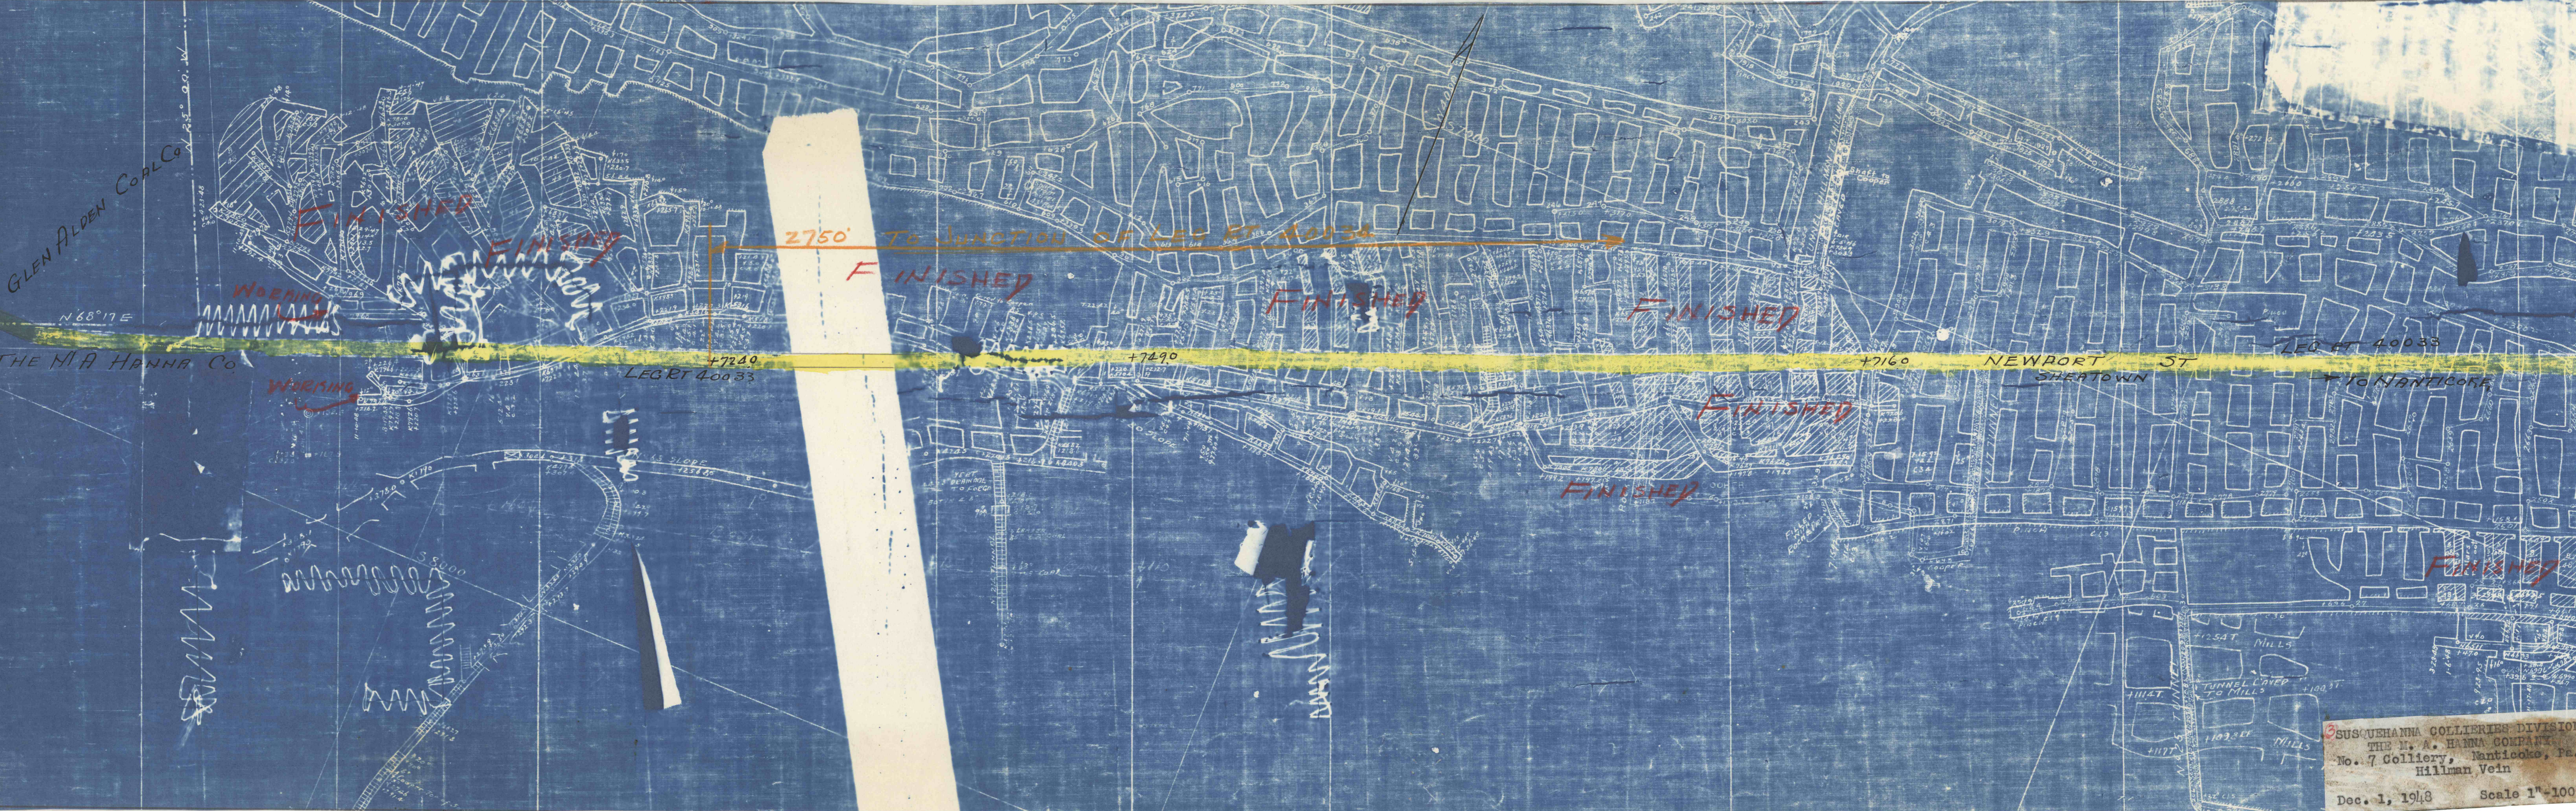

SUSQUEHANNA COLLIERIES DIVISION
 THE M. A. HANNA COMPANY
 No. 7 Colliery, Nanticoke, Pa.
 Hillman Vein
 Dec. 1, 1948 Scale 1"=100'