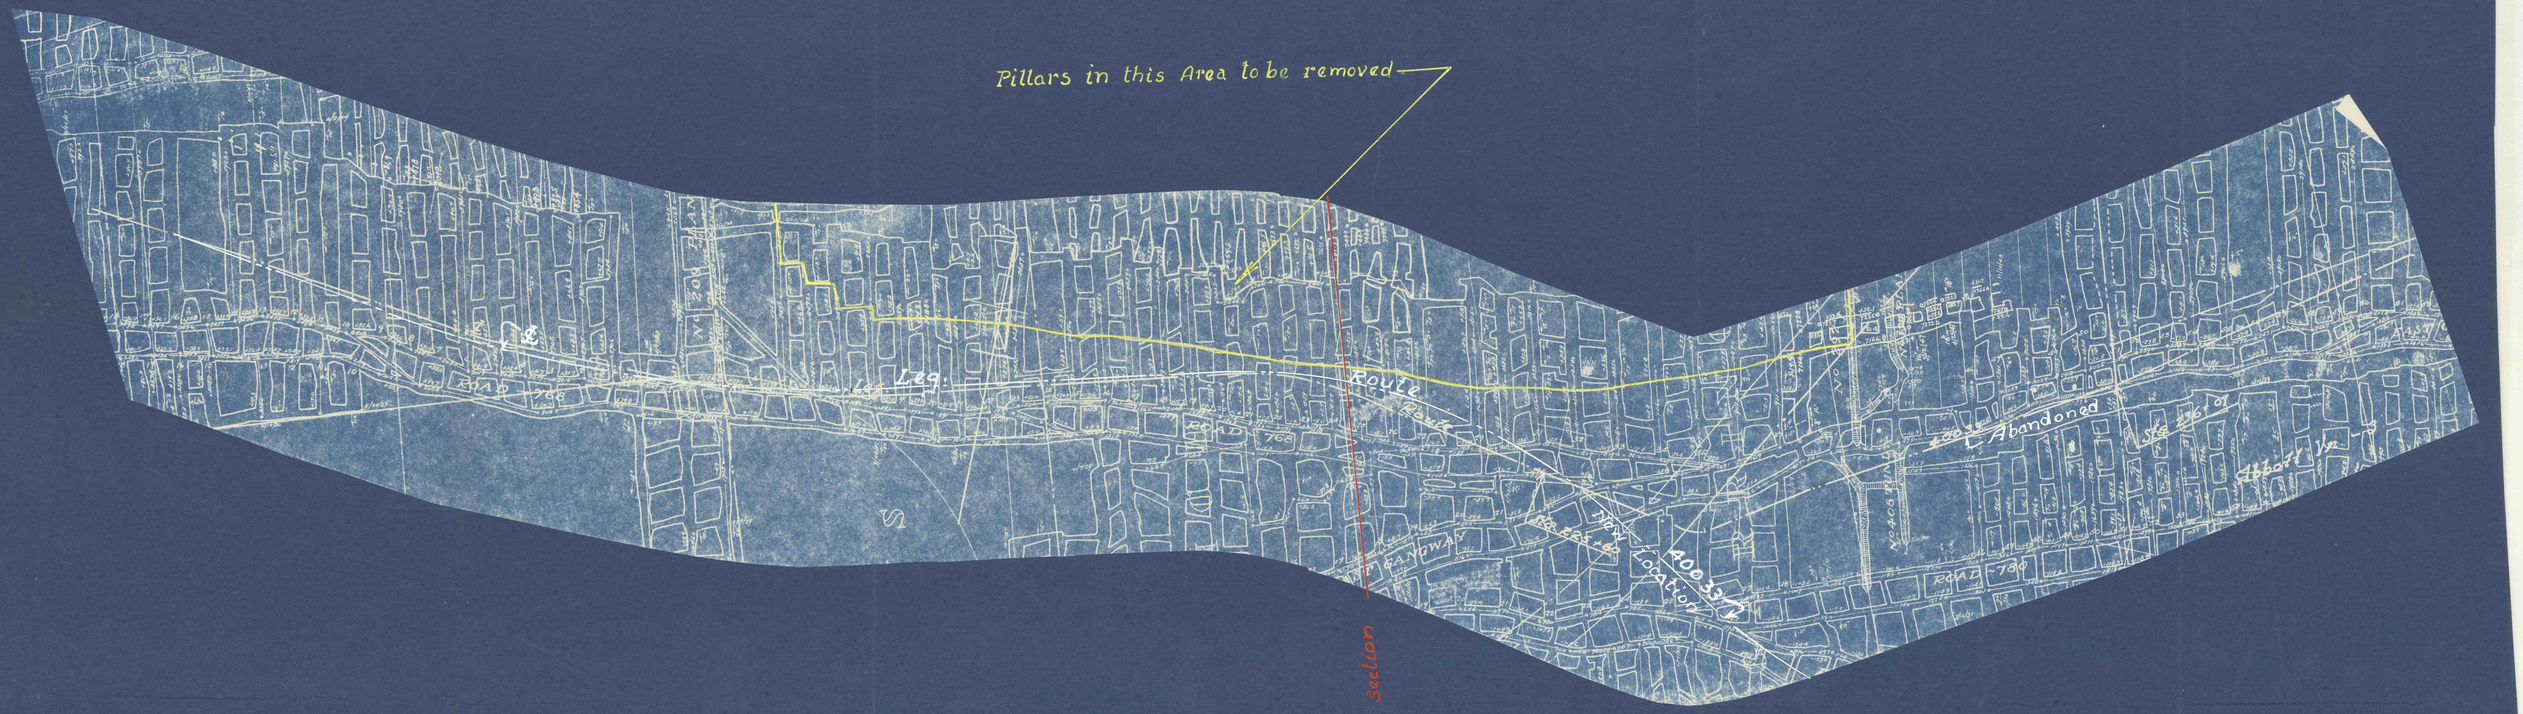

Abbott Vein Loomis Colliery
Glen Alden Coal Co., Scranton, Pa. Operator
Mr. E. T. Powell Mining Eng'r.
Mr. Dan. Thomas Supt. Loomis Colliery
Supt. Colliery
Scale 1"=100' Date 1-13-53