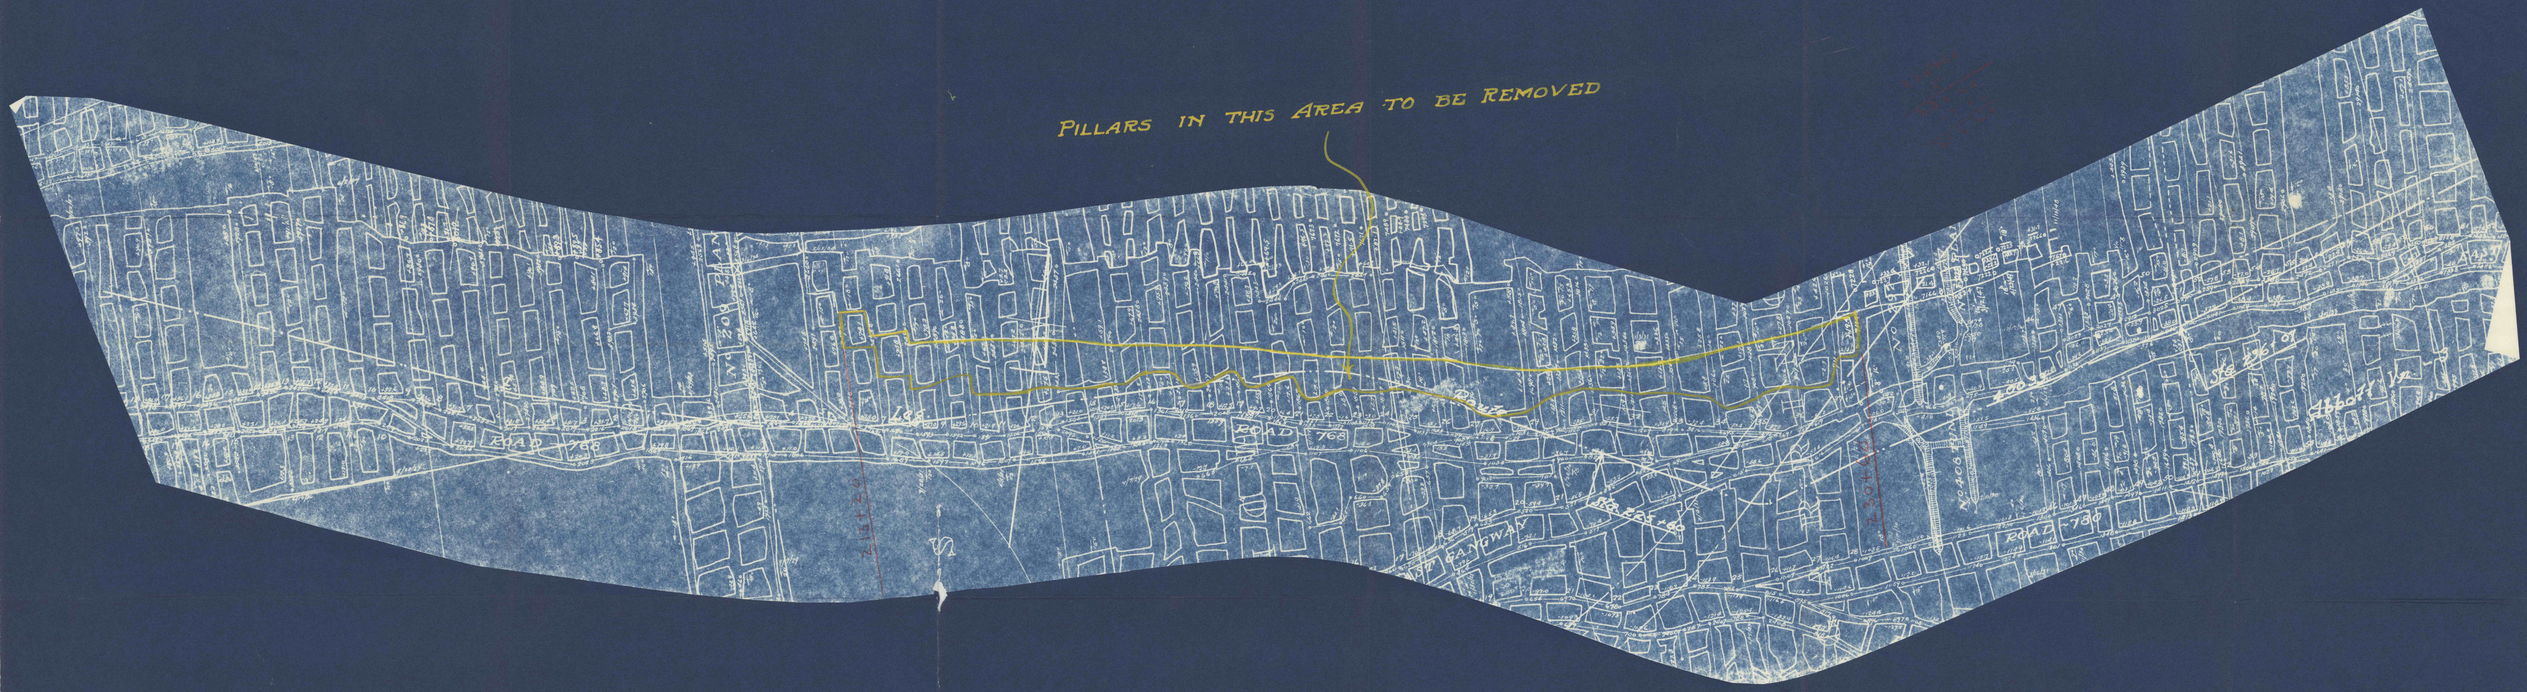

Abbott Vein Loomis Colliery
Glen Alden Coal Co., Scranton, Pa.-Operator
Mr. E.T. Powell Mining Eng'r.
Mr. J.A. Hamilton Sup't. Loomis Colliery
Sup't. Colliery
Scale 1" = 100' Date 2- -54