


HANOVER TWP
Button Wood

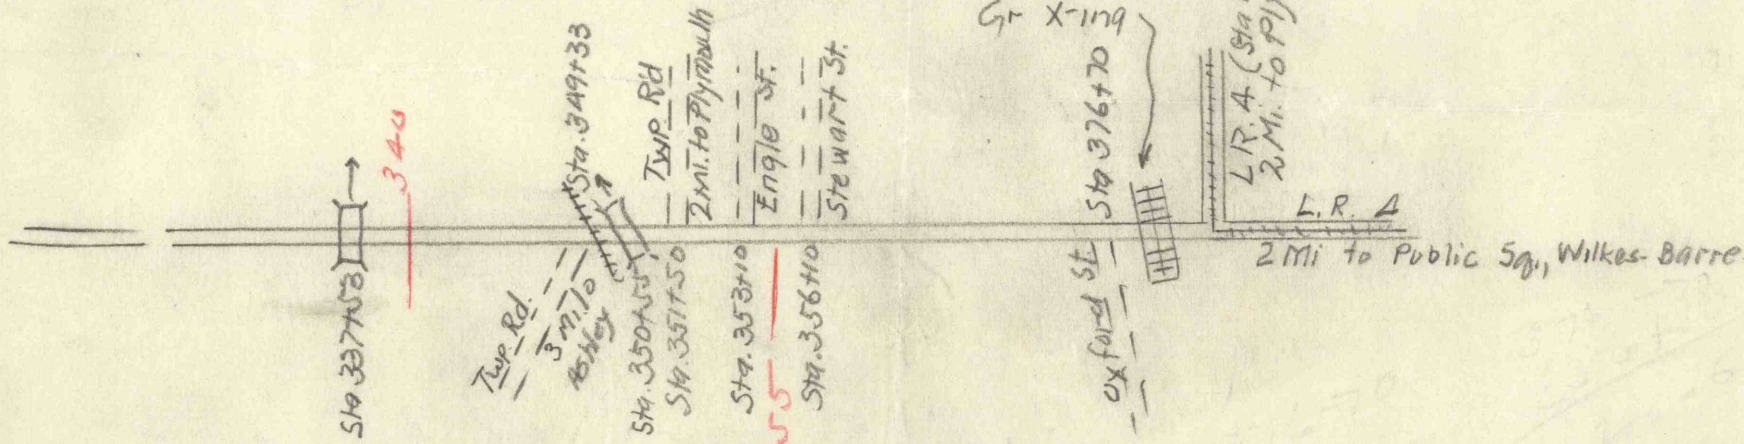

376+70
<u>355</u>
- 21+70
376+70
<u>355</u>
- 20+60