

2-29-40


BARTEN

BRADIN

SEC. 2
40033-ONLY

TO ALDEN

TO NANTICOKE 2000'

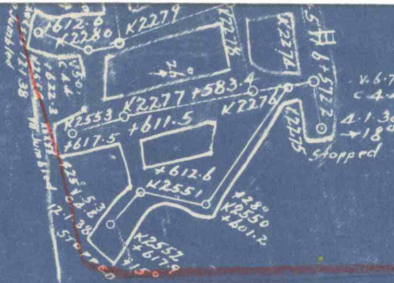

D.P.H. No. 936
 1634.54 SQ. FT.
 1594.68 ROCK
 1580.10 BOT'M. 2:15" Tol. Geo.
 1554.36 " 3:3" Bot. Geo.

D.P.H. No. 934
 1631.93 SQ. FT.
 1594.68 ROCK
 1585.76 BOT'M. 5:10" Bot. Geo.


113.6

136.3

142.3

SUSQUEHANNA COLLIERIES COMPANY, ②
 No. 7 Colliery, Newport Twp., Pa.
 No. 16 Slope Bottom George Seam
 Feb. 21, 1940 Scale 1" = 100'