

SEC. B1-8

8

1000N  
Highway 5635740  
L.R. #40033

2000N

G.R.R.

B.H. 87 FCC

CREEK

C.T.R.

B.H. 601


B.H. 74 FCC

B.H. 604

B.H. 600

STREET RR

B.H. 595

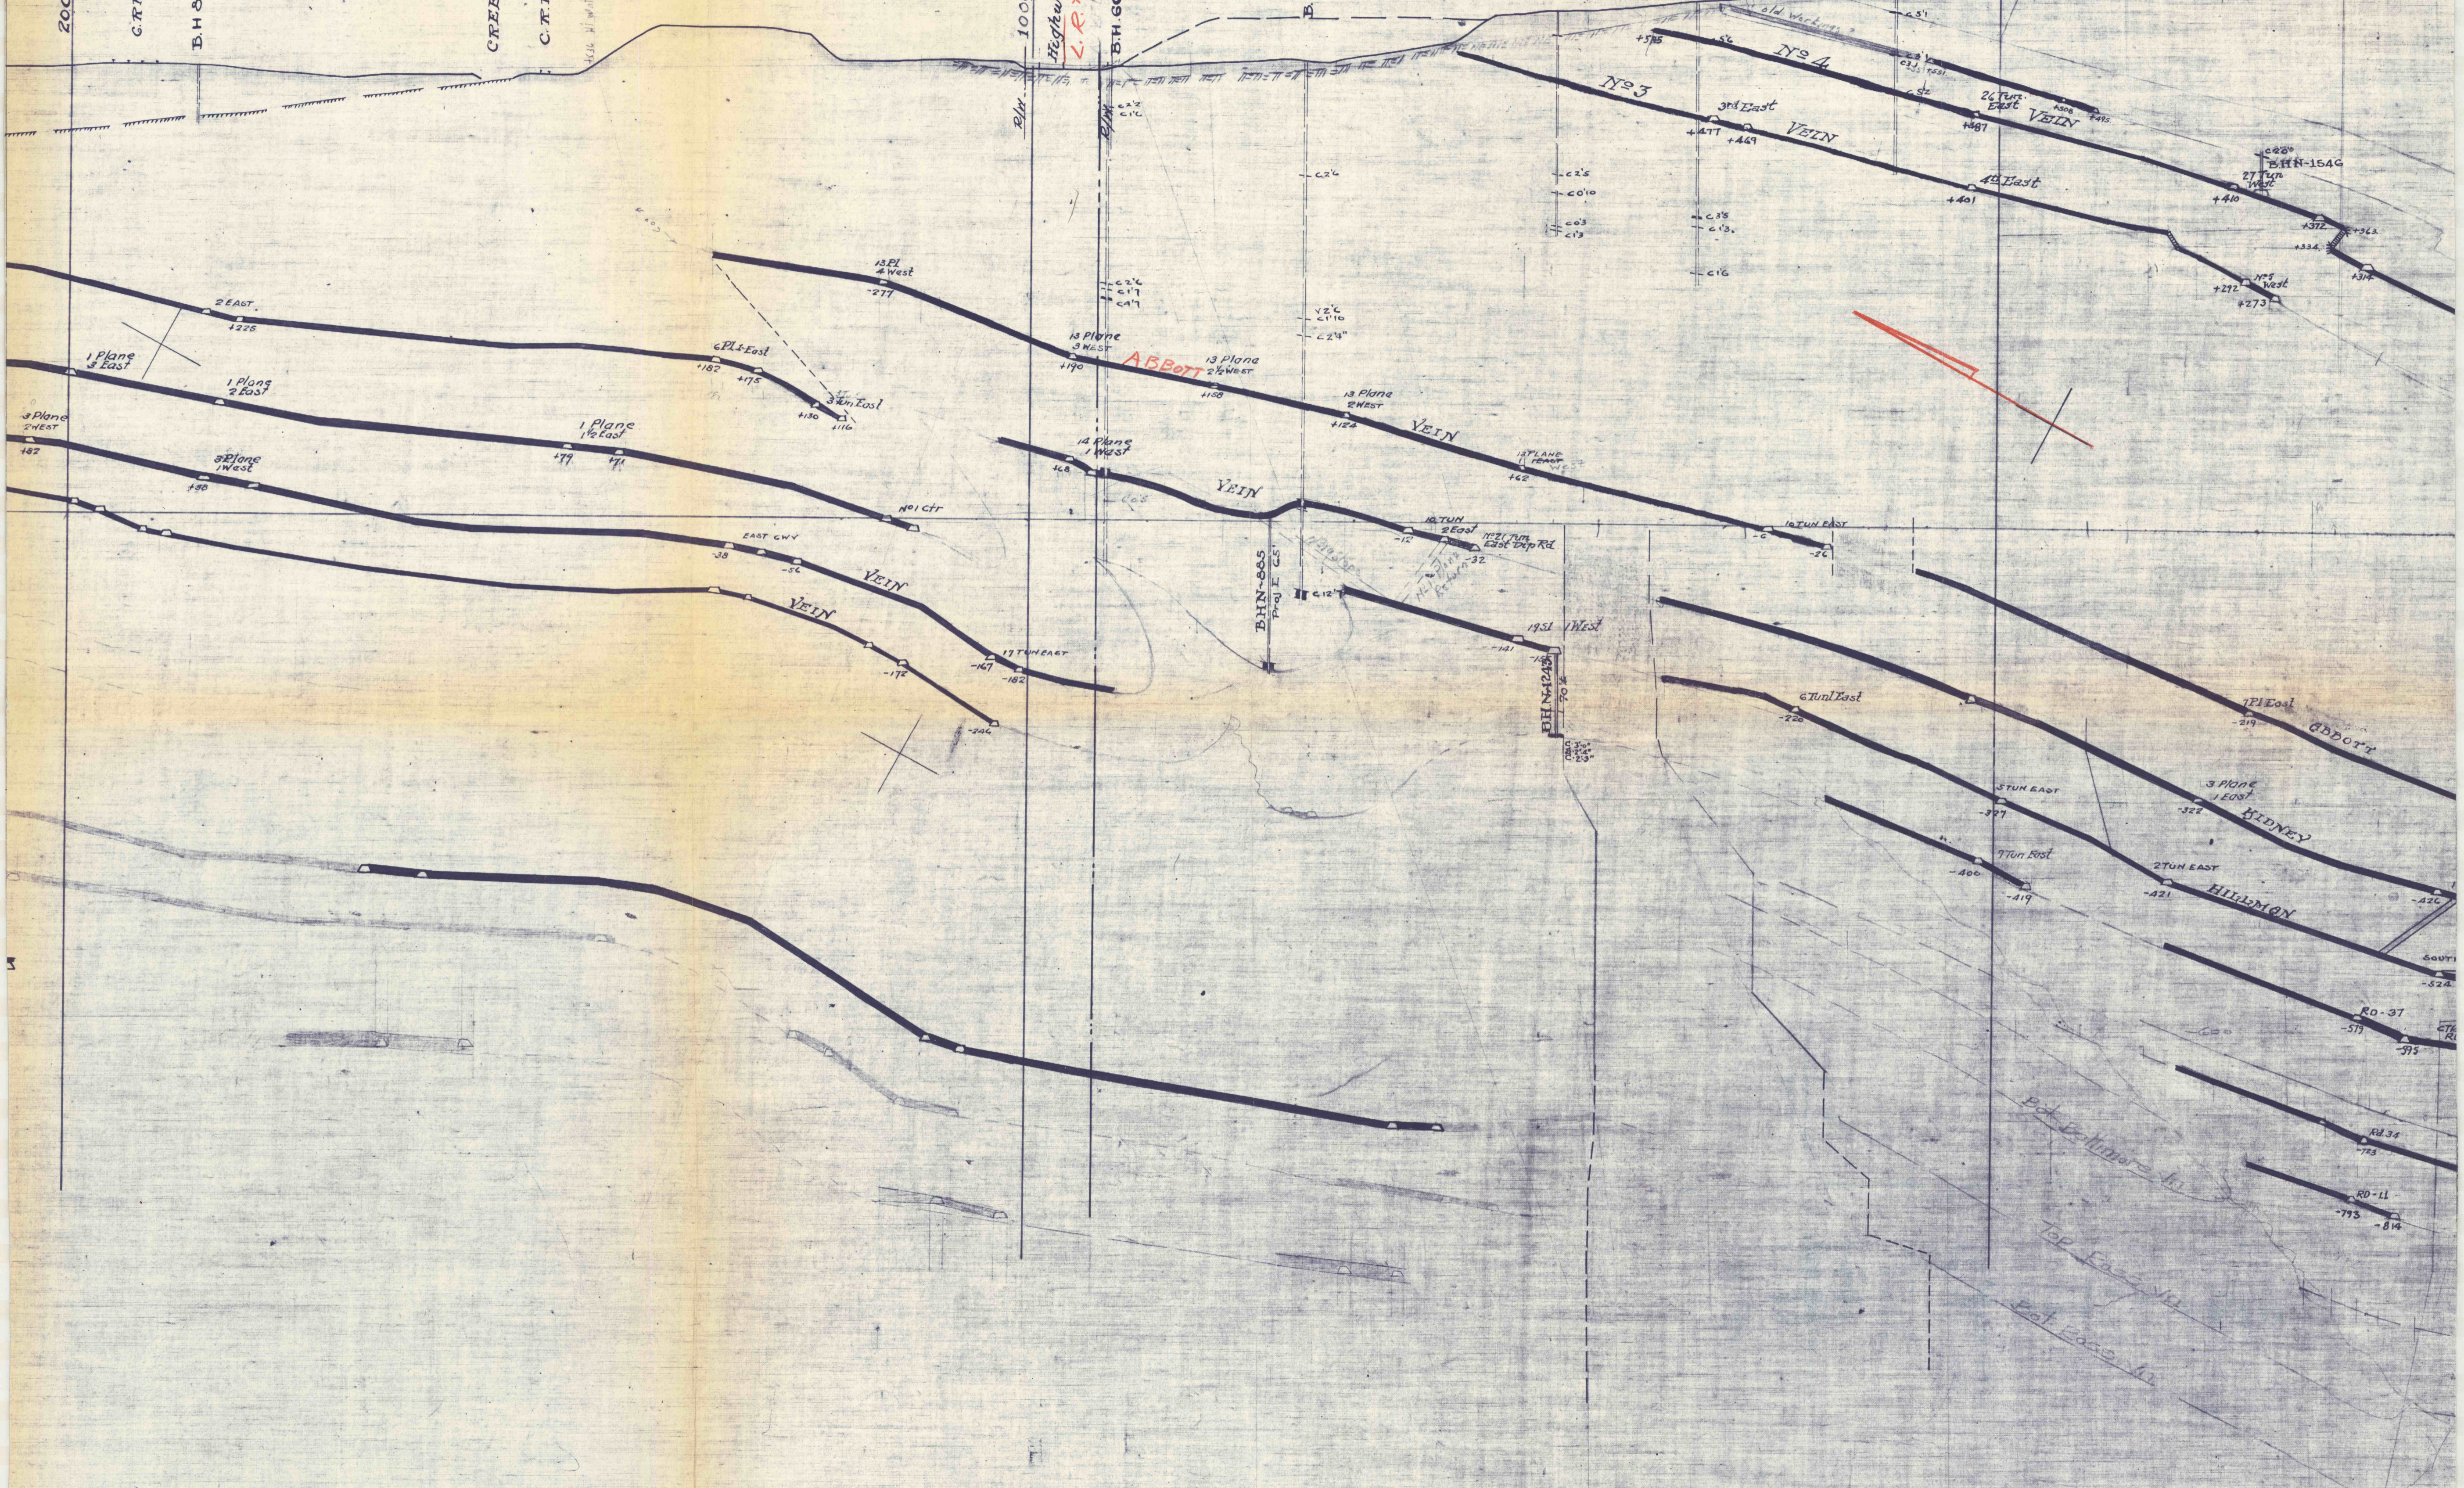

Scale 1" = 100'  
Bottom wood Colliery  
Gen Alden Corp