


LEG. ROUTE 40033, SPUR "E"

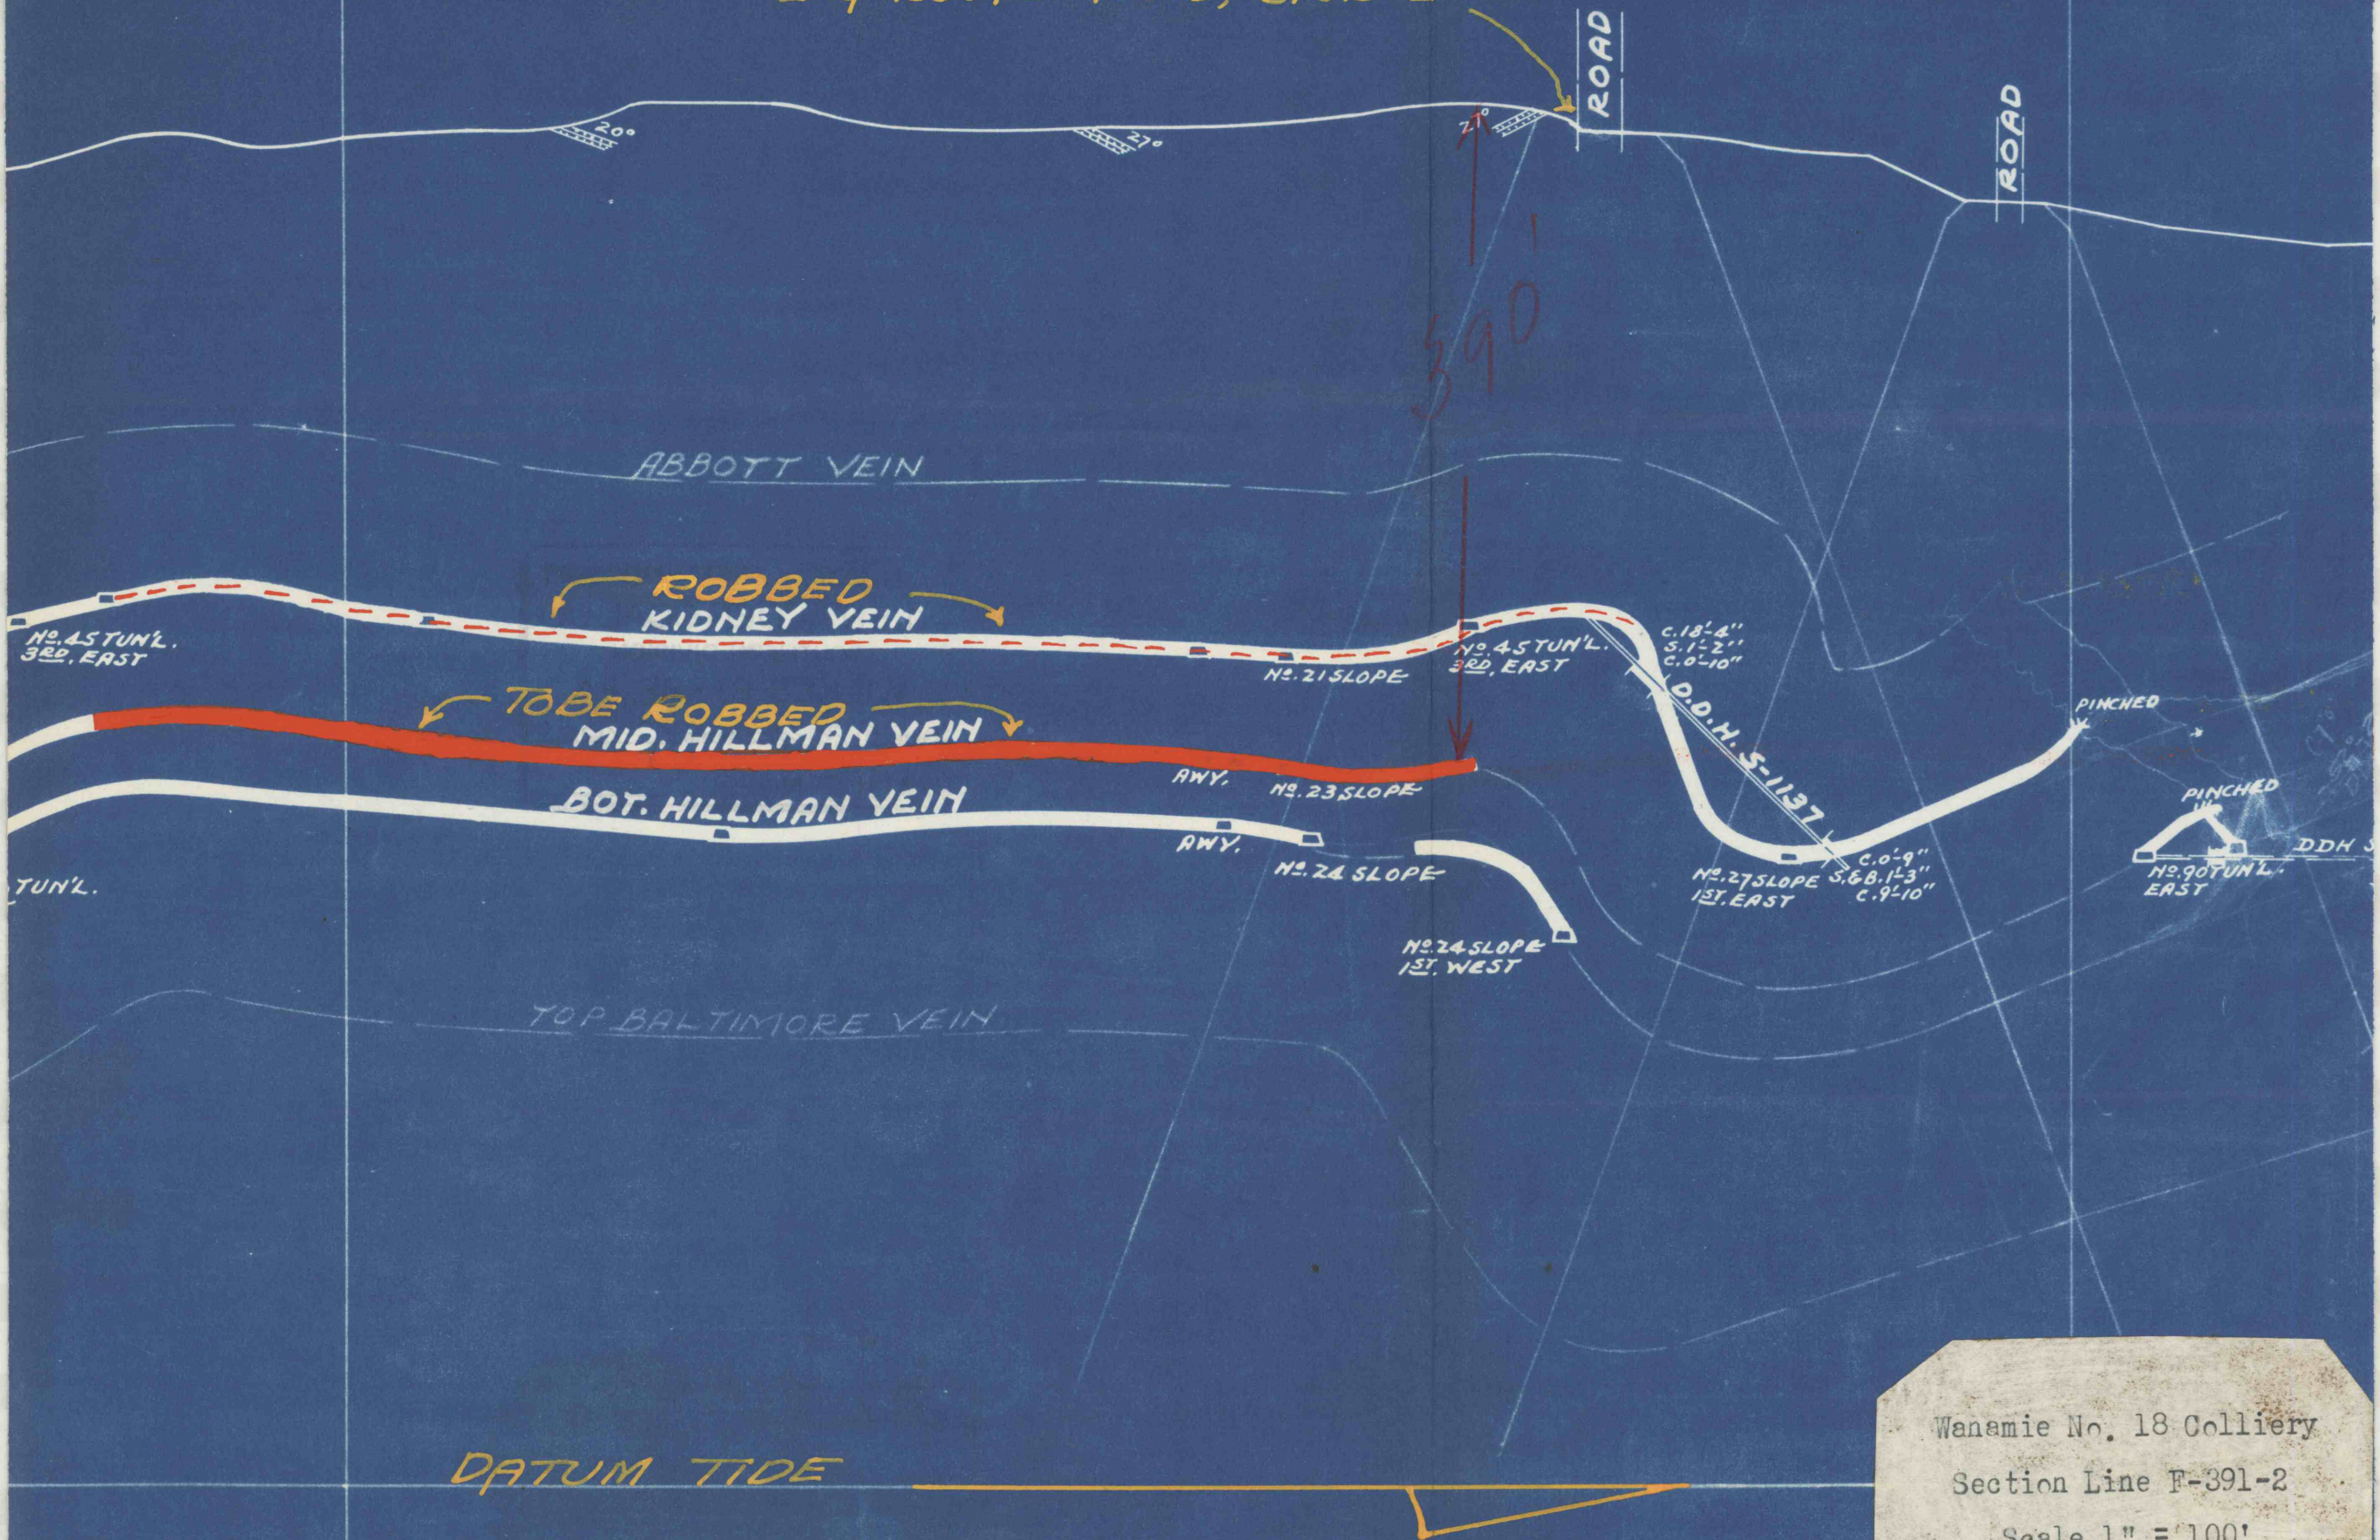

Wanamie No. 18 Colliery
 Section Line F-391-2
 Scale 1" = 100'