


LEG. ROUTE 40033, SPUR "E"

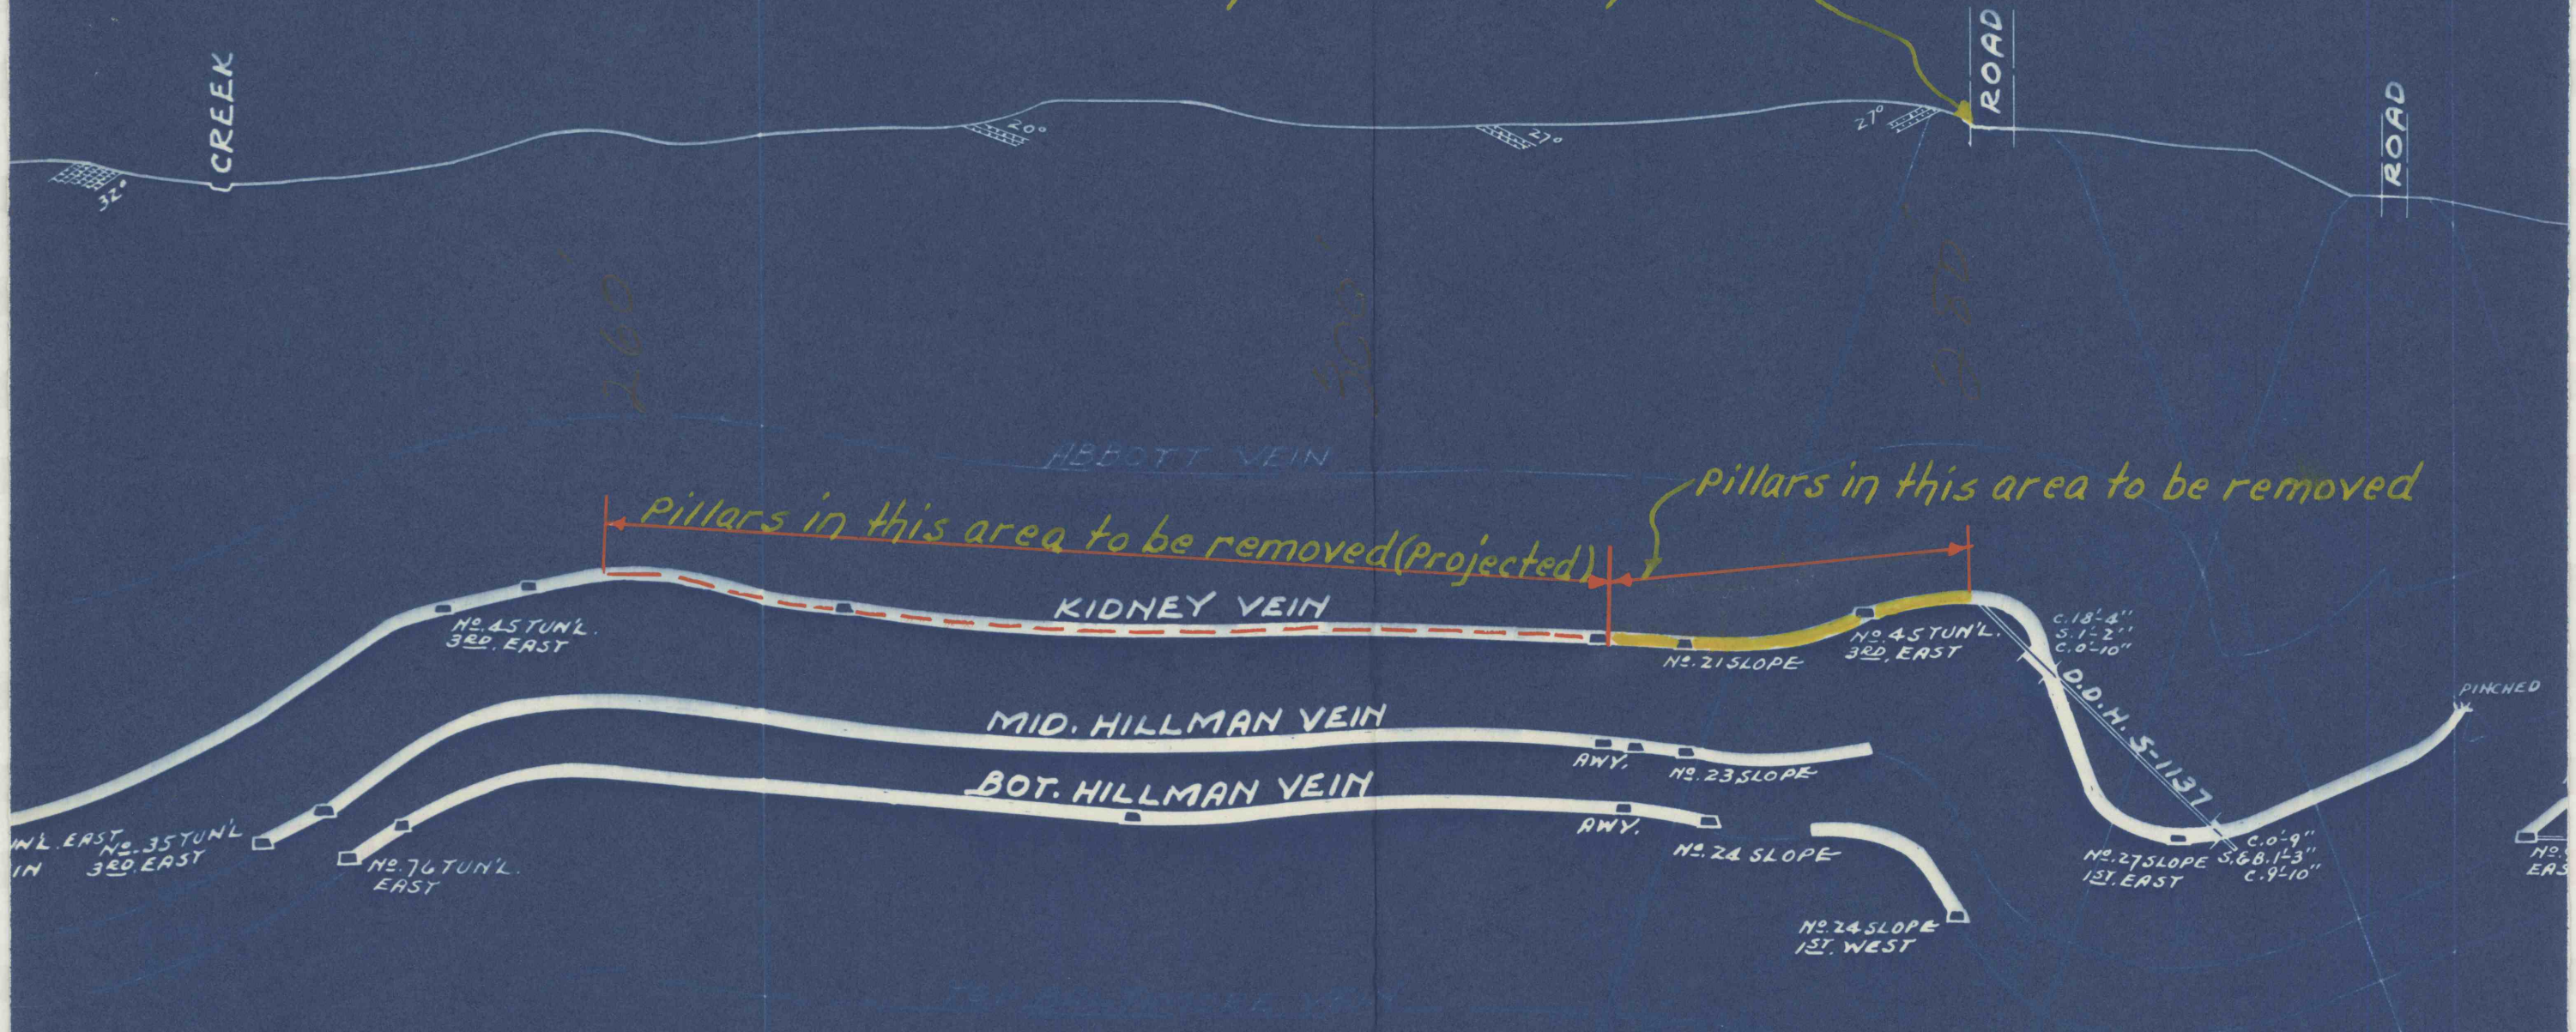

WANAMIE NO. 18 COLLIERY
 SECTION LINE F ~ 391 ~ 2
 SCALE = 1" = 100'

DATUM ~ TIDE ~ 7