


7-1-50  
12-1-50

B-12-20

B-12-20

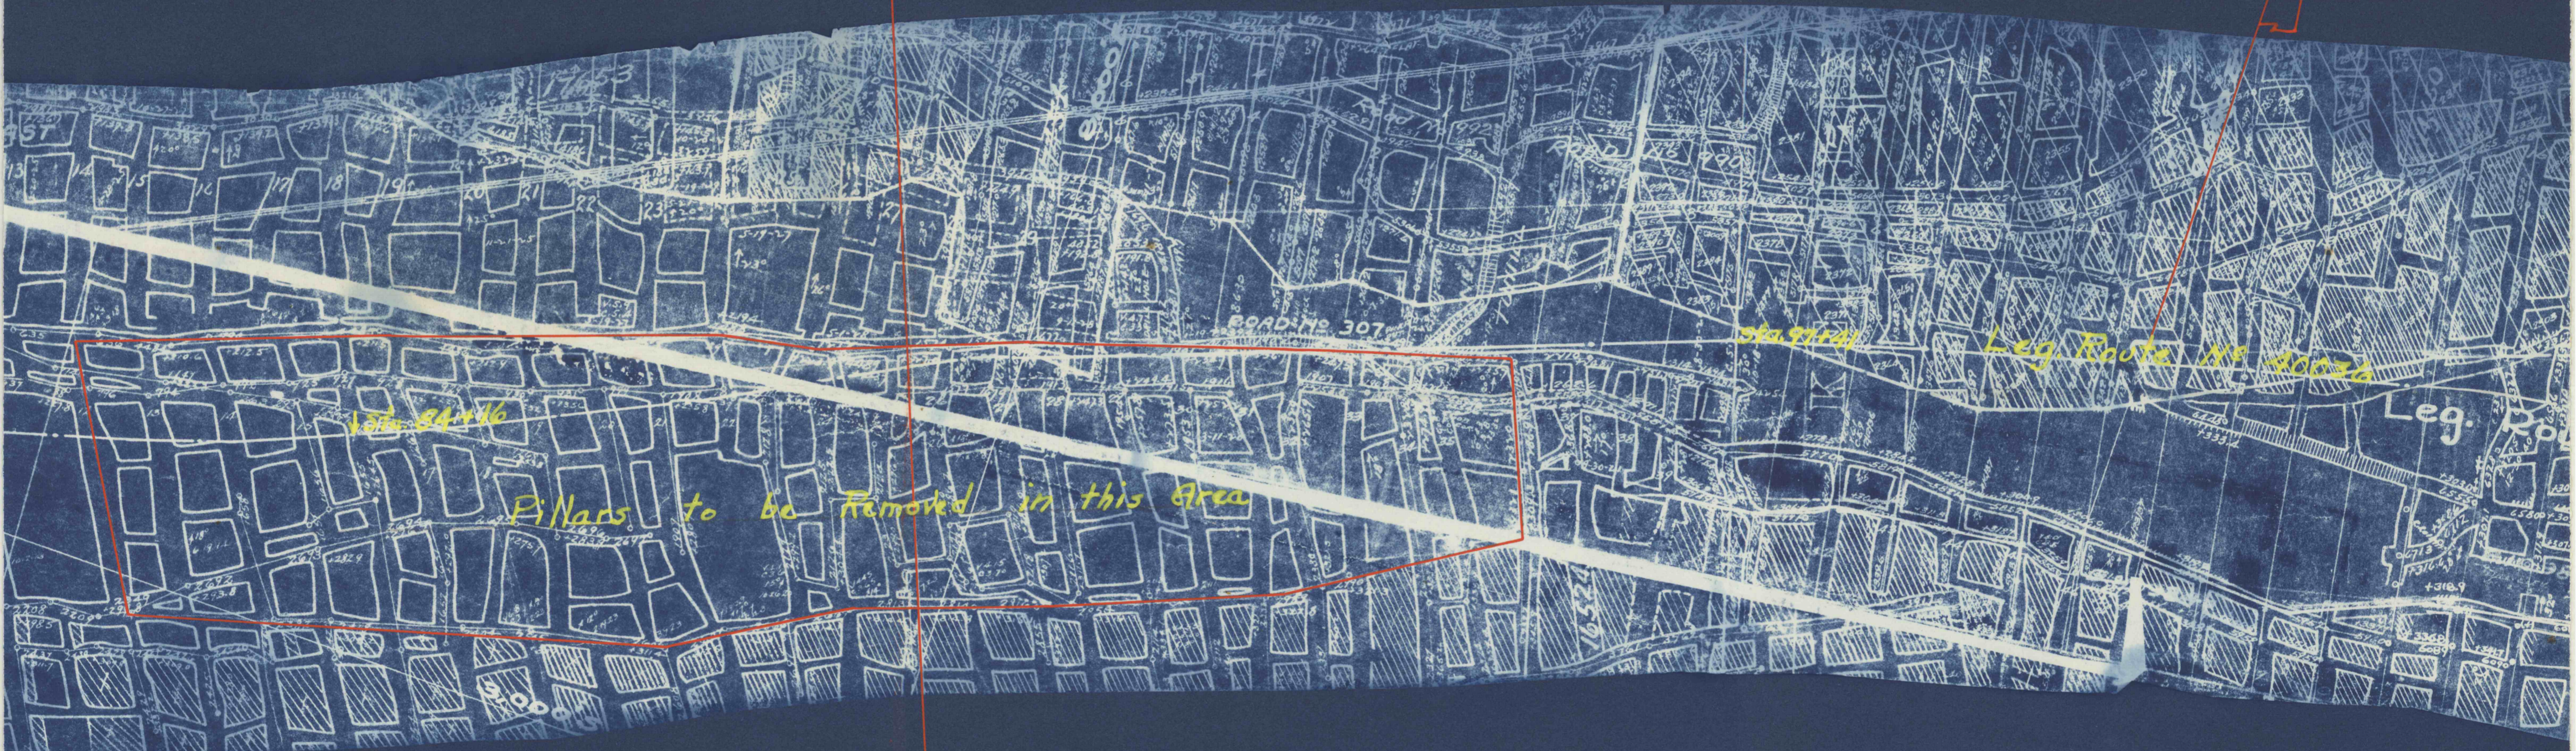


Fillars to be removed in this area




<i>Forge</i>	<i>Vein</i>	<i>Truesdale</i>	<i>Colliery</i>
<i>Glen Alden Coal Co., Scranton, Pa.</i>			<i>Operator</i>
<i>F.E. Kudlich</i>	<i>Mining Engr.</i>		
<i>N.F. Becker</i>	<i>Supt.</i>	<i>Truesdale</i>	<i>Colliery</i>
	<i>Supt.</i>		<i>Colliery</i>
<i>Scale 1"=100'</i>		<i>Date Nov. 27, 1950</i>	