


B-12-20.

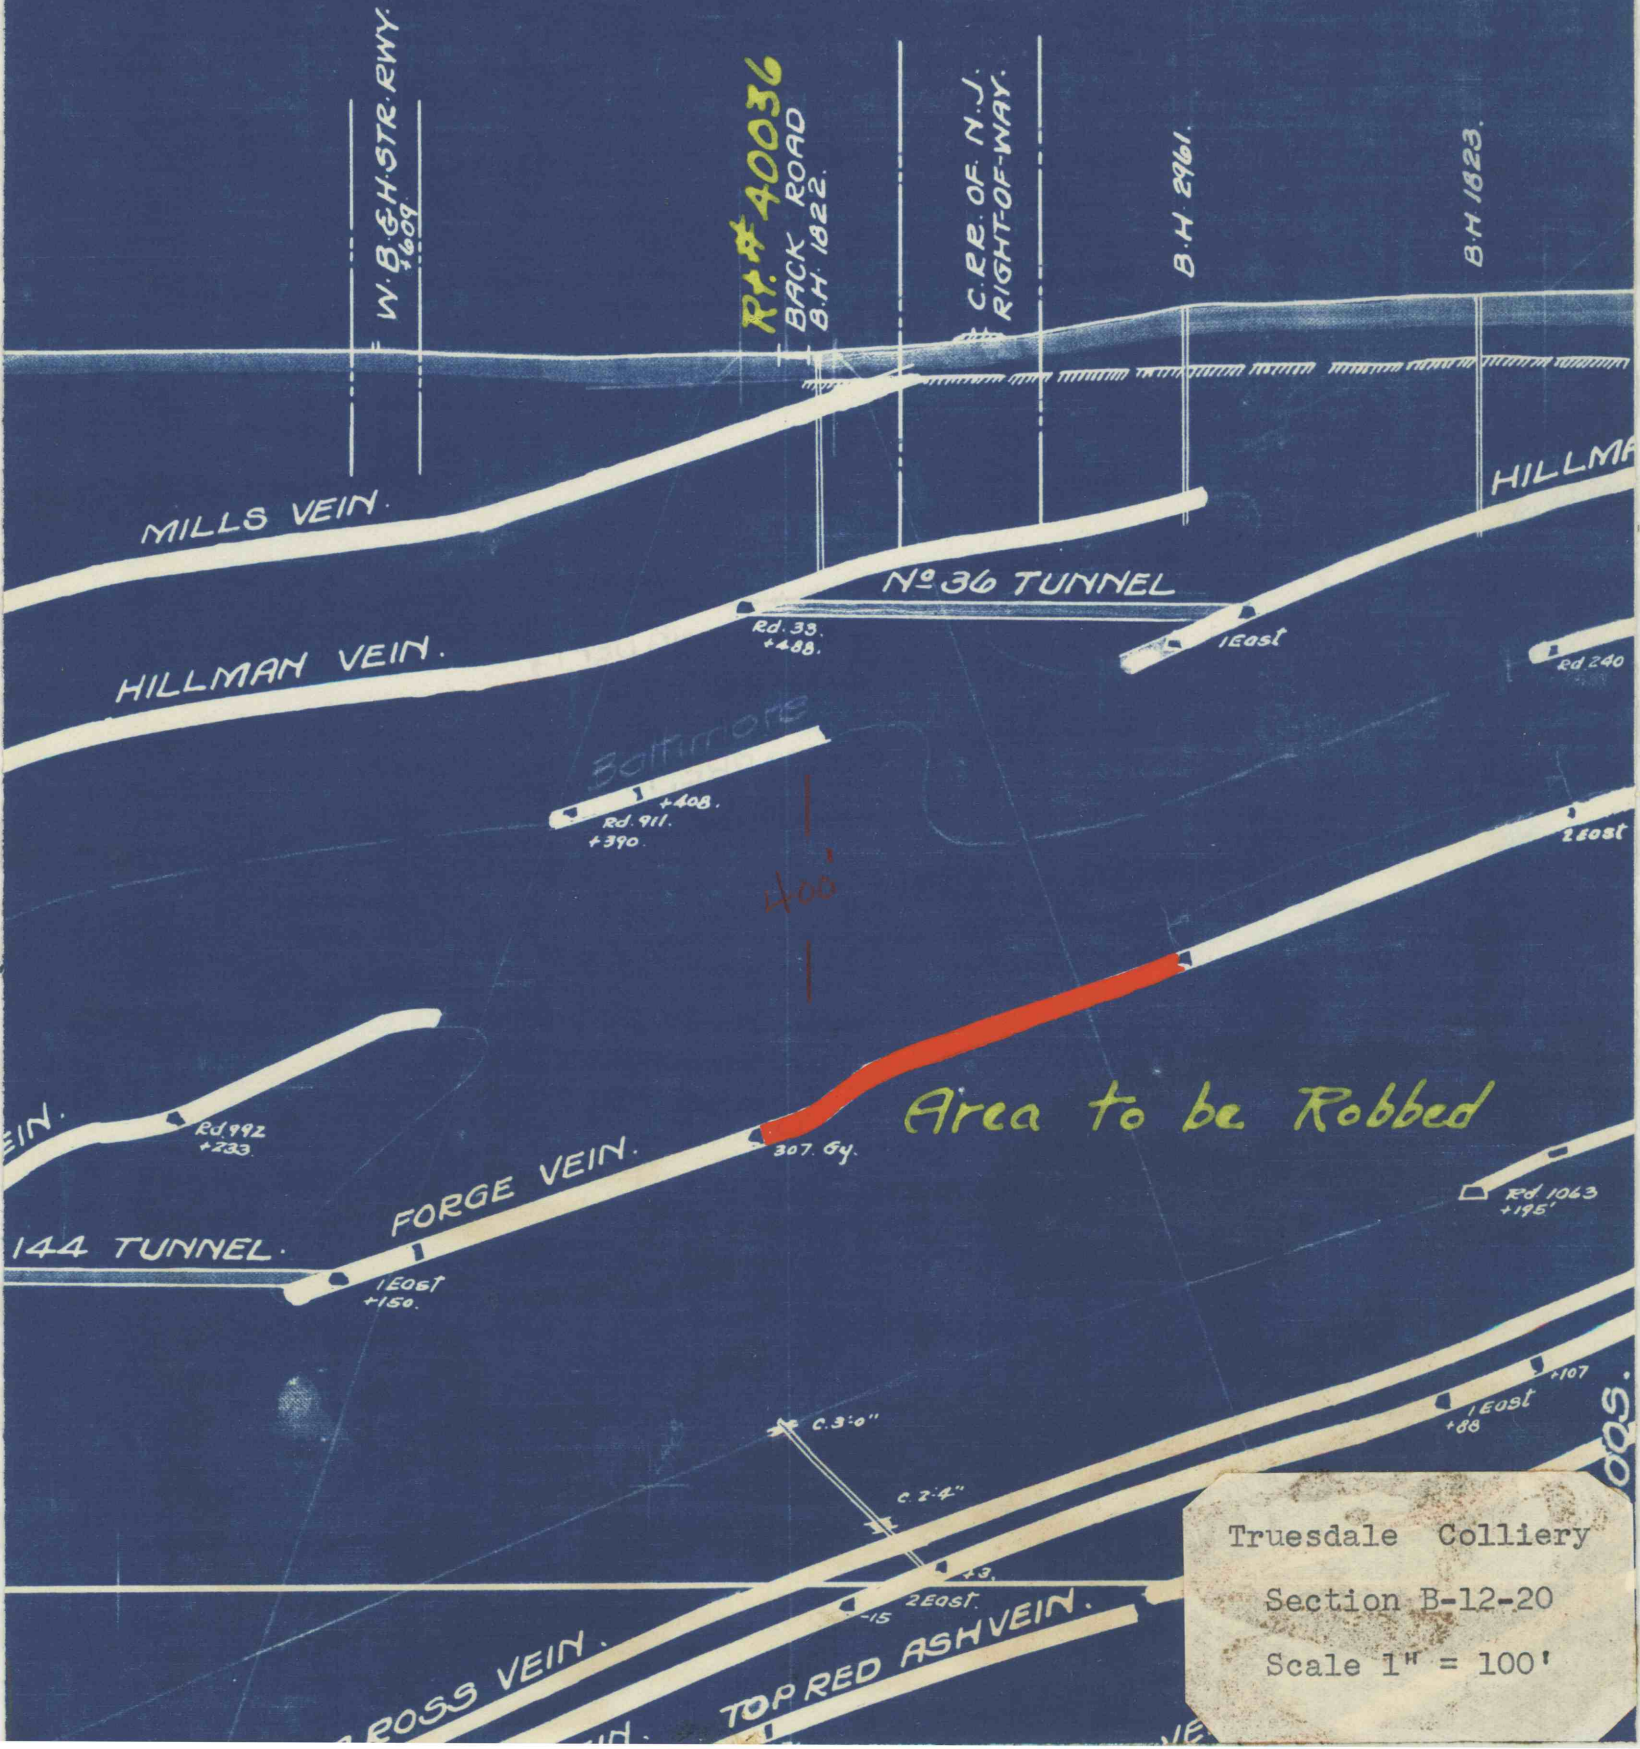

Truesdale Colliery

Section B-12-20

Scale 1" = 100'