


Sta 214+60

1800

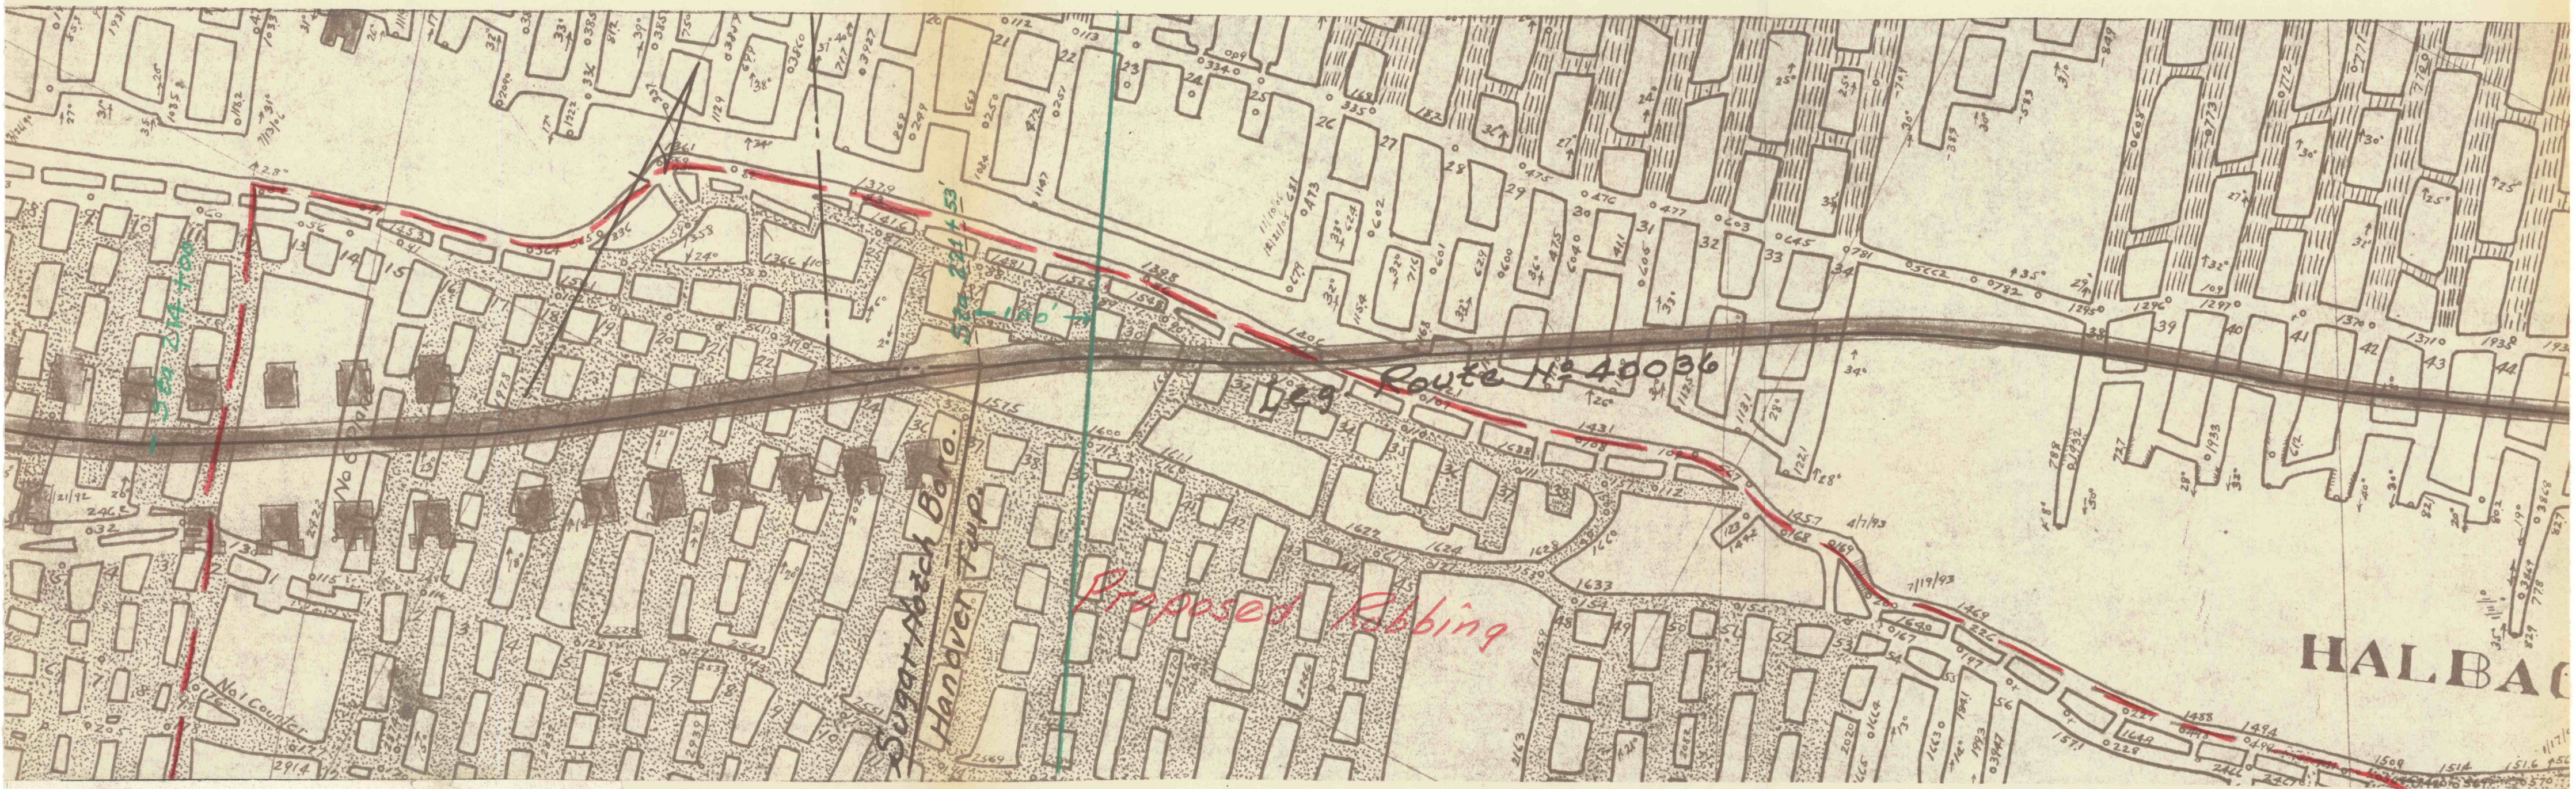

SUGAR NOTCH COLLIERY
BOTTOM RED ASH VEIN

GLEN ALDEN CORPORATION

OPERATOR

E. T. Powell

Mining Engineer

A. F. Kane

General Foreman

SCALE 1" = 100'

SEPTEMBER, 1961