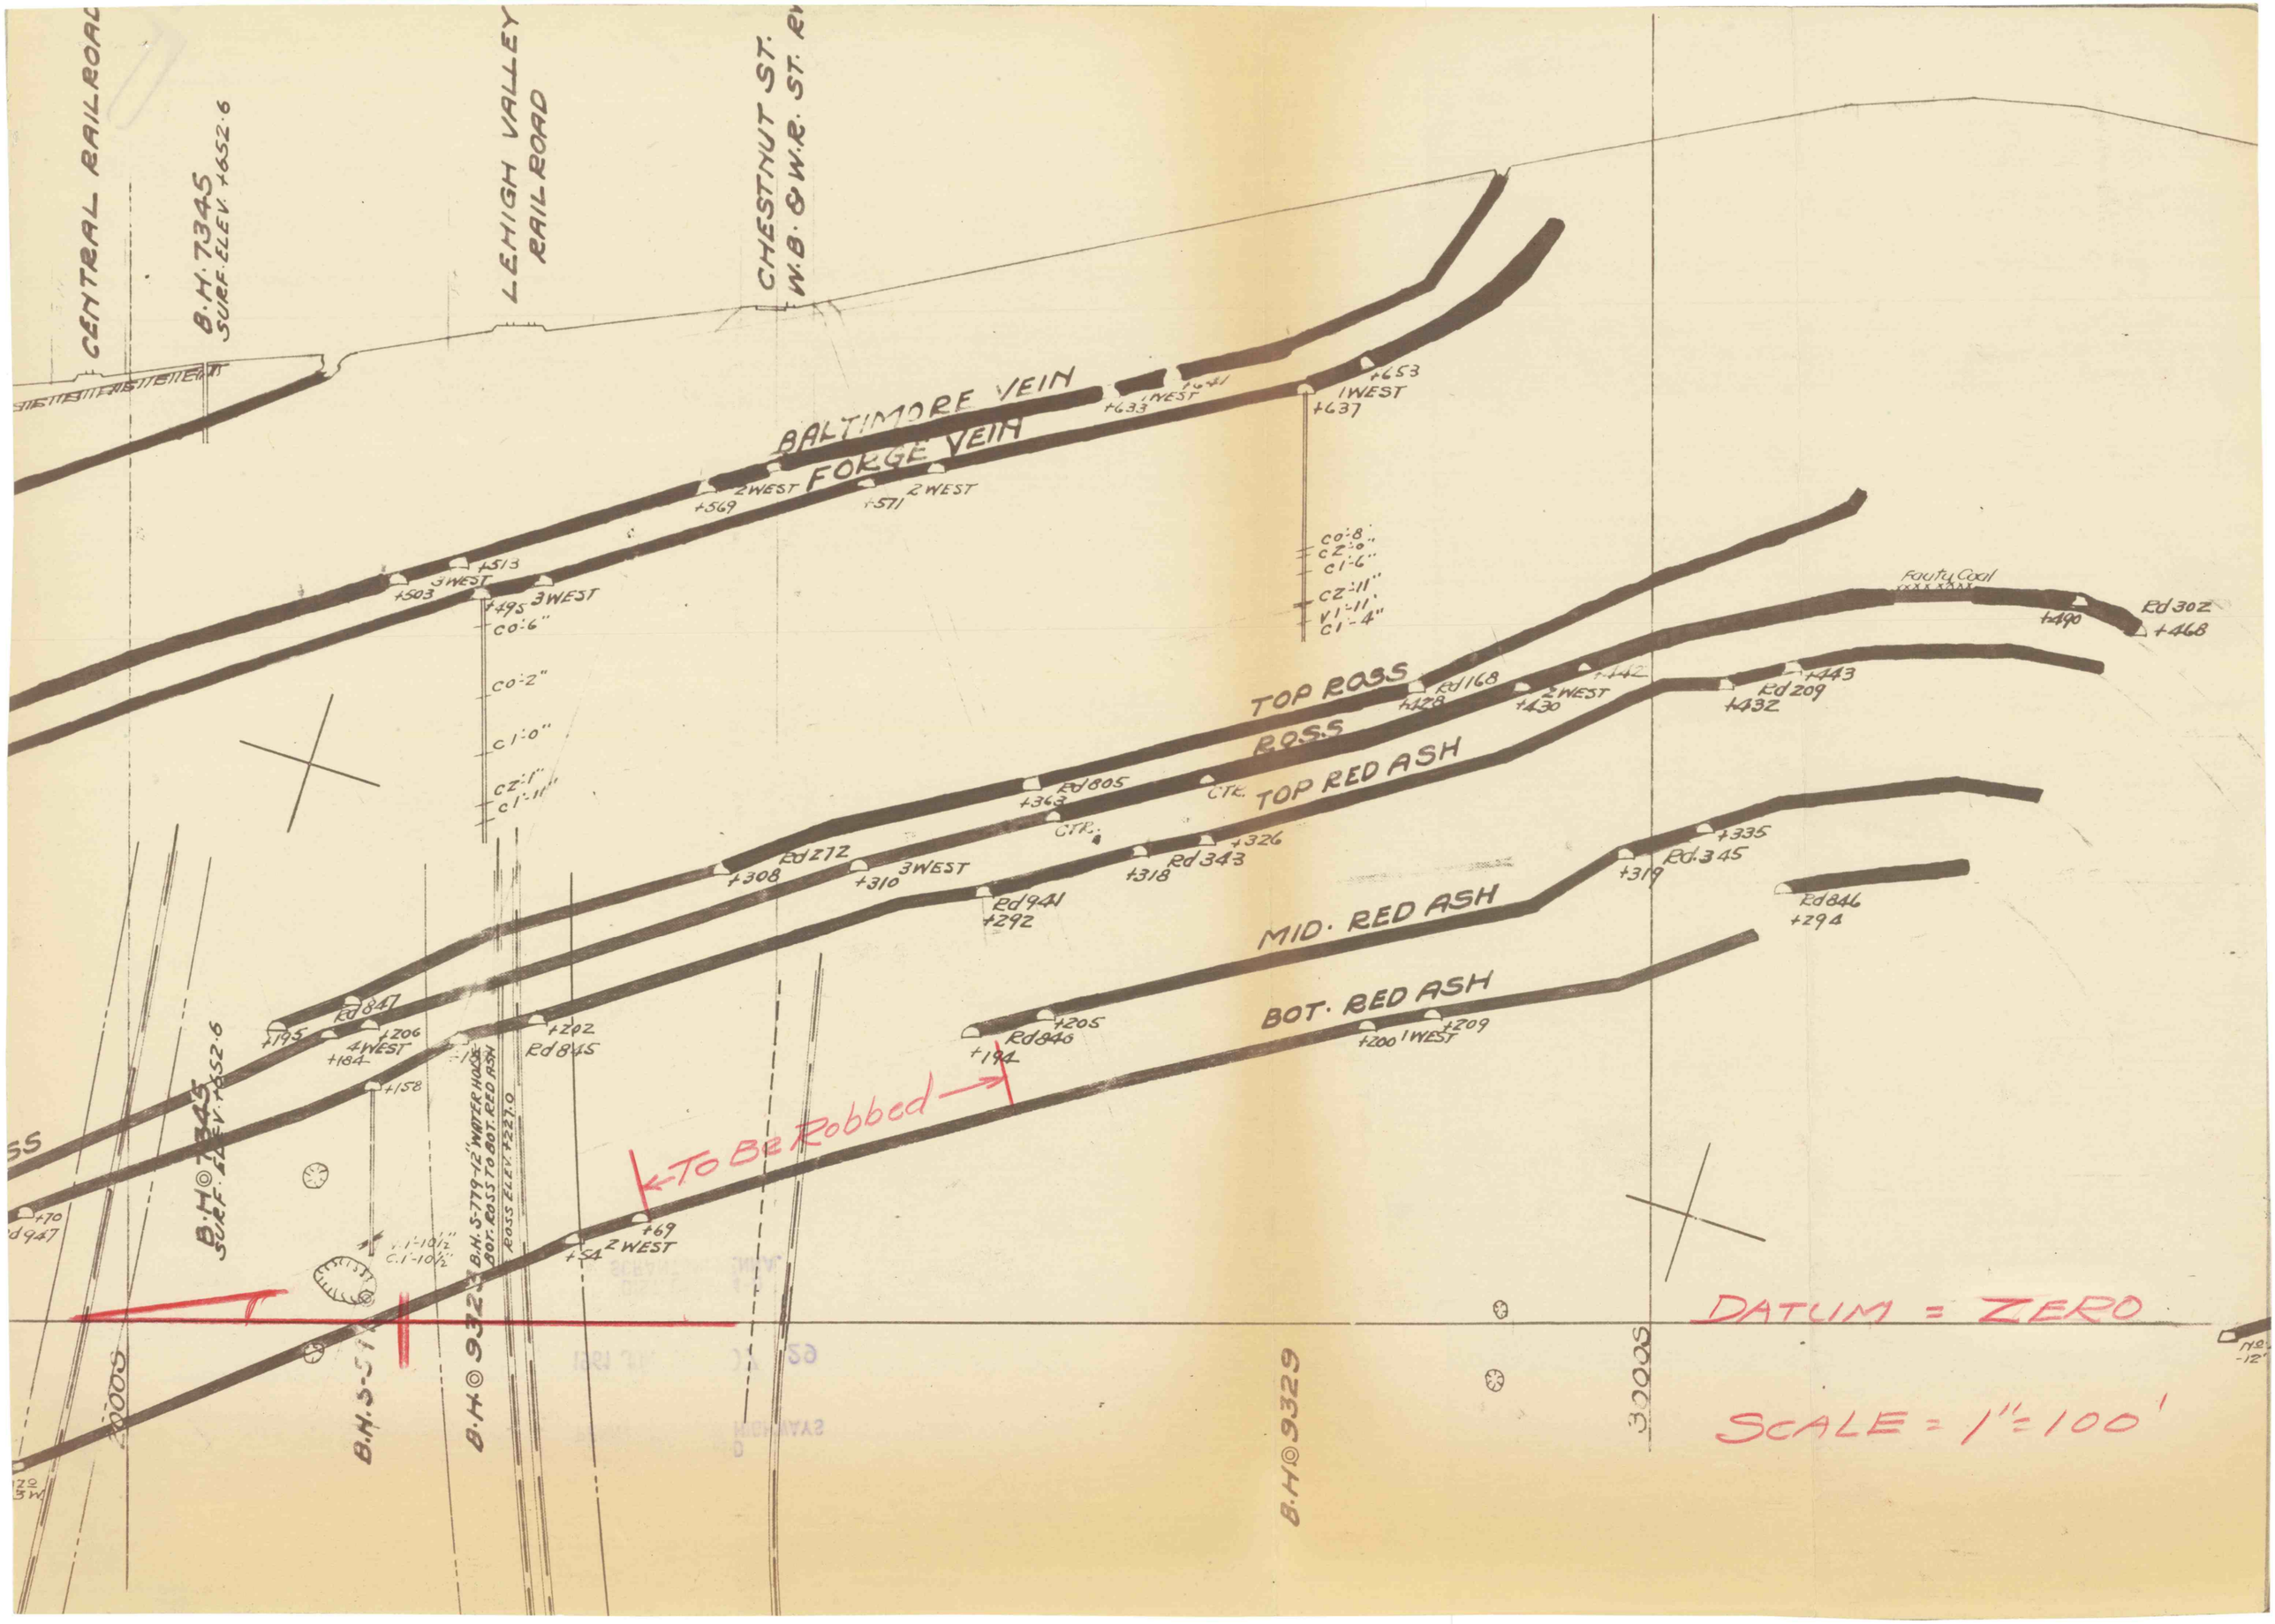
CENTRAL RAILROAD
B.H. 7345
SURF. ELEV. +652.6
LEHIGH VALLEY RAILROAD
CHESTNUT ST.
W.B. & W.R. ST. RY.
BALTIMORE VEIN
FORGE VEIN
TOP ROSS
ROSS
TOP RED ASH
MID. RED ASH
BOT. RED ASH
Faulty Coal
To Be Robbed
DATUM = ZERO
SCALE = 1" = 100'
B.H. 9329
B.H. 9323
B.H. 5-779-12" WATER HOLE
BOT. ROSS TO BOT. RED ASH
ROSS ELEV. +227.0
3000S