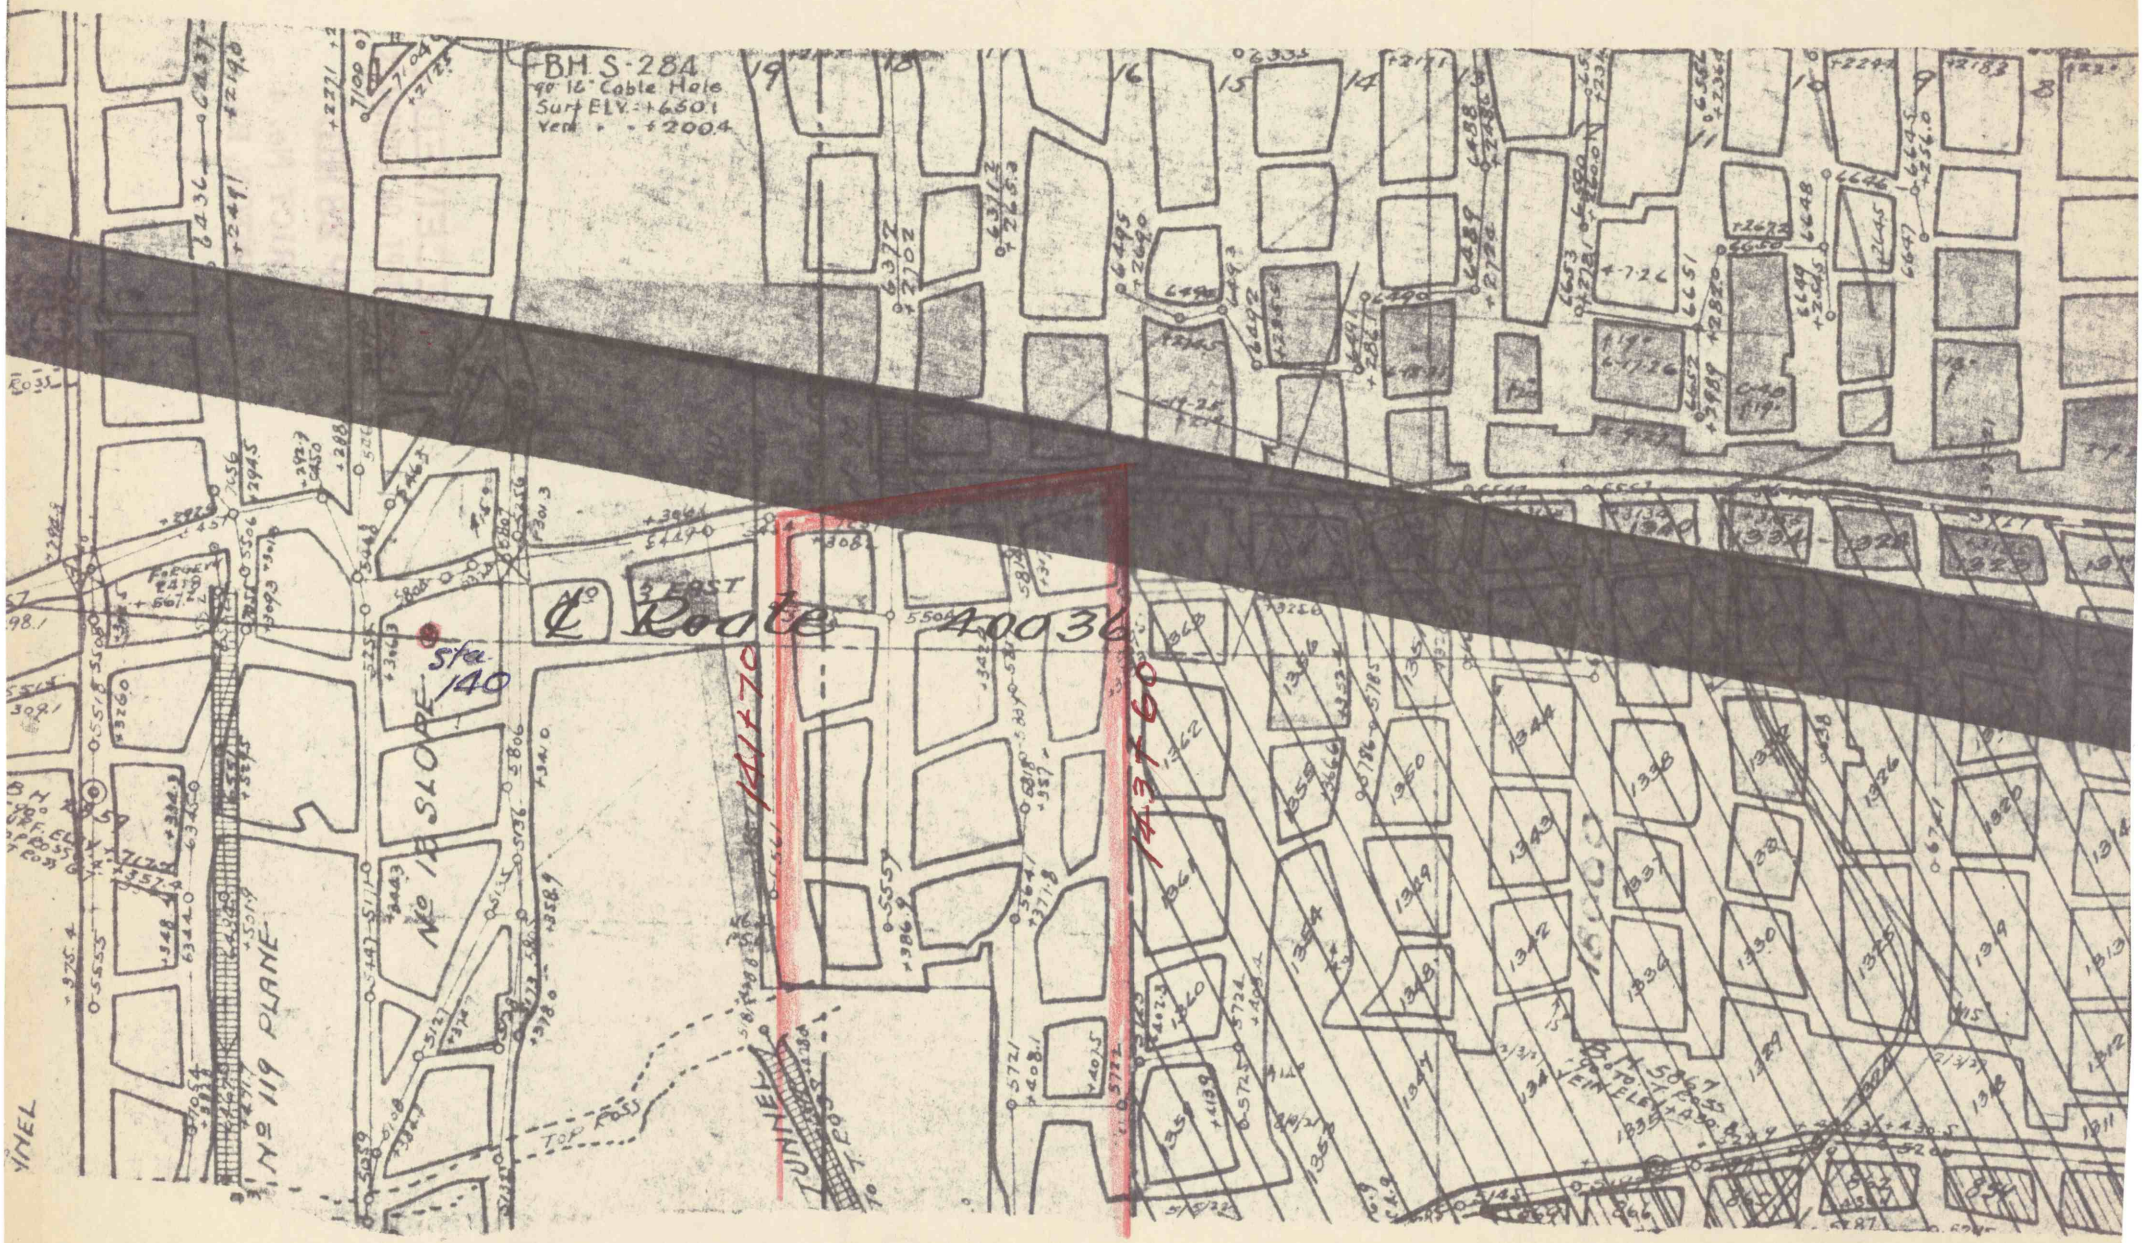

Bottom Ross Vn. Scale 1" = 100'