
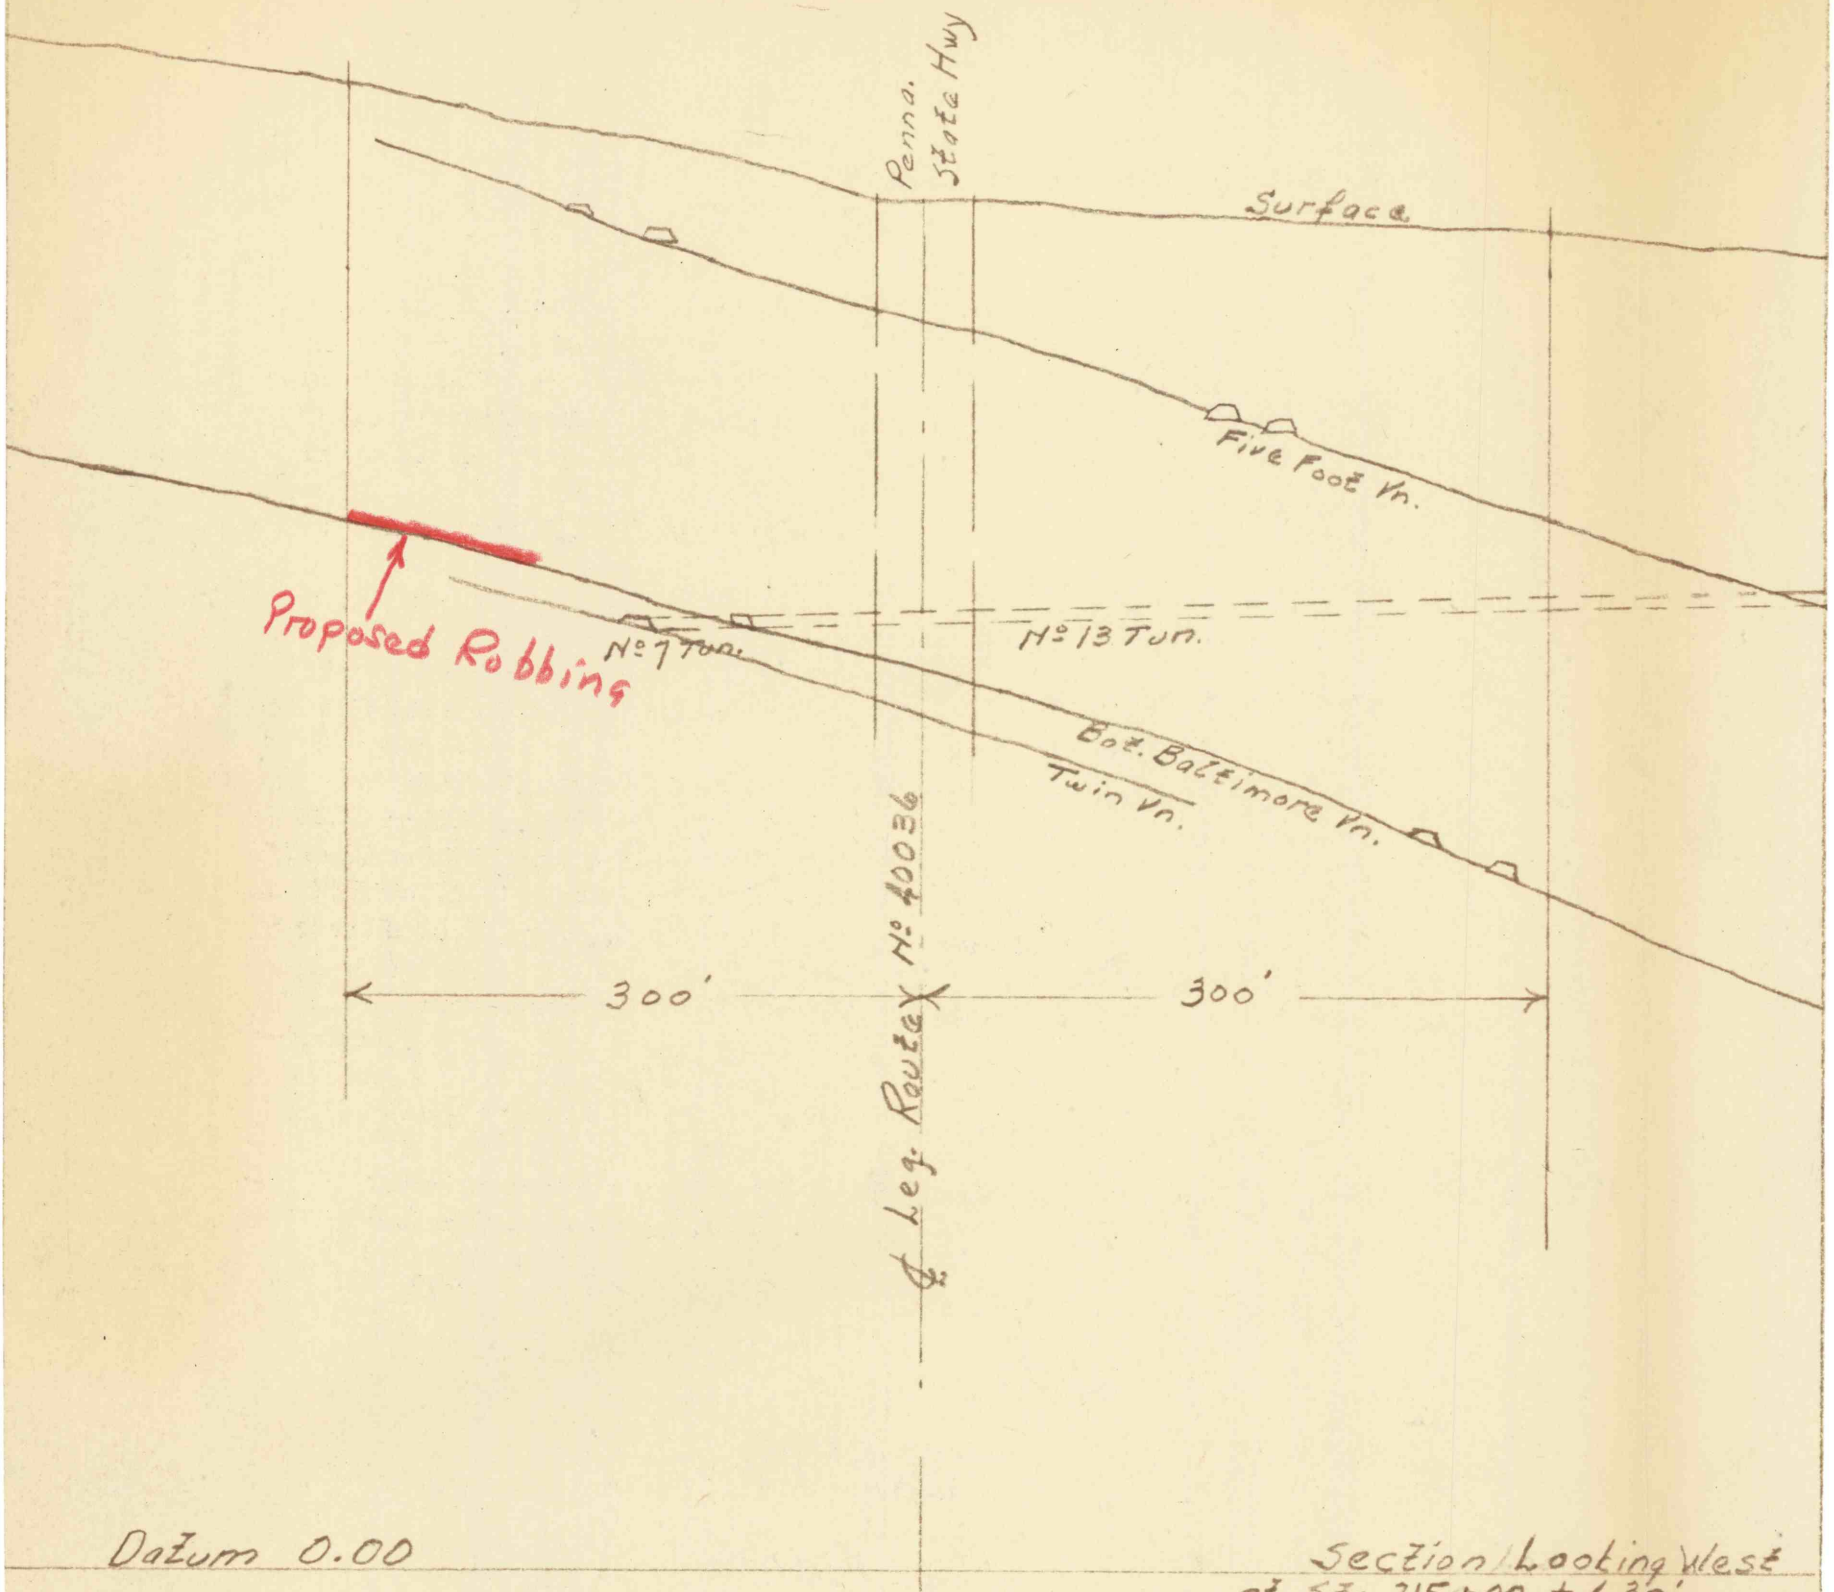


Scale 1"=100'

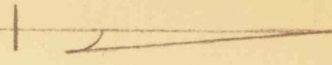

Sugar Notch Colly.  
Scale 1"=100'