


SECTION LINE 12-37

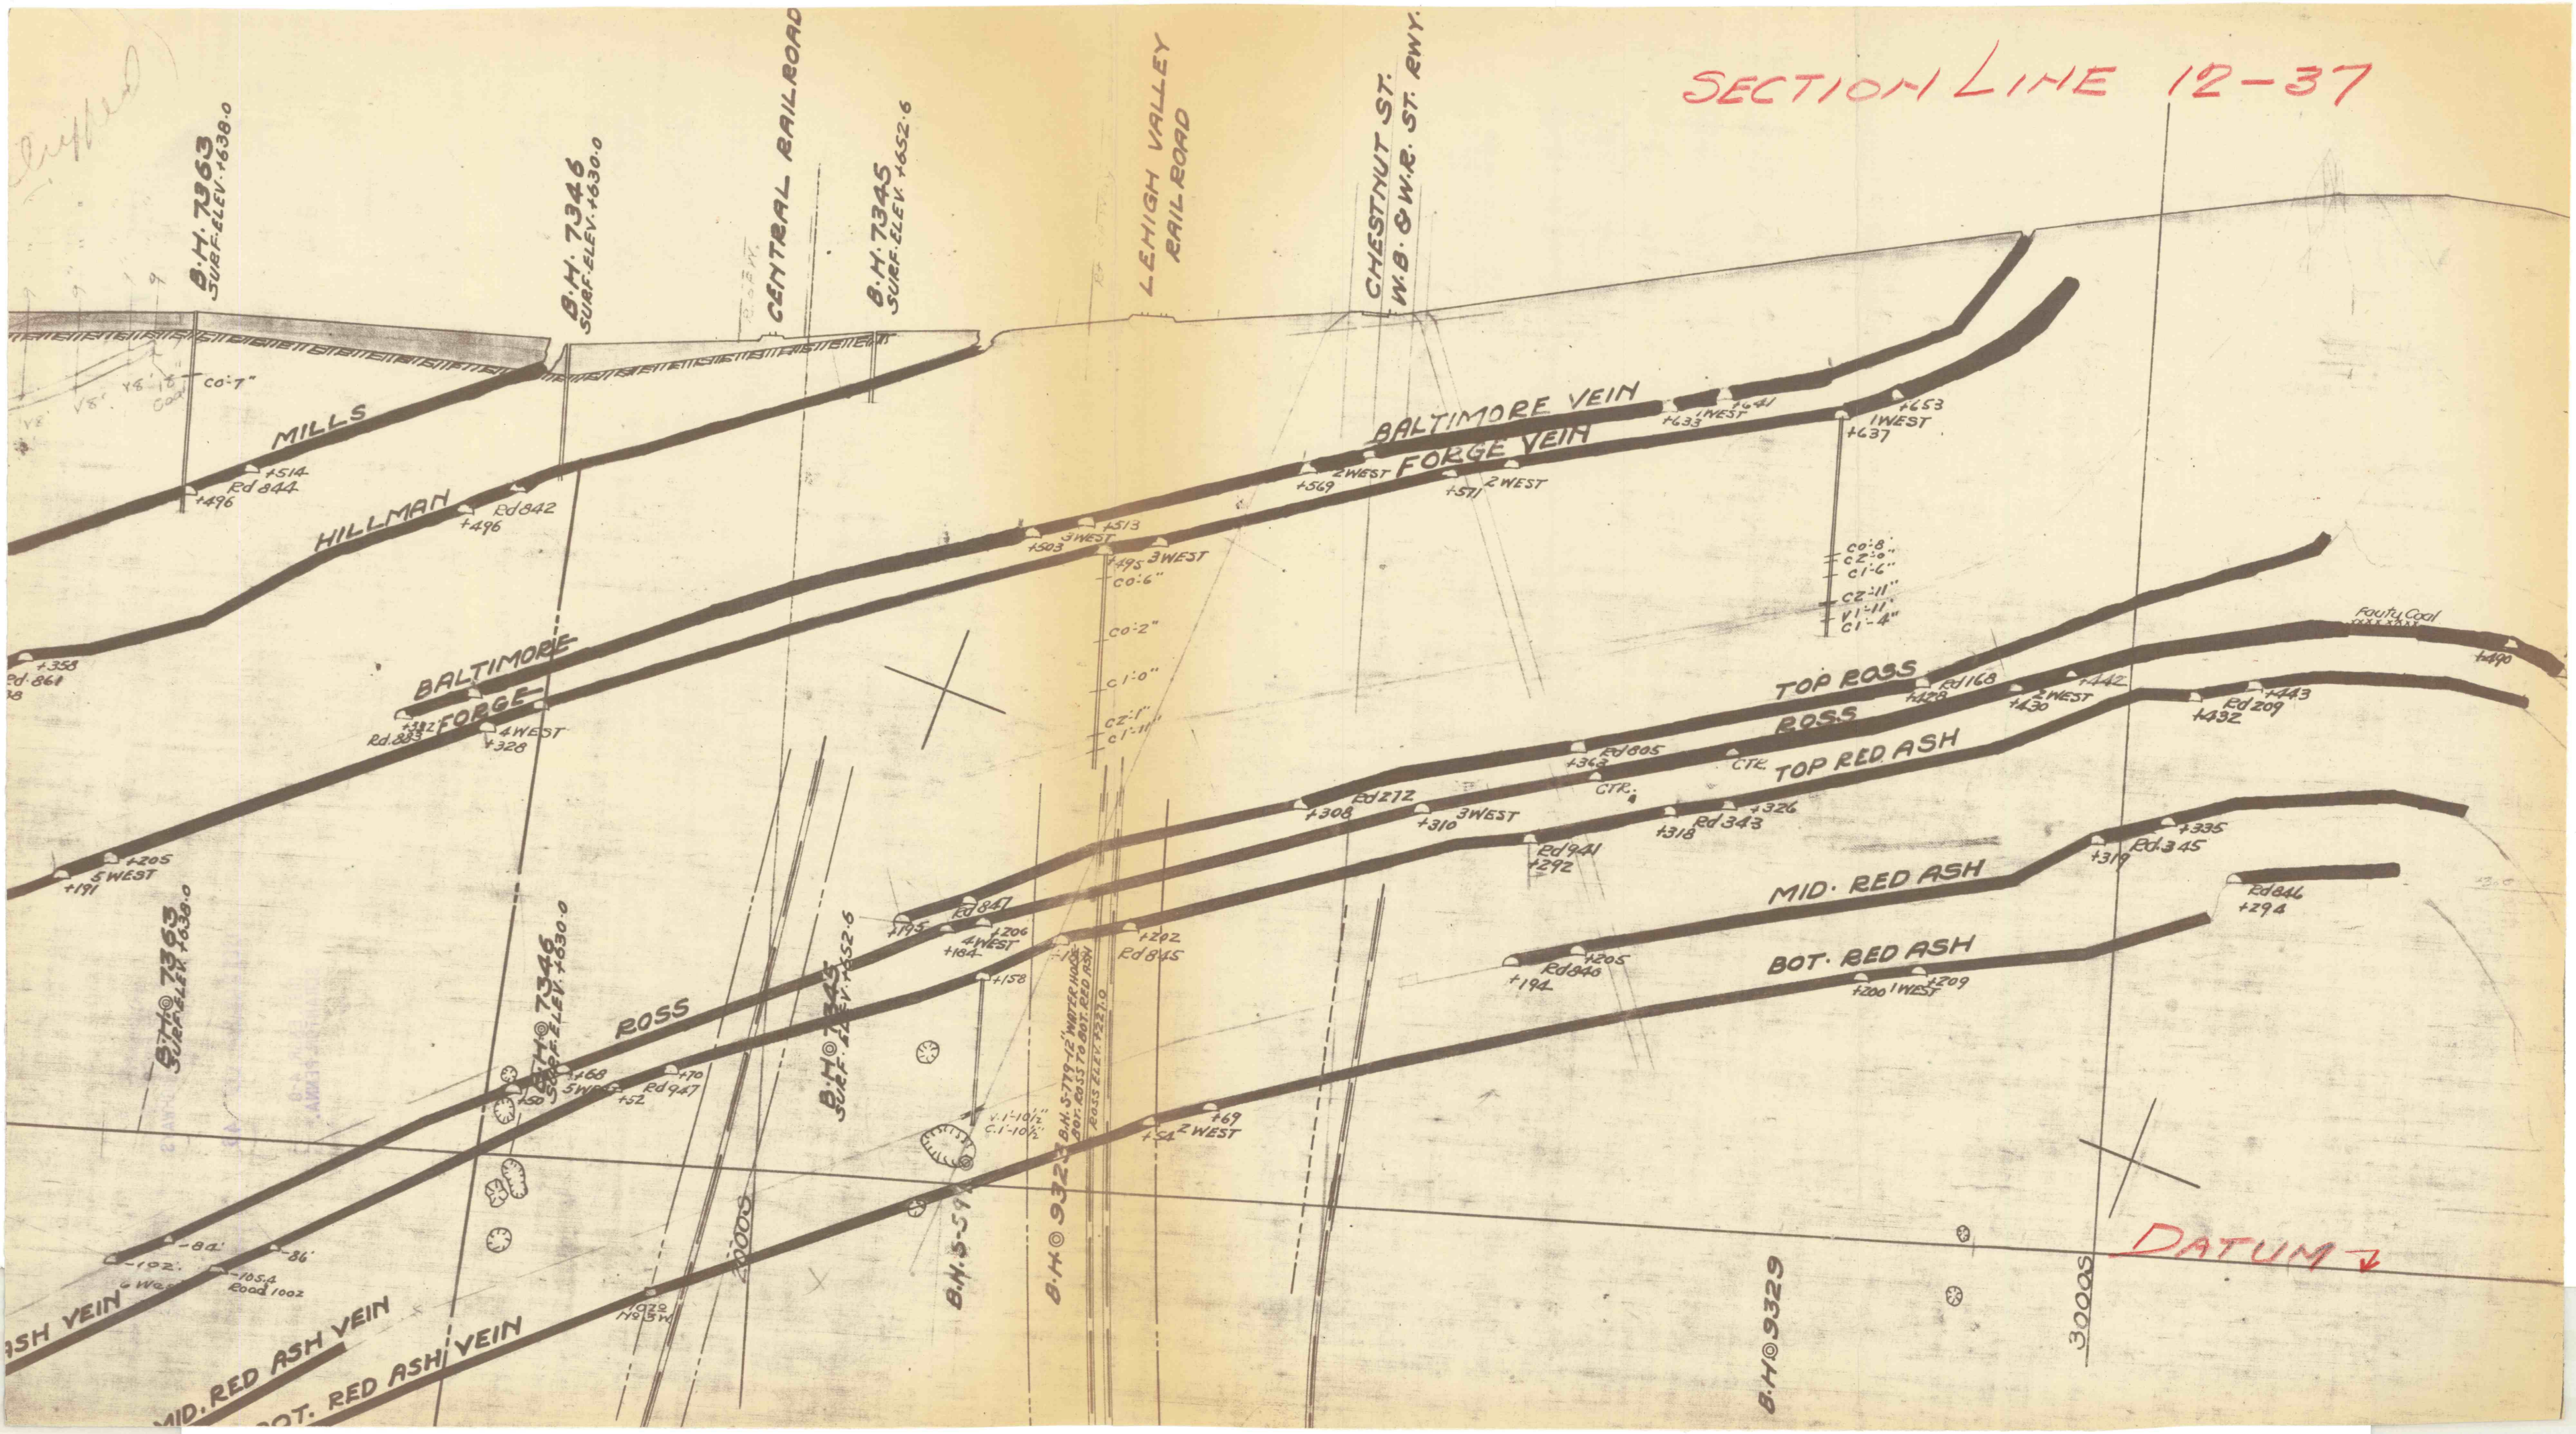

B.M. 7363 SURF. ELEV. 1638.0

B.M. 7346 SURF. ELEV. 1630.0

B.M. 7345 SURF. ELEV. 1652.6

B.M. 7393 SURF. ELEV. 1638.0

B.M. 7346 SURF. ELEV. 1630.0

B.M. 7345 SURF. ELEV. 1652.6

B.M. 5-51

B.M. 9323 B.M. 5779 12' WATER HOOD
TOP. 205 TO BOT. RED ASH
ROSS ELEV. 1227.0

B.M. 9329

DATUM ↓

MILLS

HILLMAN

BALTIMORE
FORGE

BALTIMORE VEIN
FORGE VEIN

TOP ROSS
ROSS

TOP RED ASH

MID. RED ASH

BOT. RED ASH

ASH VEIN
MID. RED ASH VEIN
BOT. RED ASH VEIN

CENTRAL RAILROAD

LEMIGH VALLEY RAILROAD

CHESTNUT ST. W.B. & W.R. ST. RWY.

CO: 8"
CZ: 6"
C1: 6"
CZ: 11"
V1: 11"
C1: 4"

Forty Coal

30005