


CENTRAL RAILROAD  
B.M. 7342  
SURF. ELEV. +660.8

LEHIGH VALLEY  
RAILROAD  
+672.0

CHESTNUT ST.  
W.B. & W.R. R.W.Y.  
+693.0

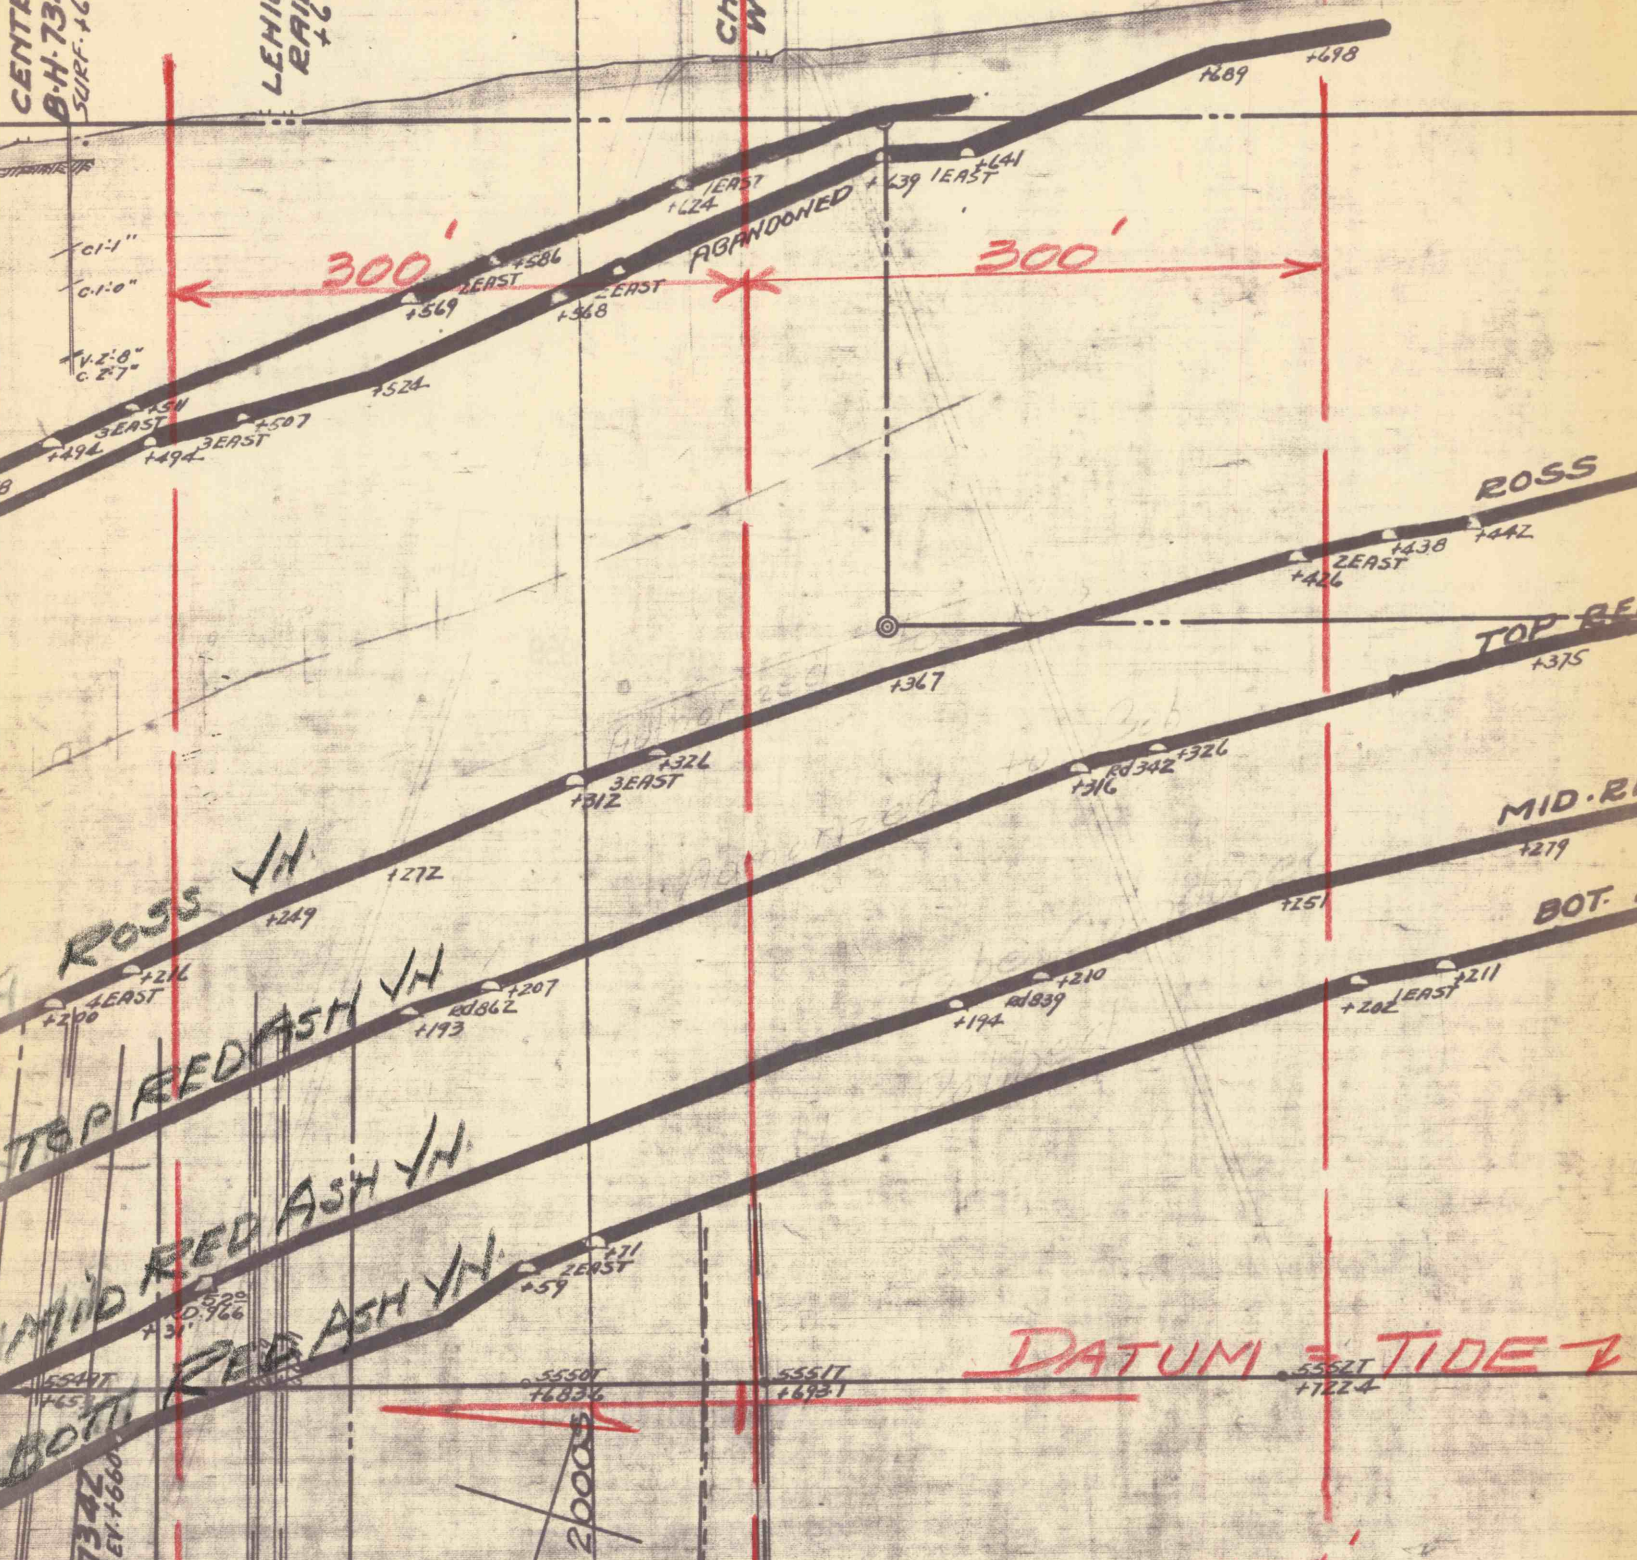

SECTION STA. 143 + 224'  
SCALE 1" = 100'

B.M. 7342  
SURF. ELEV. +660.8