

BOTTOM RED ASH VEIN

TRUESDALE COLLIERY  
NO. 20 SLOPE SECTION

GLEN ALDEN CORPORATION, WILKES-BARRE, PA. - OPERATOR

E. T. POWELL - MINING ENGINEER

J. L. REYNOLDS - SUPT.


TRUESDALE COLLIERY

R. L. DOUGHERTY - SUPT.

PEELEY MINING COMPANY

SCALE 1" = 100'

DATE FEBRUARY 13, 1957

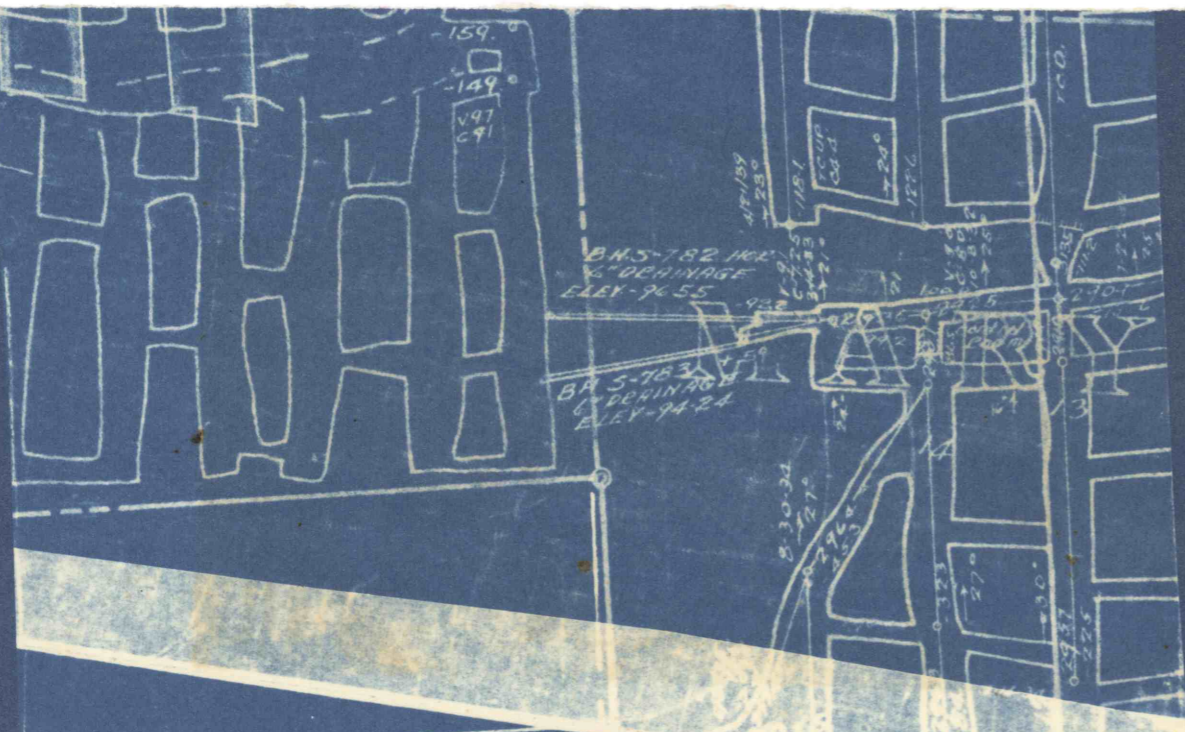

*Pillars to be removed*