


CENTRAL RAILROAD  
B.M. 7342  
SURF. ELEV. +660.8

LEHIGH VALLEY  
RAILROAD  
+672.0

CHESTNUT ST.  
W.B. & W.B. RWY  
+693.0

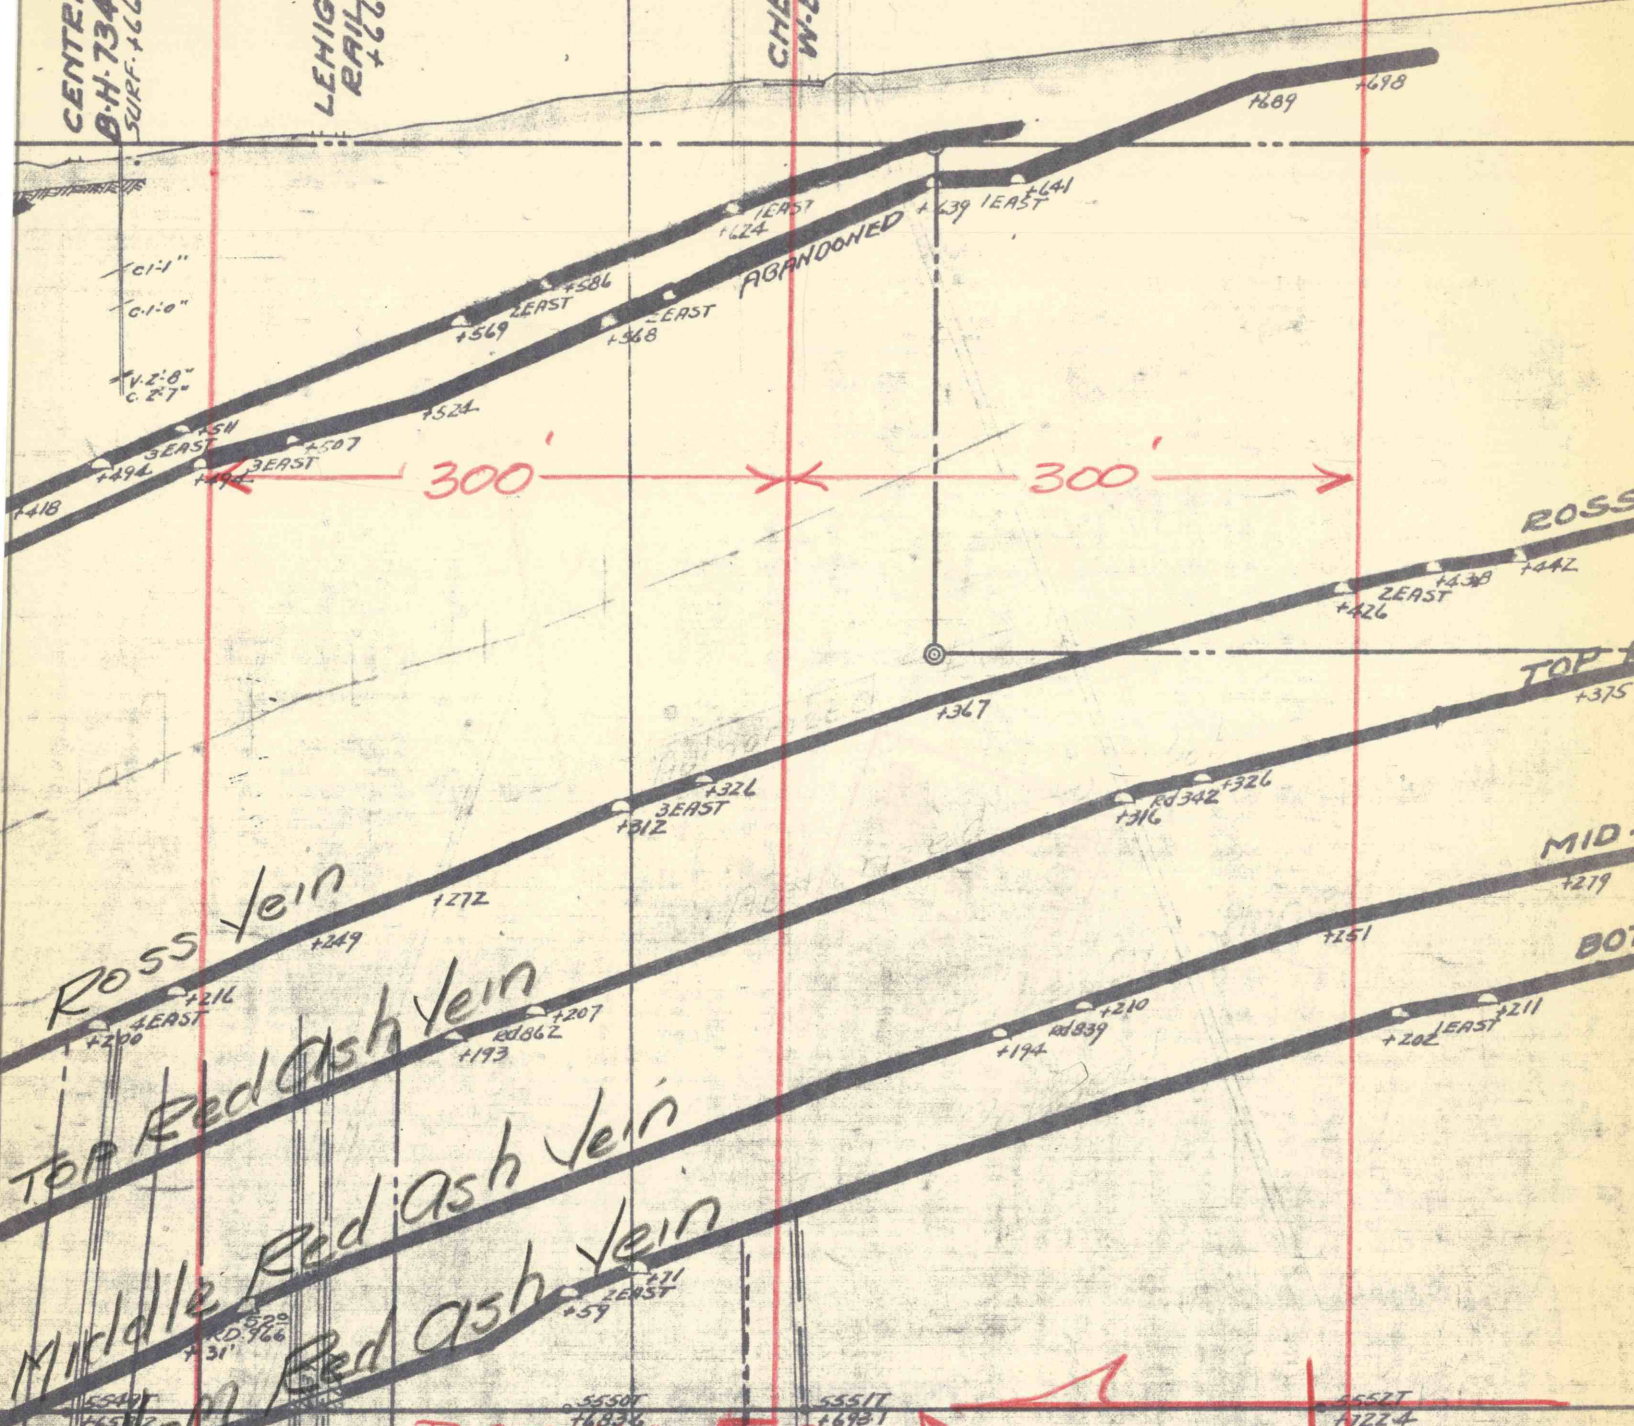

Section Line Sta. 145+20  
Looking East  
Scale 1" = 100' - May 1959