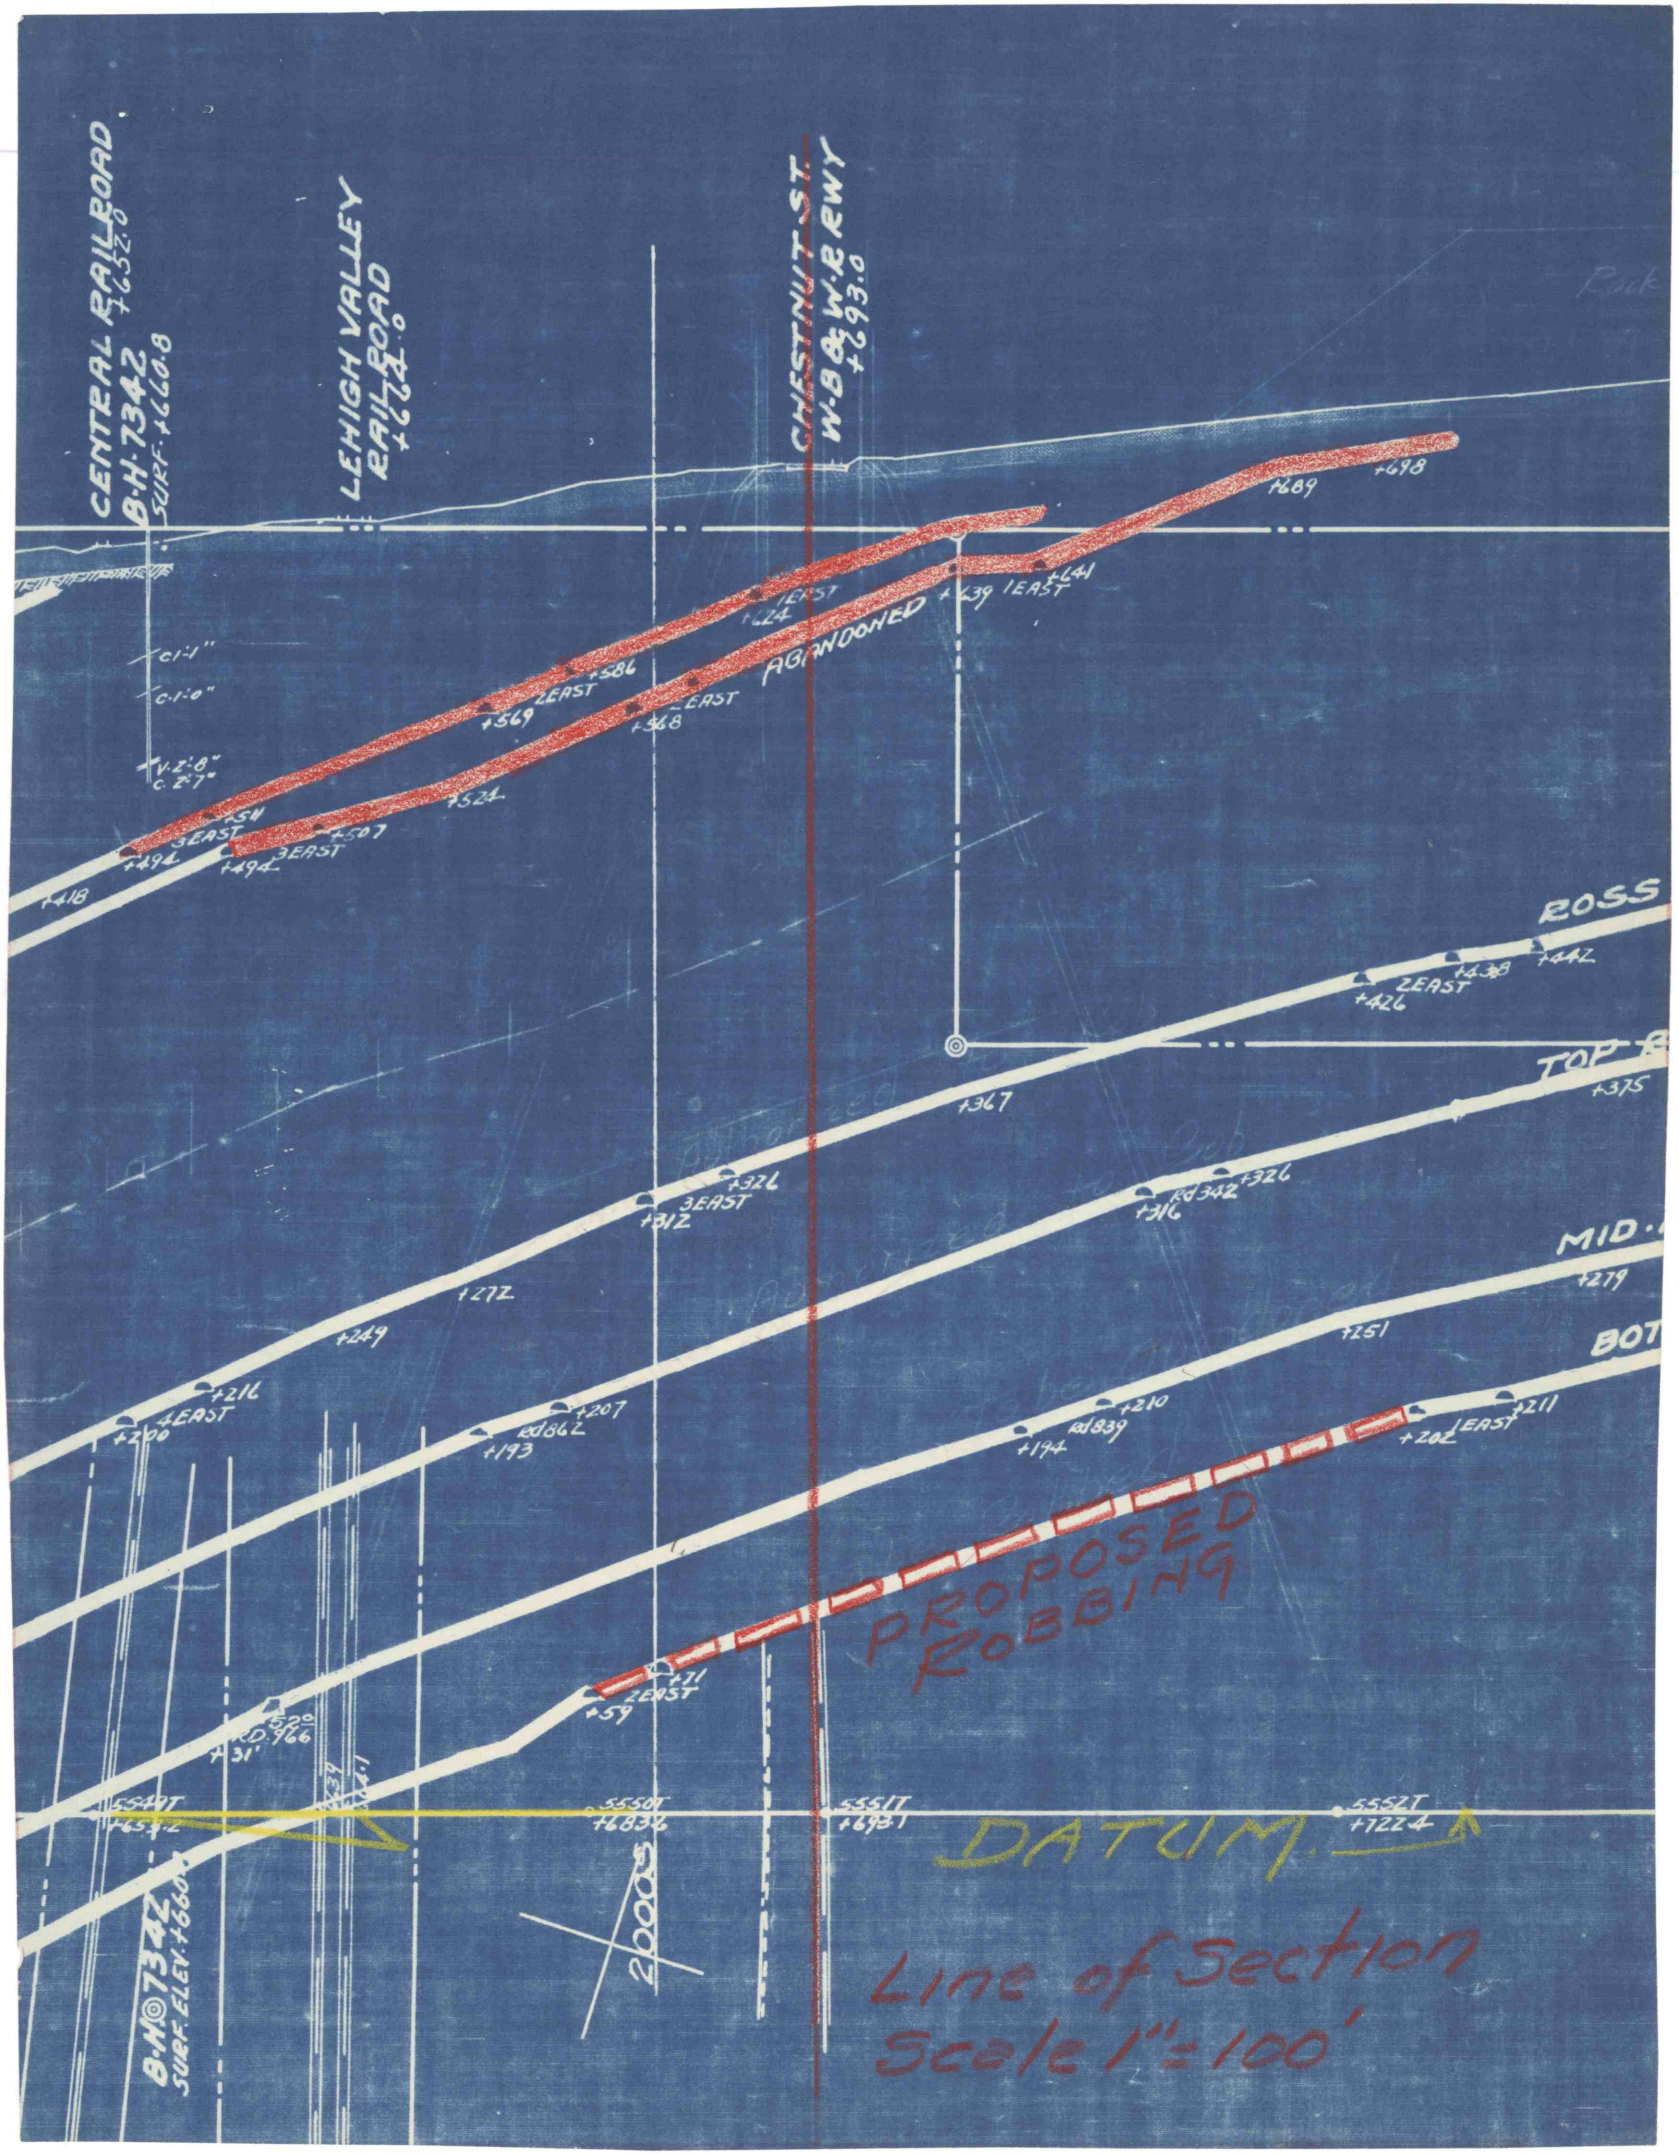
CENTRAL RAILROAD
B.H. 7342
SURF. +660.8
+652.8
LEHIGH VALLEY
RAILROAD
+722.0
CHESTNUT ST.
W.B. & W.E. RWY
+693.0
ABANDONED
+689
+698
+641
+639
+624
+586
+569
+568
+524
+507
+494
+418
ROSS
+442
+438
+426
TOP
+375
+367
+326
+312
+342
+316
MID.
+279
+272
+251
+249
+216
+200
+207
+193
+210
+194
+211
+202
PROPOSED
ROBBING
+71
+59
+31
555OT
+653.2
555OT
+683.6
555IT
+698.1
555ZT
+722.4
DATUM
B.M. 7342
SURF. ELEV. +660.8
200'
Line of Section
Scale 1" = 100'