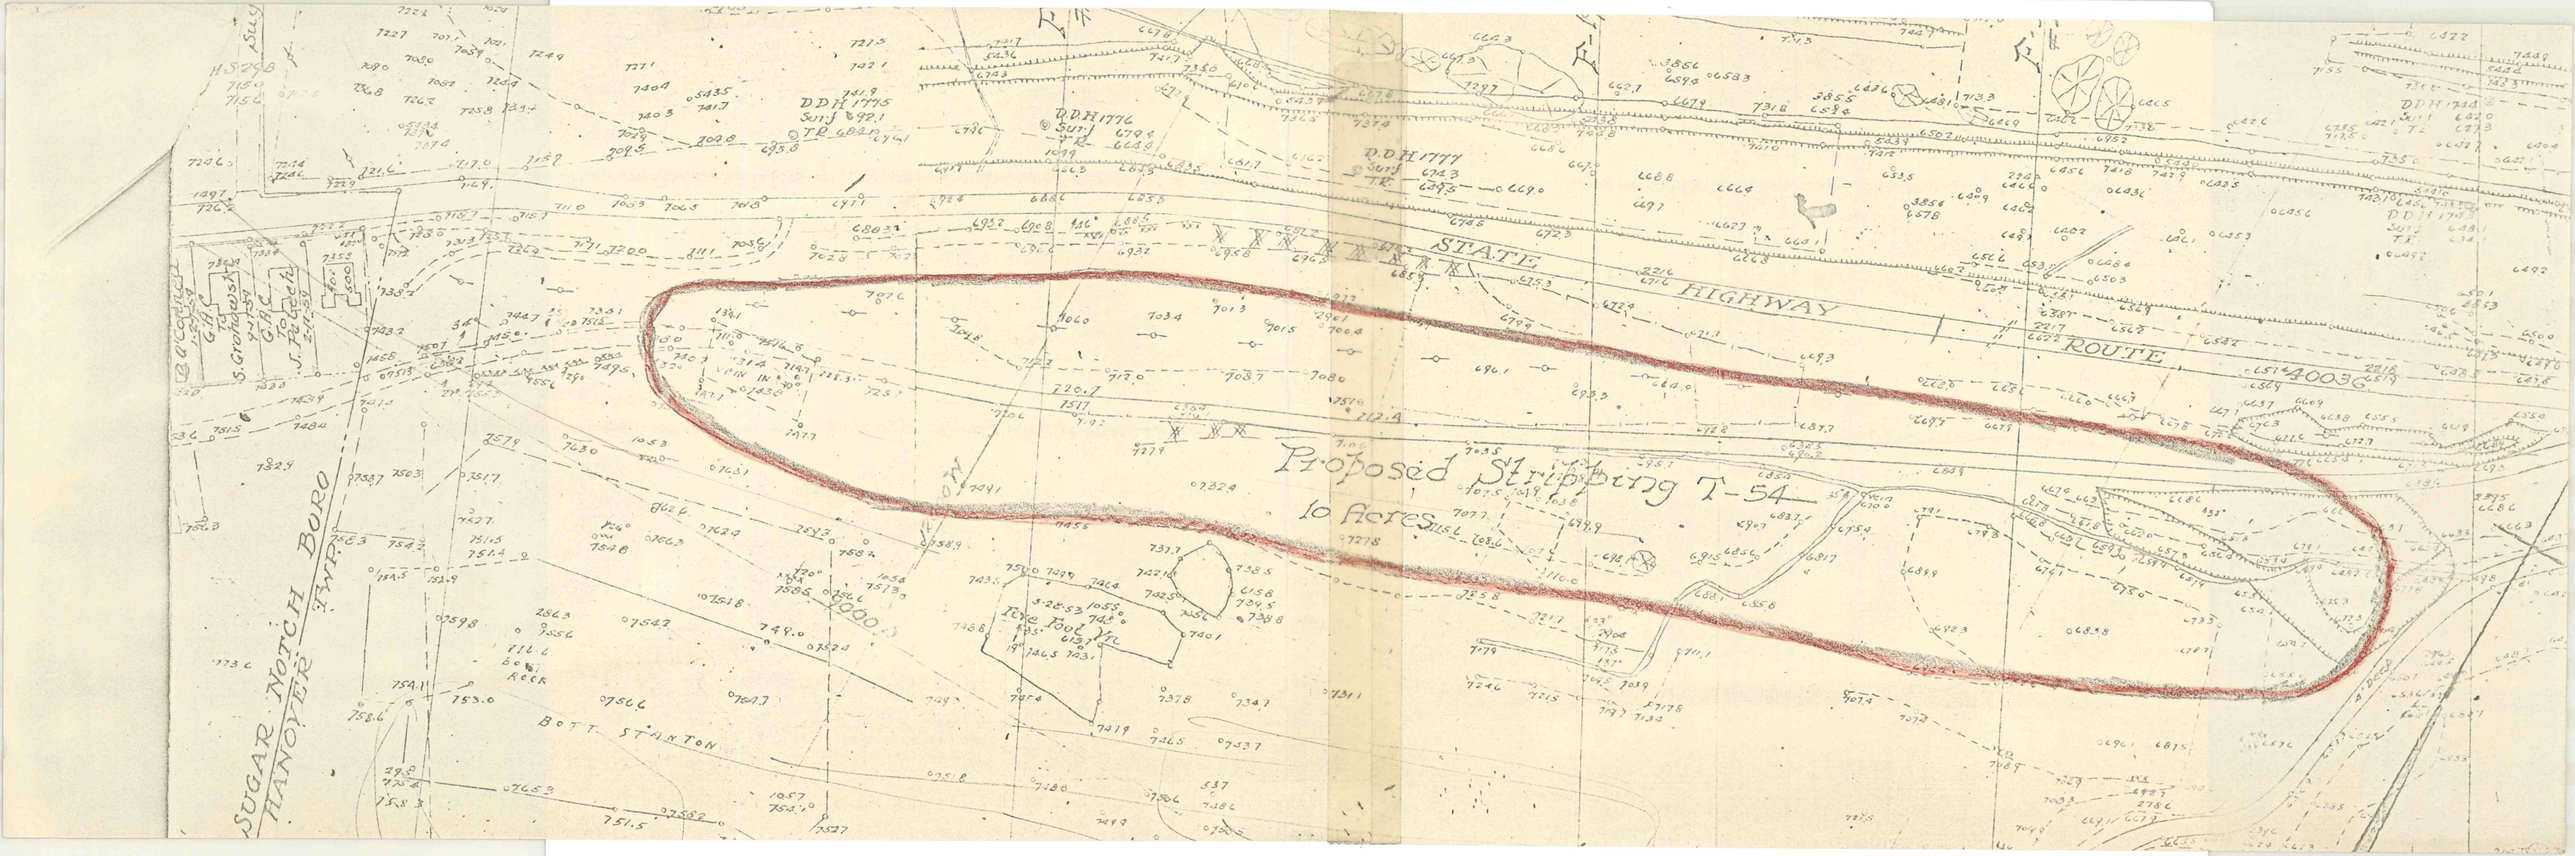
STATE HIGHWAY ROUTE 4003G
Proposed Stripping T-54
10 Acres
SUGAR NOTCH BORO
HANOVER TWP.
BOTT STANTON
Pole Road
D.D.H 1775
D.D.H 1776
D.D.H 1777
Surf Rock
S. Grohowski
J. Rzucidlo