


Leg. Route
RAILROAD ST. 40036

C. R.R. OF N. J.

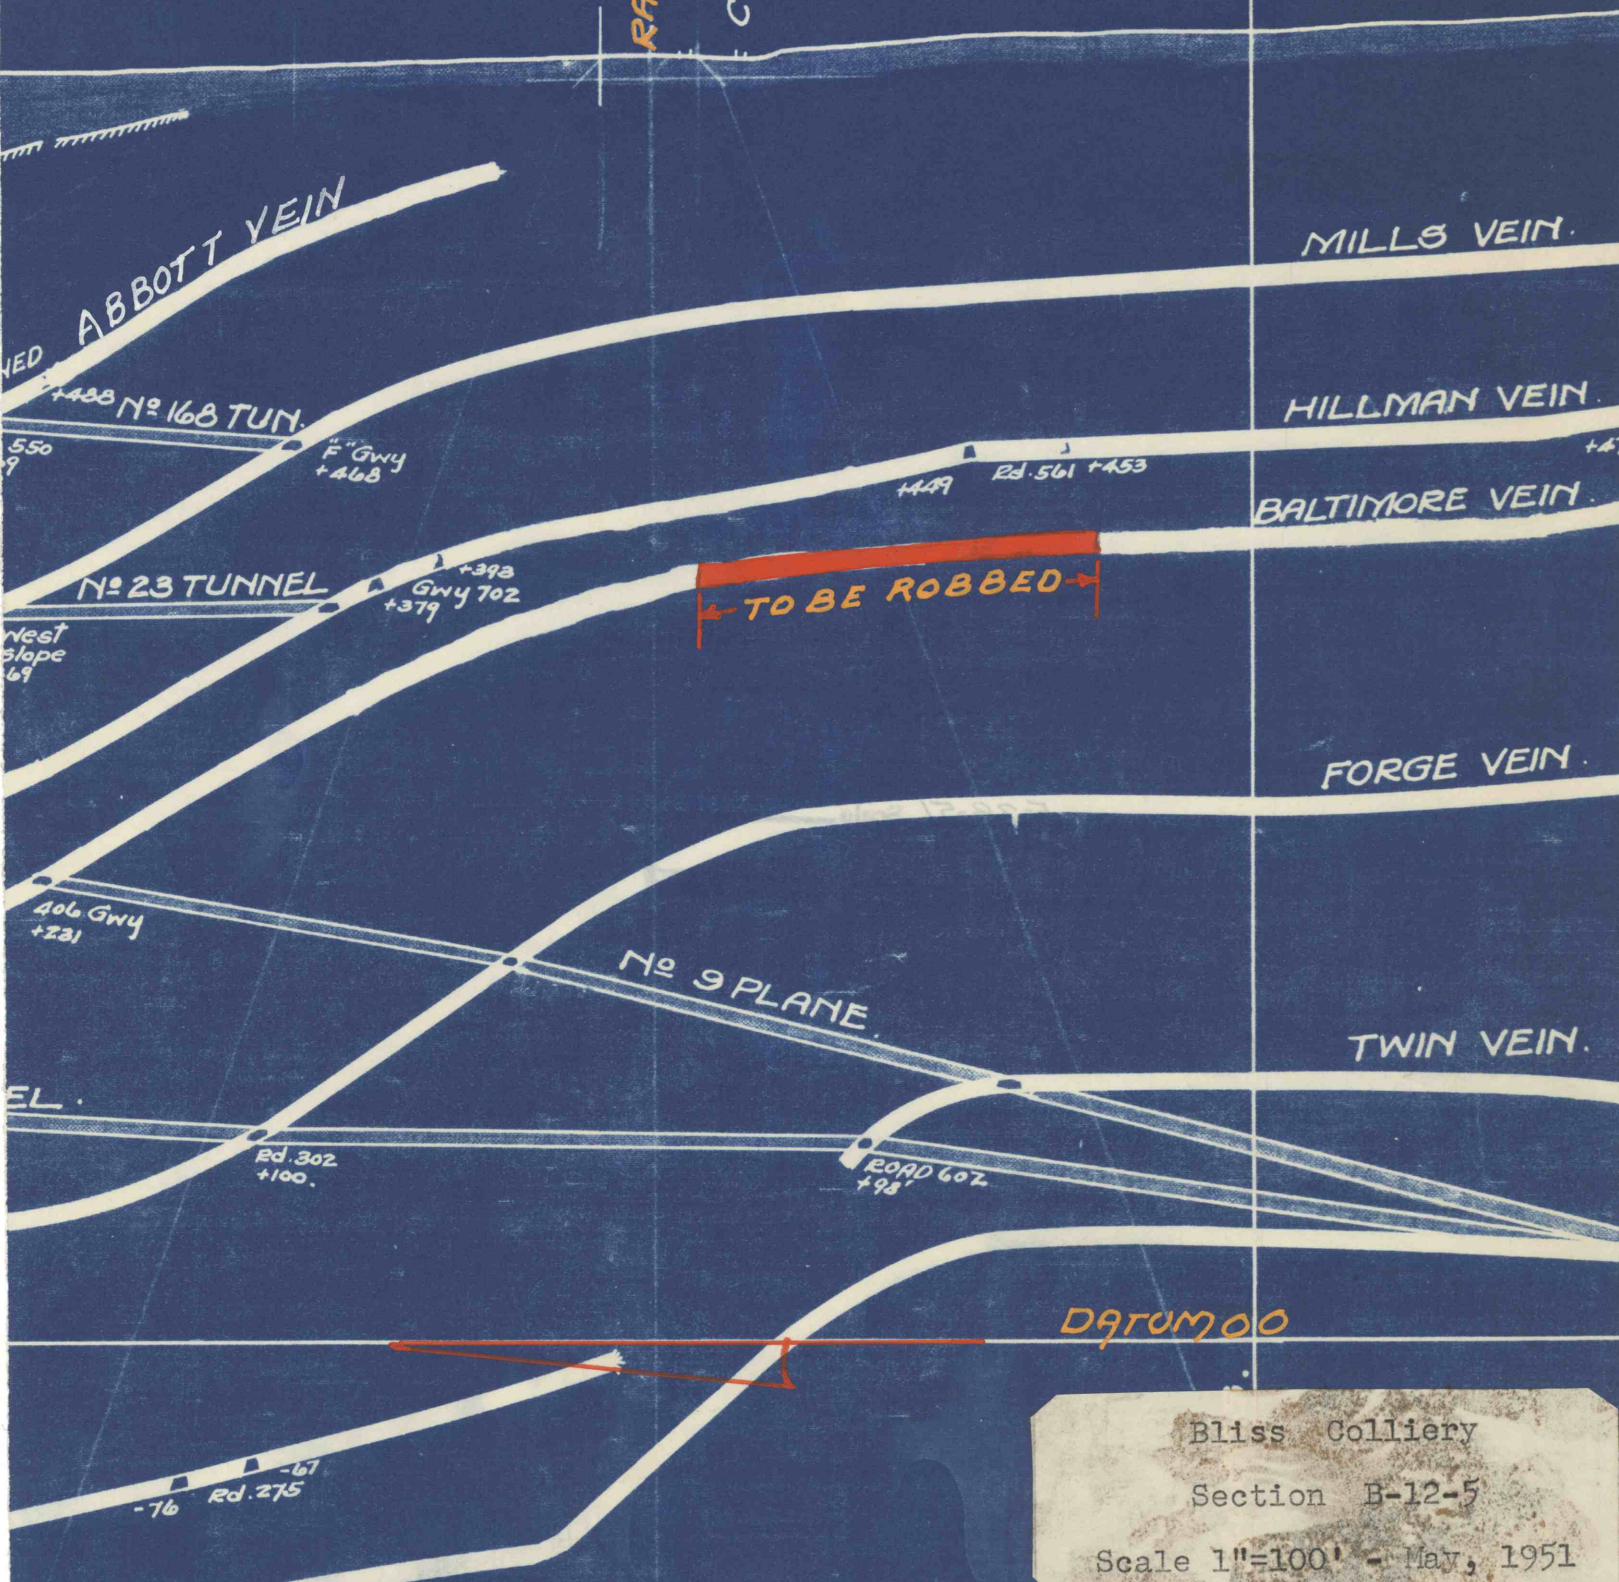

DARTMOUTH

Bliss Colliery
Section B-12-5
Scale 1"=100' - May, 1951