


PILLARS IN THESE AREAS NOW BEING REMOVED.

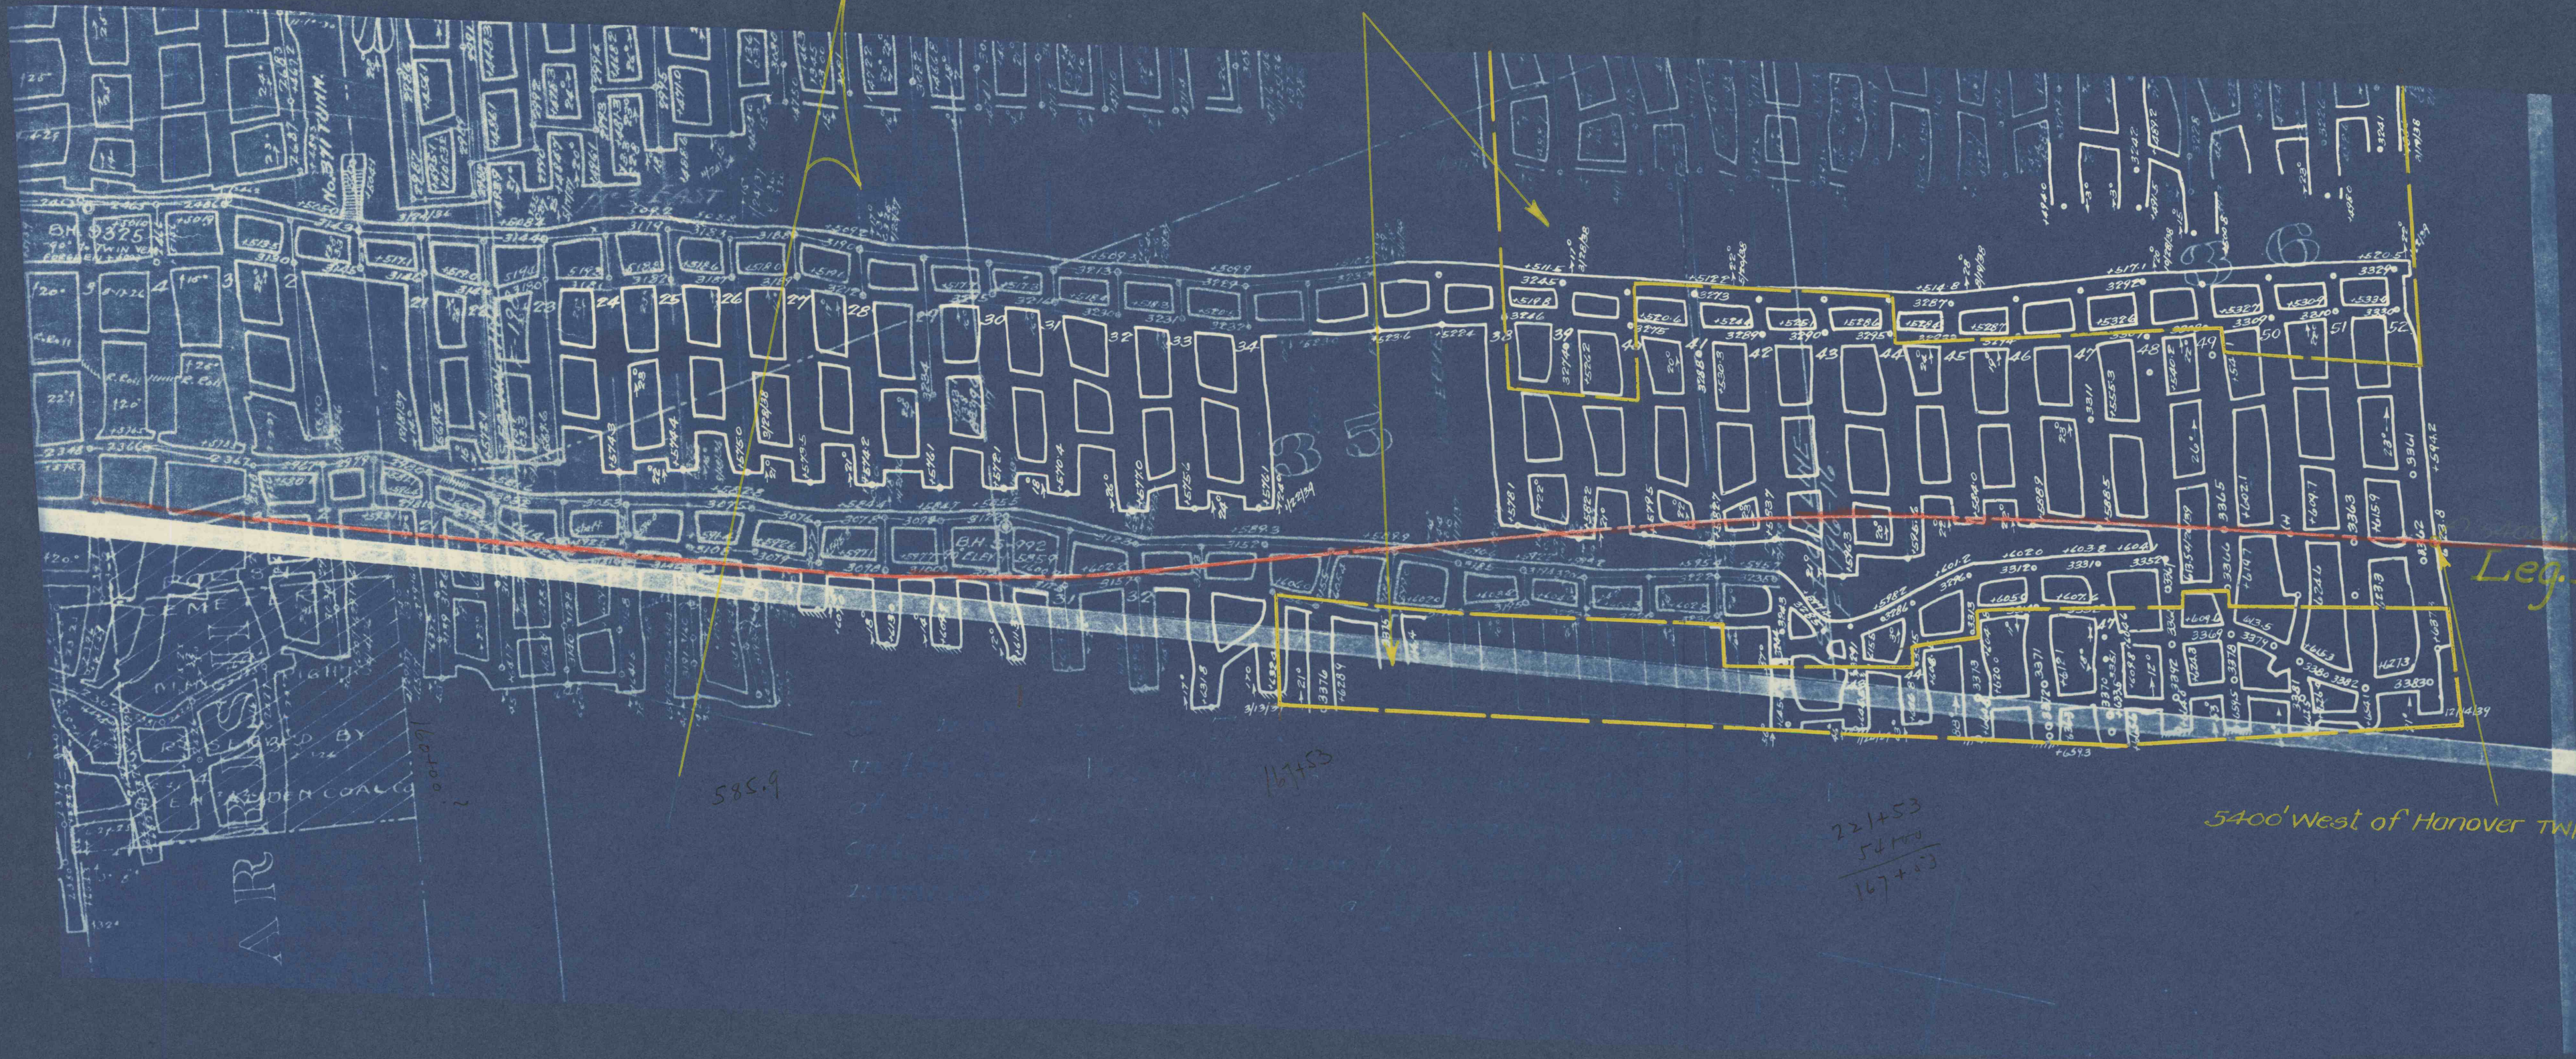

Leg. Route No 40036.

5400' West of Hanover TWP-Sugar Notch Boro Line.

FORGE Vein TRUESDALE Colliery
GLEN ALDEN COAL CO., Scranton, Pa. - Operator
A.H. LEWIS Mining Engr. SOUTHERN Div.
DAVID GIRVAN supt. TRUESDALE Colliery
Supt. _____ Colliery
Scale 1" = 100' - Date JAN. 1940