


pillars in this area to be removed

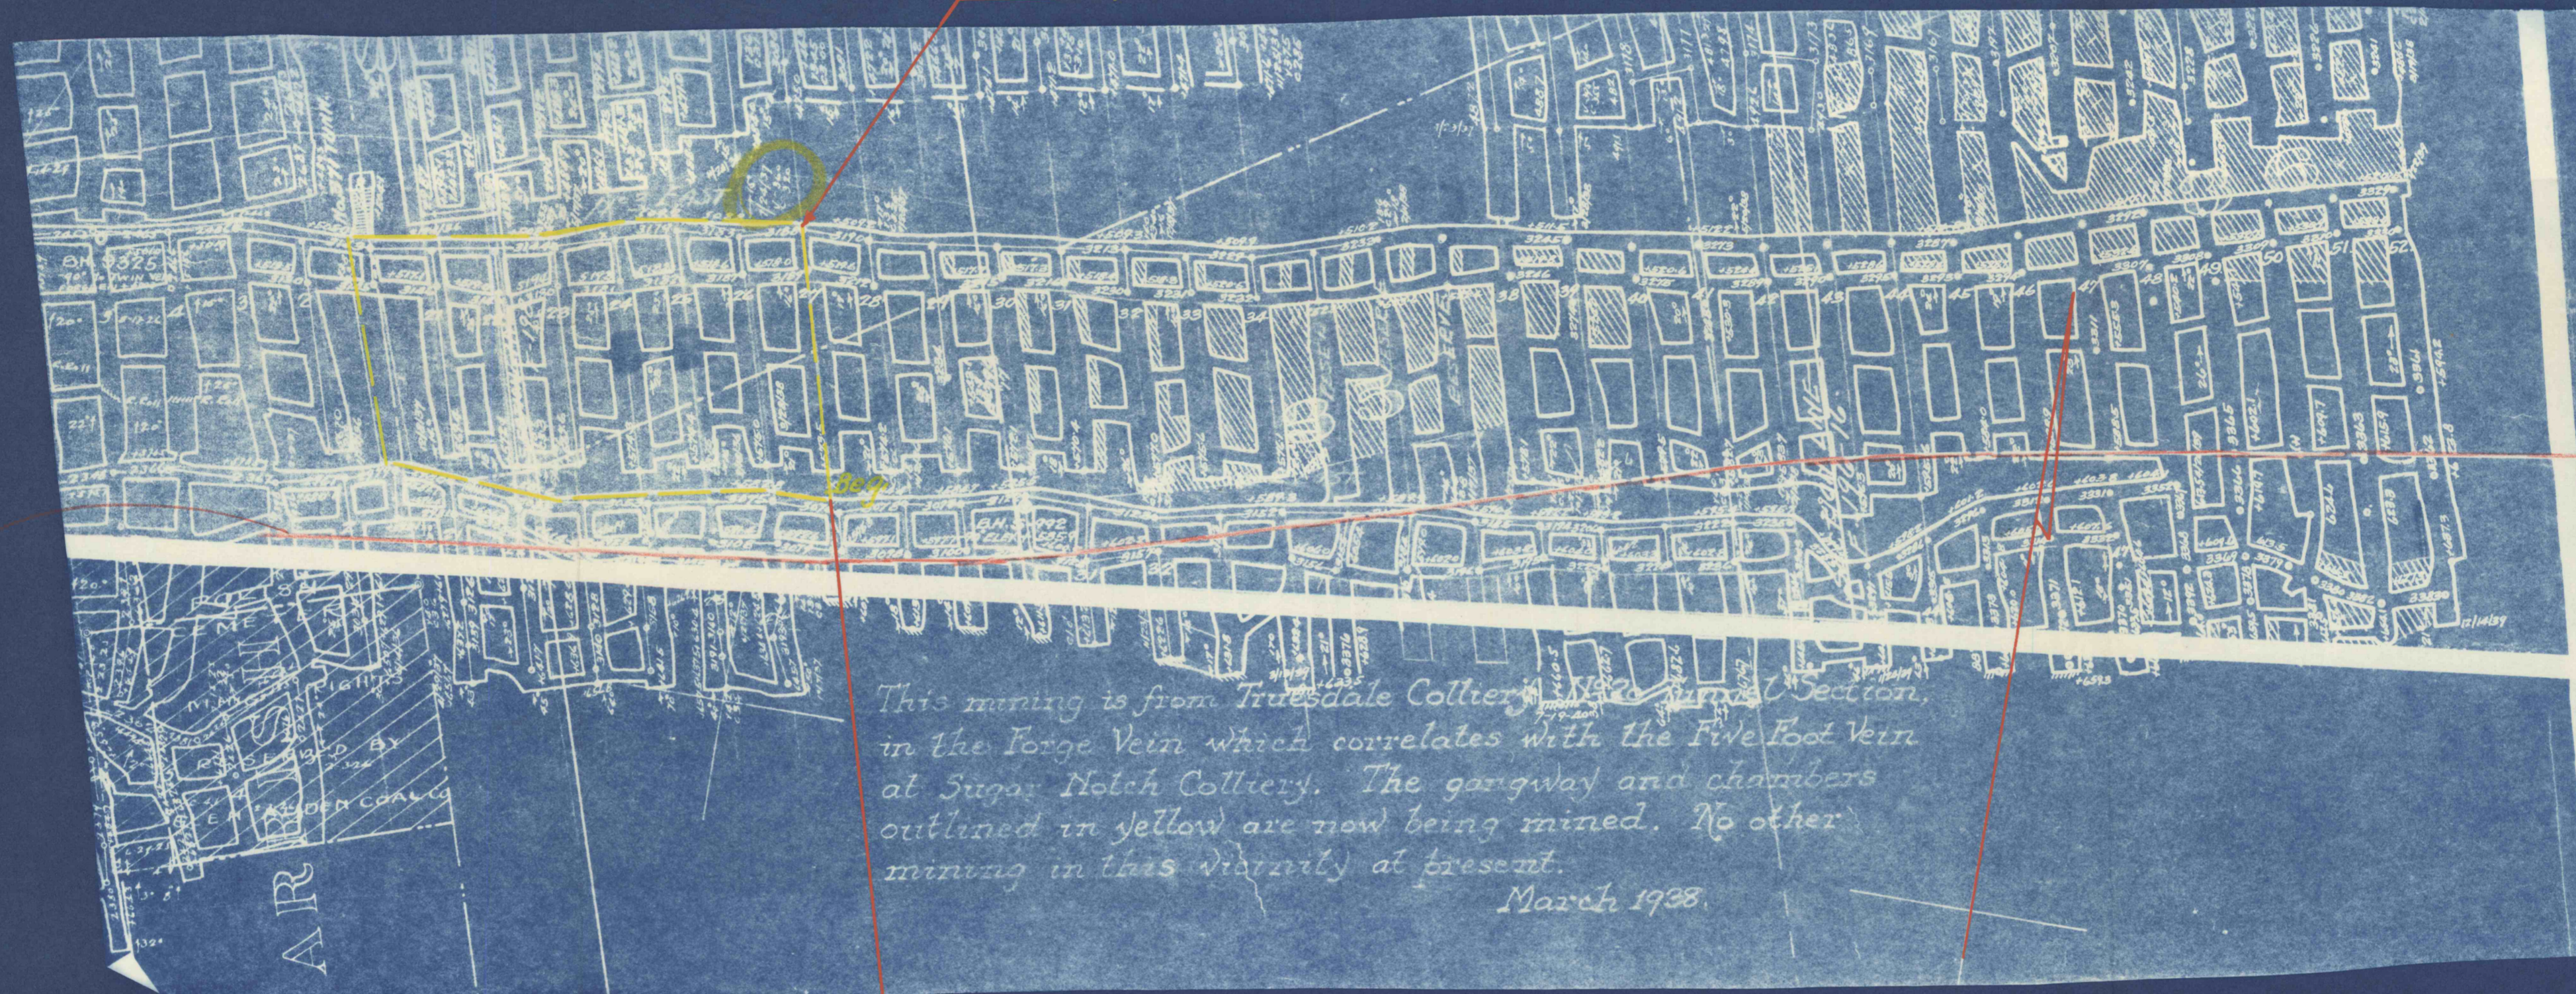

This mining is from Truesdale Colliery, ~~the~~ ^{the} ~~east~~ ^{west} Section, in the Forge Vein which correlates with the Five Foot Vein at Sugar Notch Colliery. The gangway and chambers outlined in yellow are now being mined. No other mining in this vicinity at present.


stat. 221+53=6600'

27400.06

Leg. Route 40036

FORGE Vein *TRUESDALE* Colliery
GLEN ALDEN COAL CO., Scranton, Pa. - Operator
A.H. LEWIS Mining Engr. Div.
D.J. JOSEPH Supt. *TRUESDALE* Colliery
Supt. Colliery

Scale 1" = 100' - Date *NOV. 1941*