




Sta. 124+74

Pillars in this area to be removed

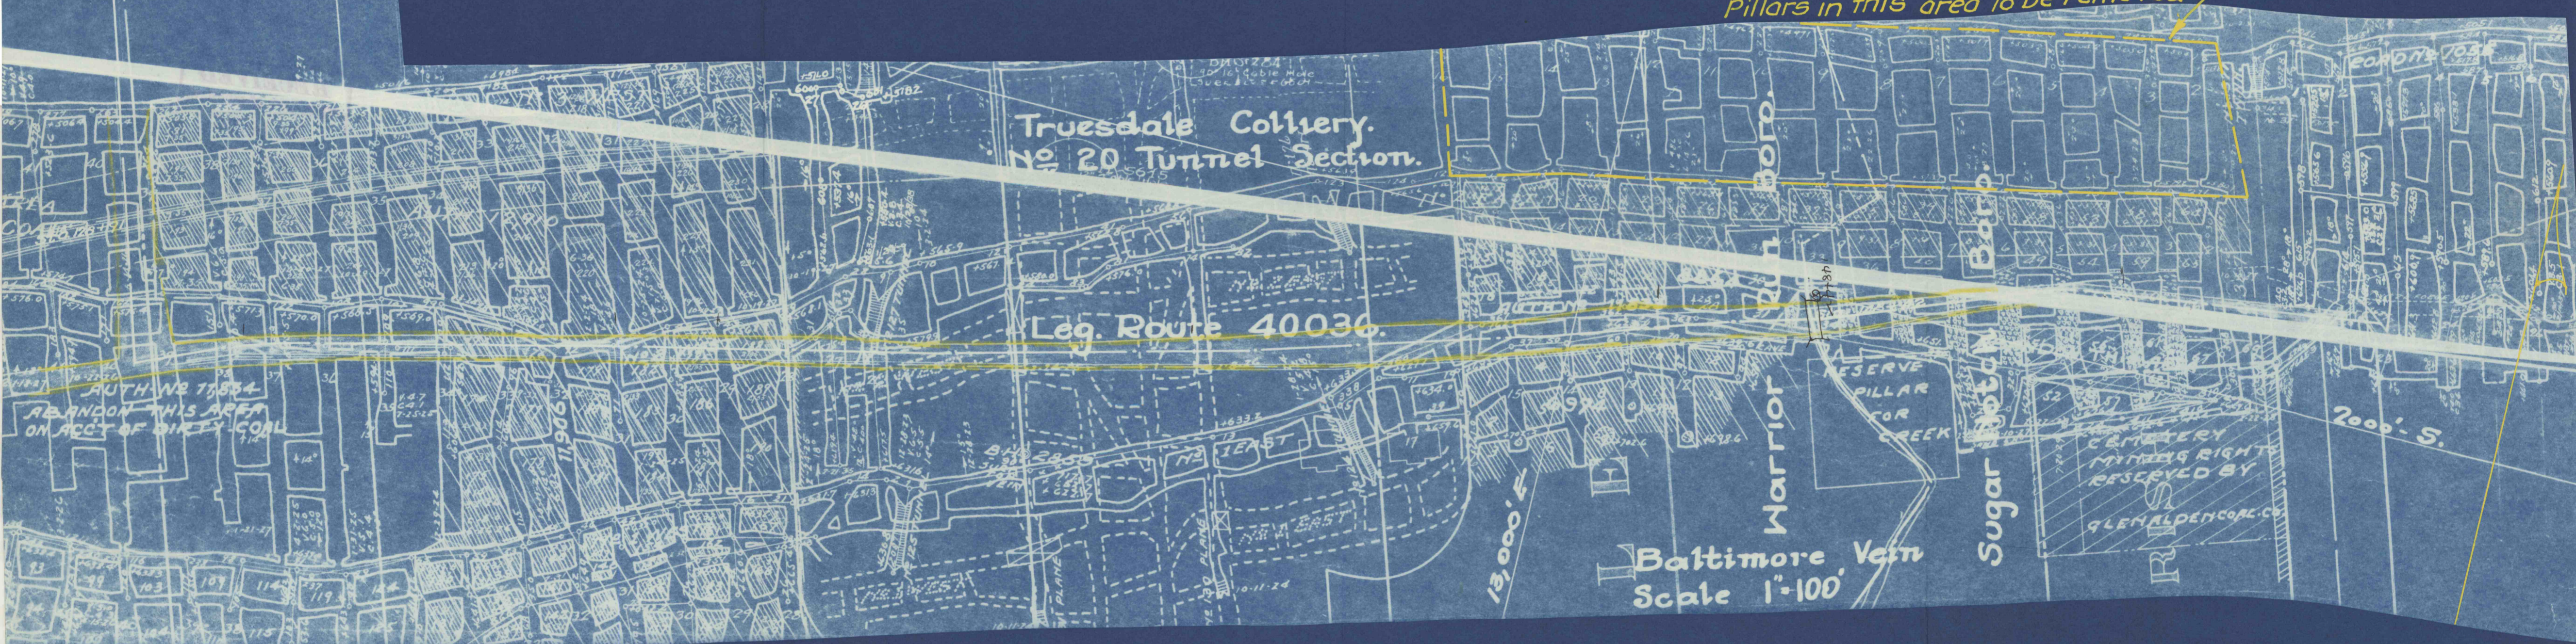

*717.7
653.7
64.0*

*Baltimore Vein Truesdale Colliery
Glen Alden Coal Co., Scranton, Pa. - Operator
A. H. Lewis Mining Engr., Southern Division
D. J. Joseph Supt. Truesdale Colliery
Supt. Colliery
Scale 1" = 100' Date June 30 1941*