


CENTRAL RAILROAD
+652.0
B.H. 7342
SURF. +660.8

LEHIGH VALLEY
RAILROAD
+674.0

CHESTNUT ST.
W.B. & W.B. RWY
+693.0

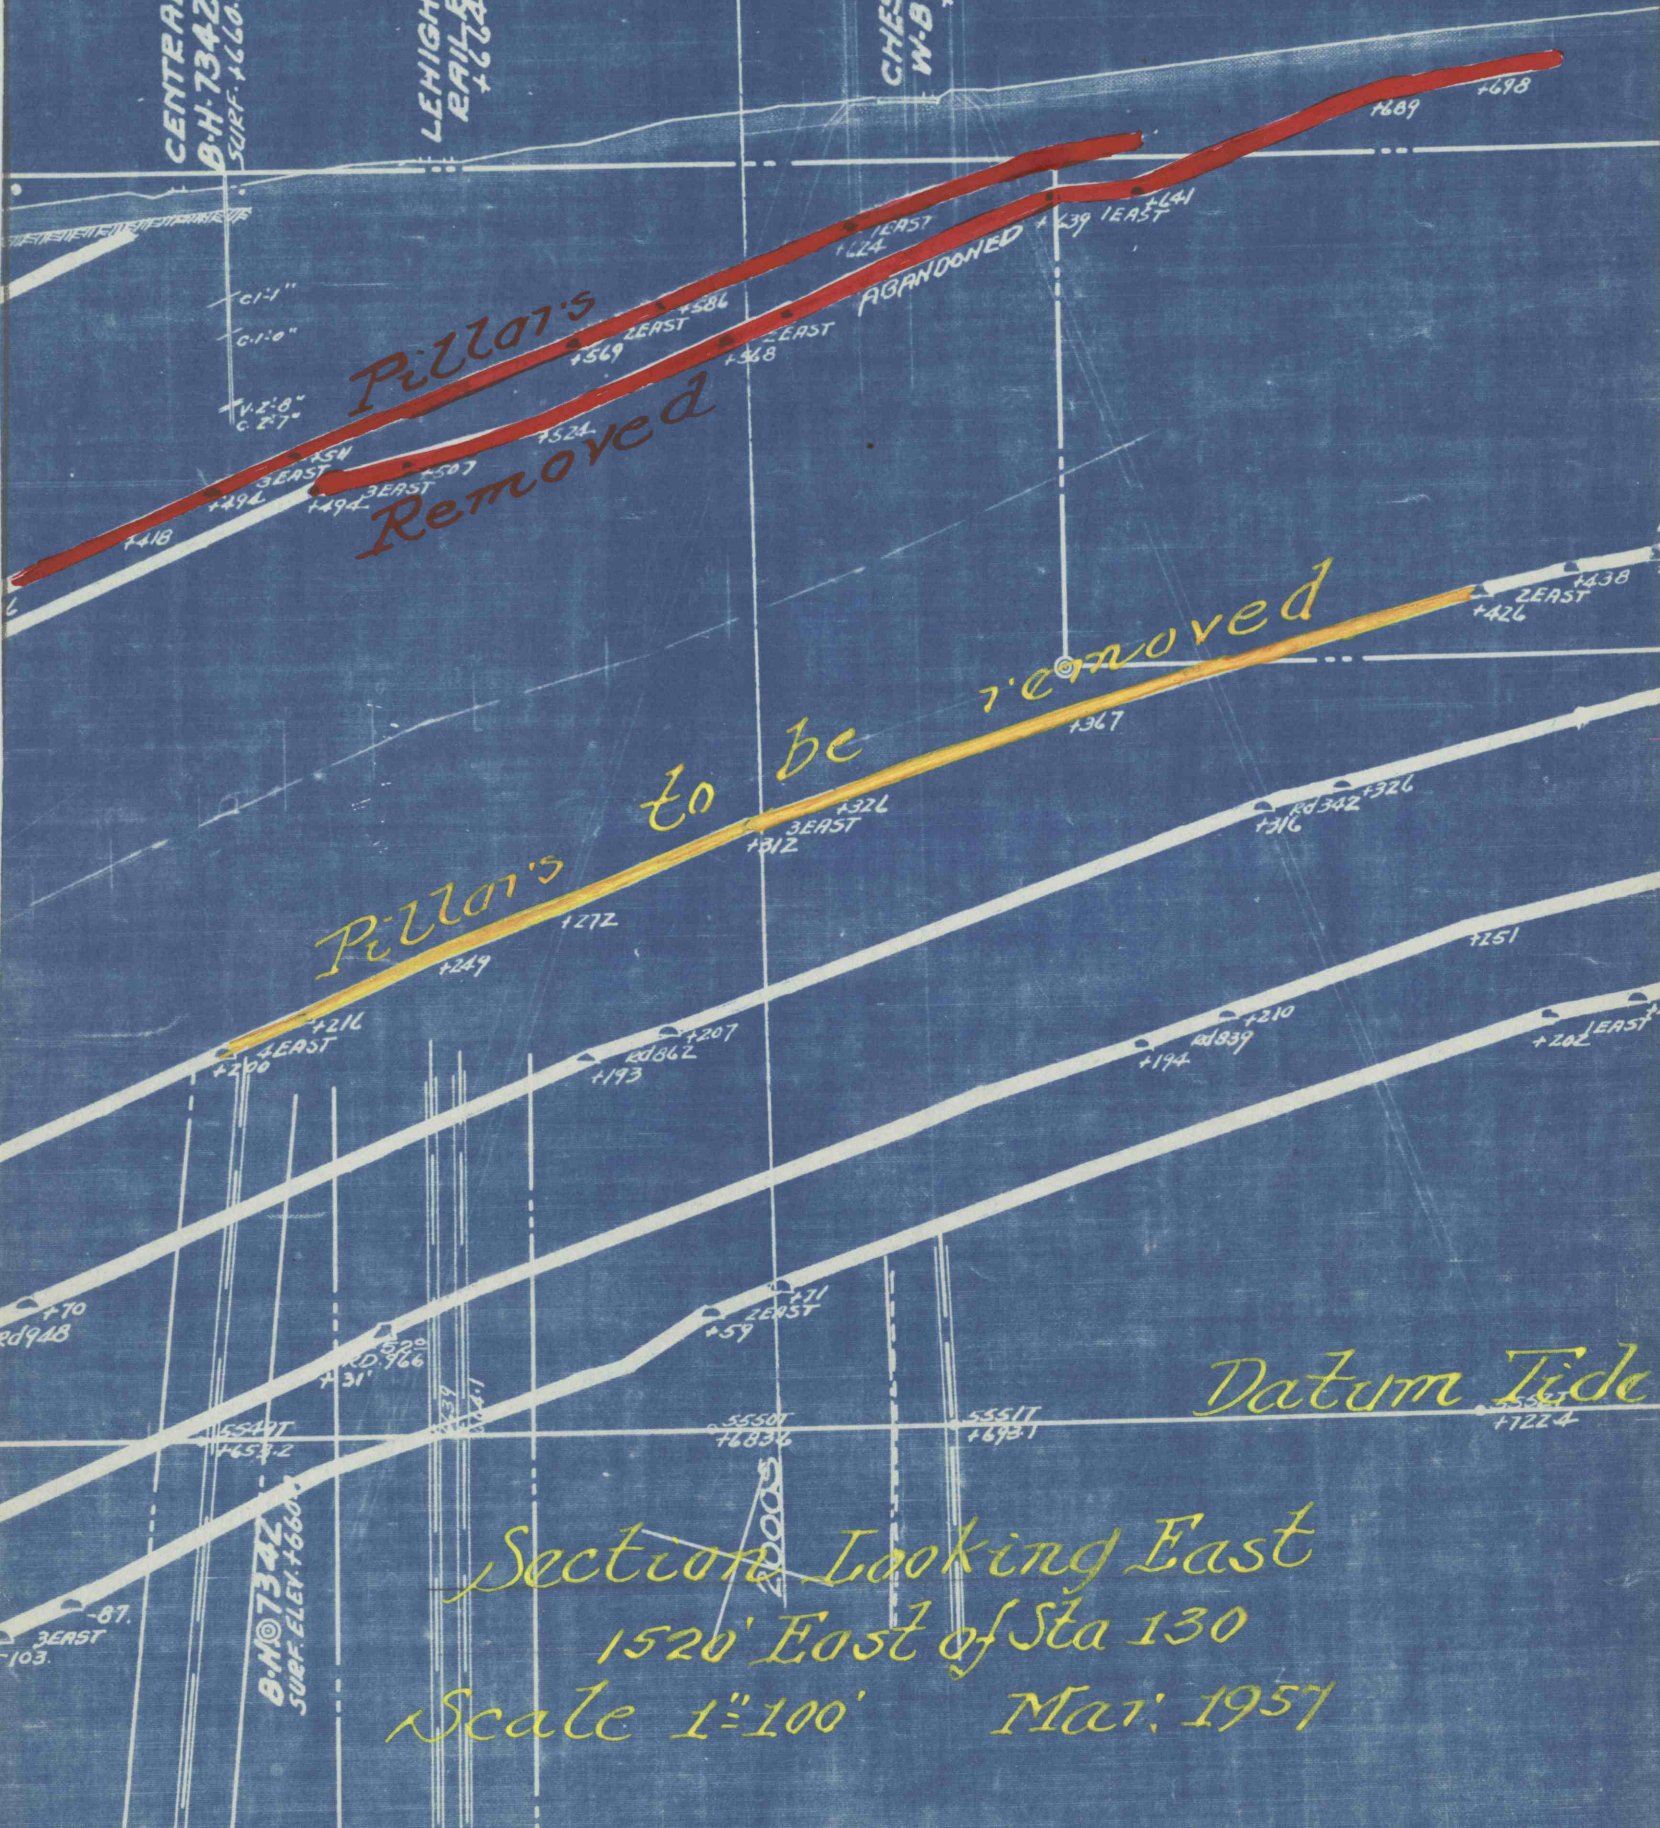

Pillot's
Removed

Pillot's
to be removed

Datum Tide

Section Looking East
1520' East of Sta 130
Scale 1"=100' Mar. 1957

B.H. 7342
SURF. ELEV. 660.8

-87.
3 EAST
-103.

+70
RD 948

+31'
RD 766

+71
2 EAST
+59

5550T
+683.6

5551T
+693.1

5552T
+722.4

+216
4 EAST
+200

+207
RD 362
+193

+210
RD 339
+194

+202
1 EAST

+249
1272

+326
3 EAST
+312

+326
RD 342
+316

+367

+438
2 EAST
+426

+494
3 EAST

+494
3 EAST

+524

+569
2 EAST

+568
3 EAST

+624
1 EAST

+639
1 EAST

+689

+698