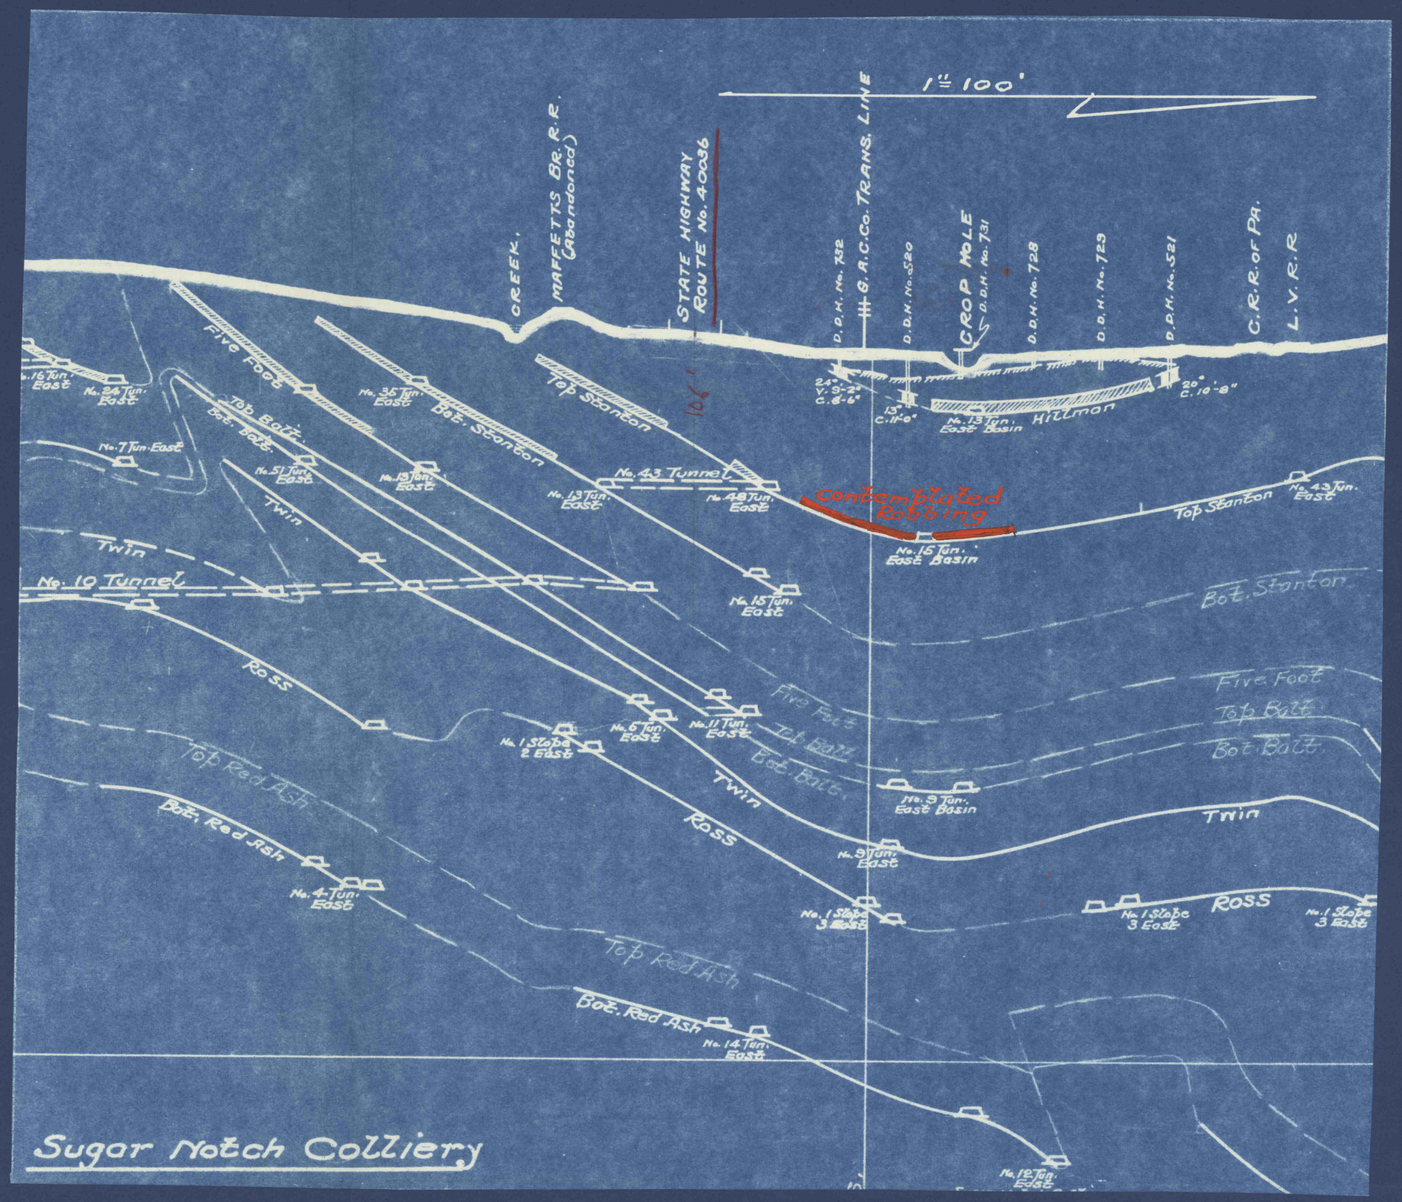

Sugar Notch Colliery