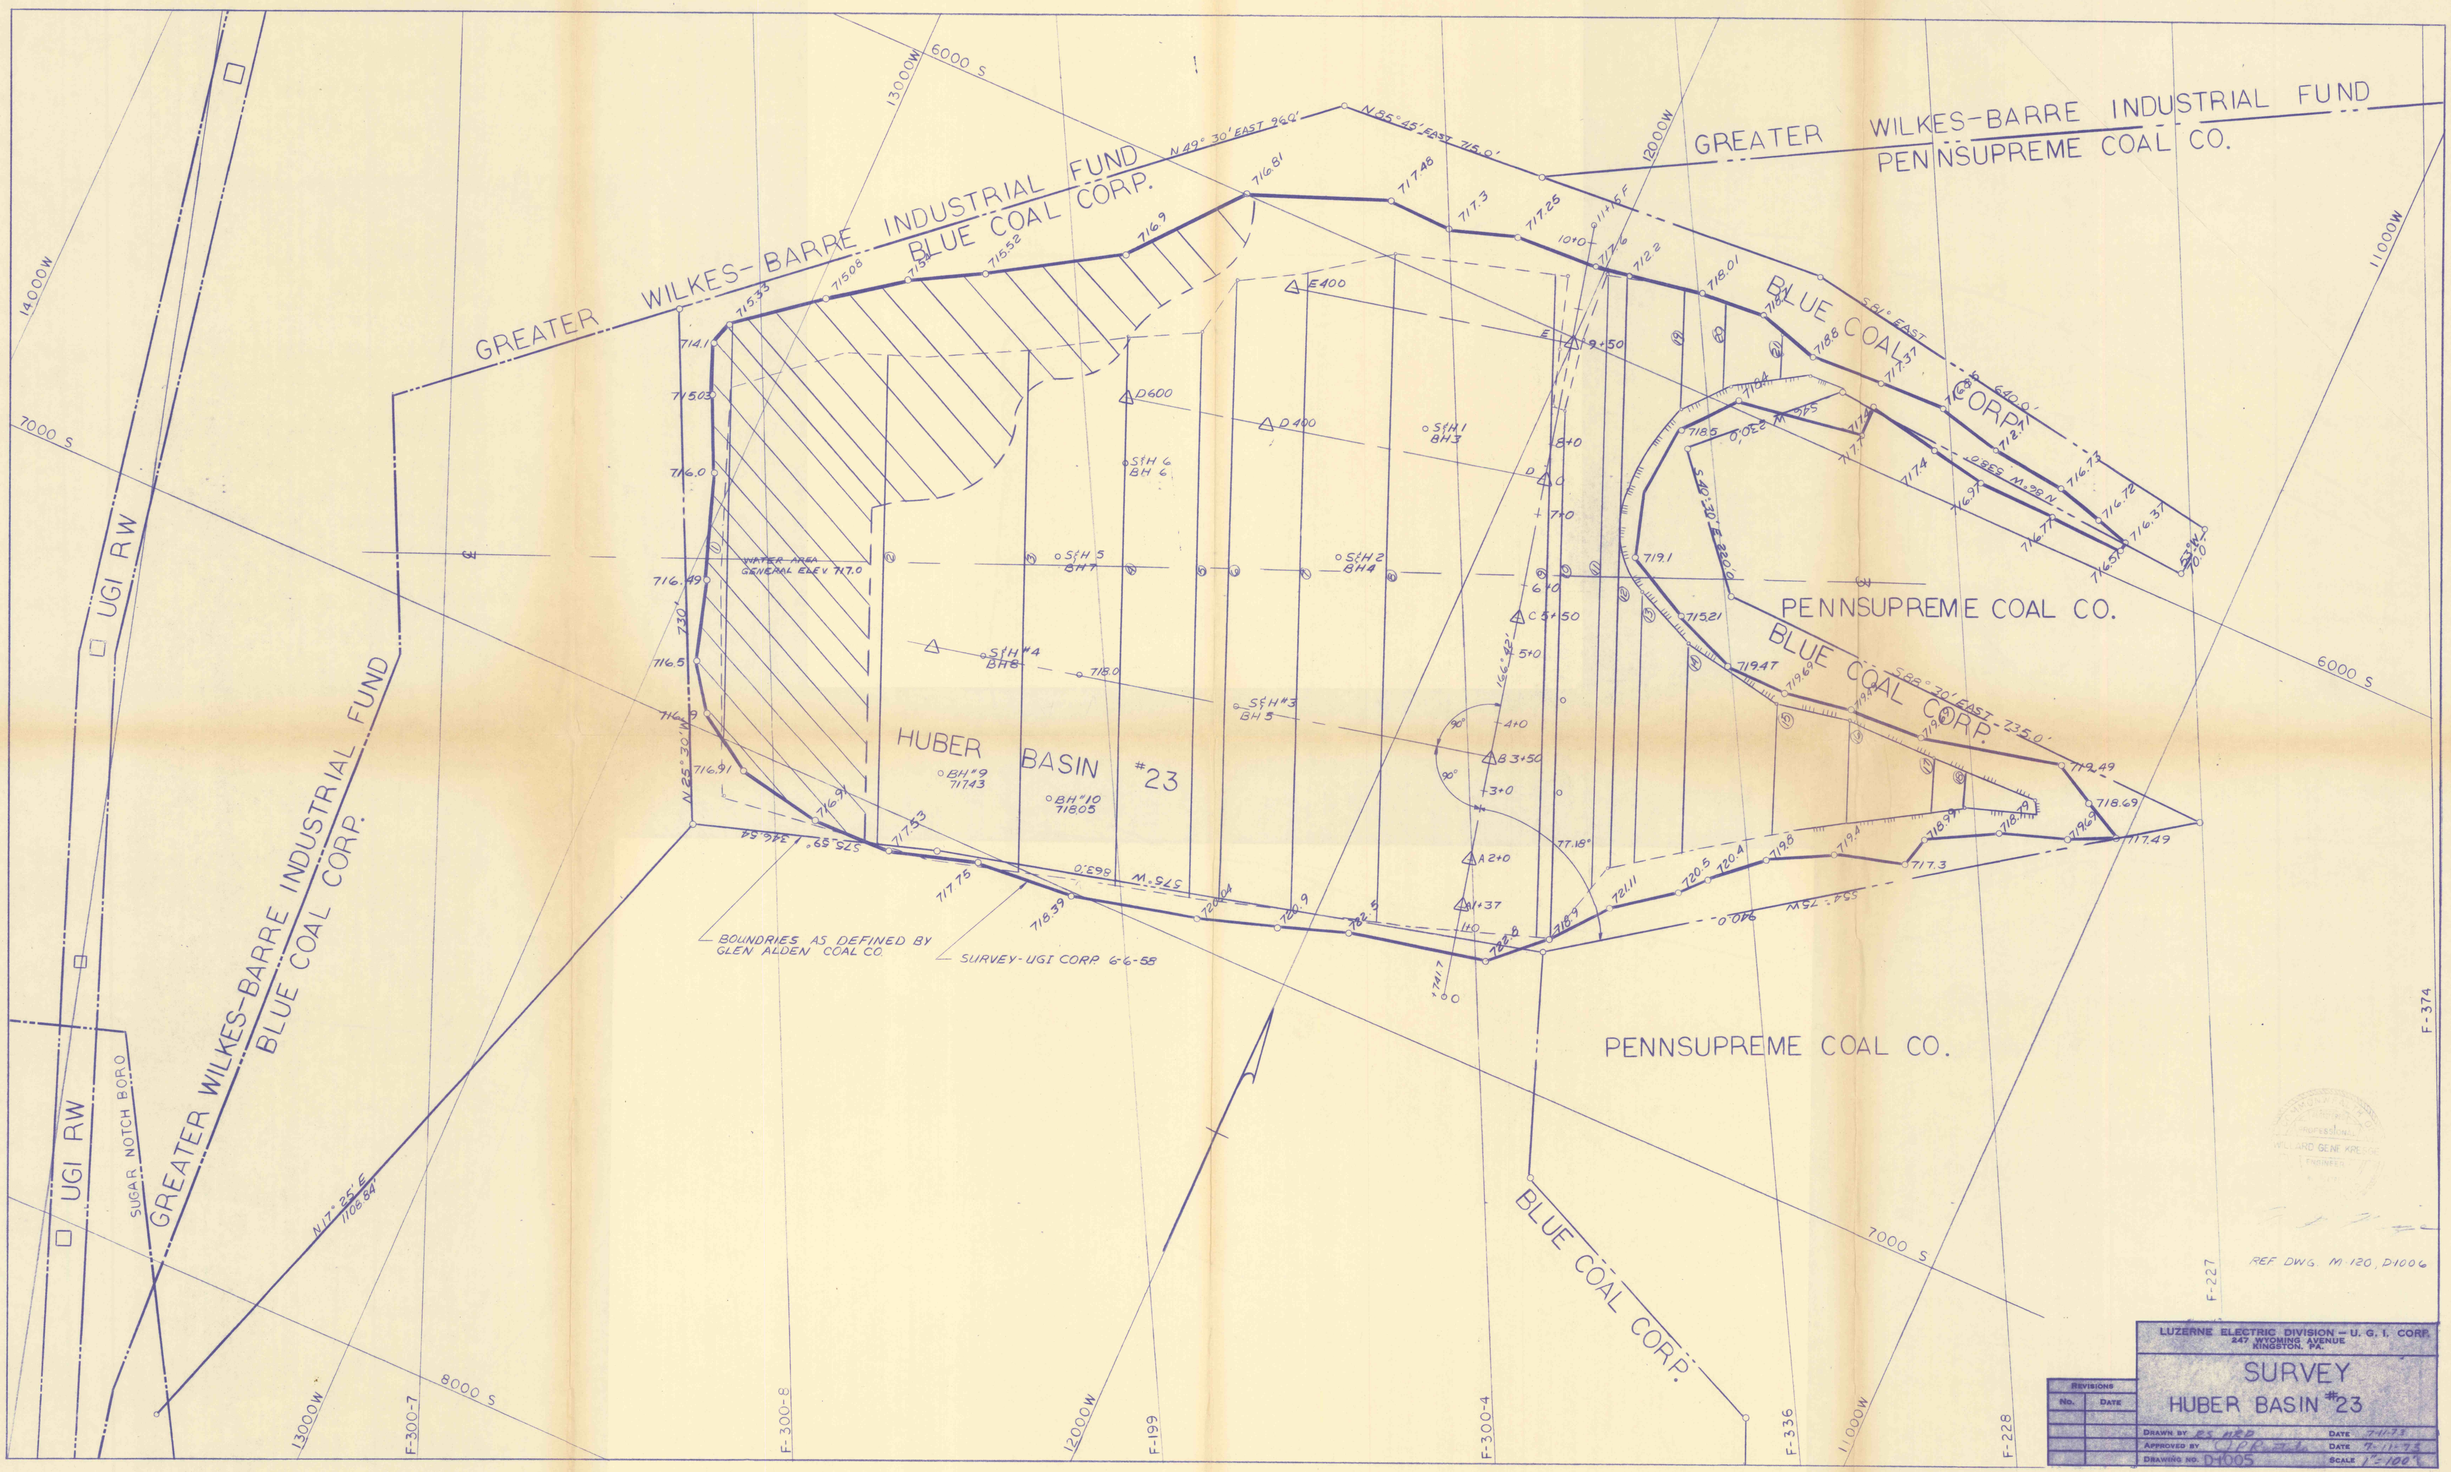
GREATER WILKES-BARRE INDUSTRIAL FUND
BLUE COAL CORP.
GREATER WILKES-BARRE INDUSTRIAL FUND
PENNSUPREME COAL CO.
BLUE COAL CORP.
PENNSUPREME COAL CO.
BLUE COAL CORP.
PENNSUPREME COAL CO.
BLUE COAL CORP.
HUBER BASIN #23
UGI RW
UGI RW
SUGAR NOTCH BORO
GREATER WILKES-BARRE INDUSTRIAL FUND
BLUE COAL CORP.
WATER AREA GENERAL ELEV 717.0
BOUNDRIES AS DEFINED BY GLEN ALDEN COAL CO.
SURVEY-UGI CORP. 6-6-58
N 49° 30' EAST 960'
N 85° 45' EAST 715.0'
S 81° EAST 640.0'
S 88° 30' EAST 735.0'
N 17° 25' E 1106.84'
N 25° 30' W
S 75° W 863.0'
S 54° 75' W 940.0'
6000 S
7000 S
8000 S
13000W
12000W
11000W
14000W
F-300-7
F-300-8
F-199
F-300-4
F-336
F-228
F-227
F-374
REF DWG. M-120, D-1006
LUZERNE ELECTRIC DIVISION – U. G. I. CORP.
247 WYOMING AVENUE
KINGSTON, PA.
SURVEY
HUBER BASIN #23
REVISIONS
No.
DATE
DRAWN BY RS, MRD
DATE 7-11-73
APPROVED BY
DATE 7-11-73
DRAWING NO. D-1005
SCALE 1"=100'