


NO. 14 DRIFTS - PITTSTON VEIN
 SCALE 1 INCH = 100 FT
 PITTSTON VEIN
 "14" DRIFTS -
 COLLIERY
 No. 14
 MAIN

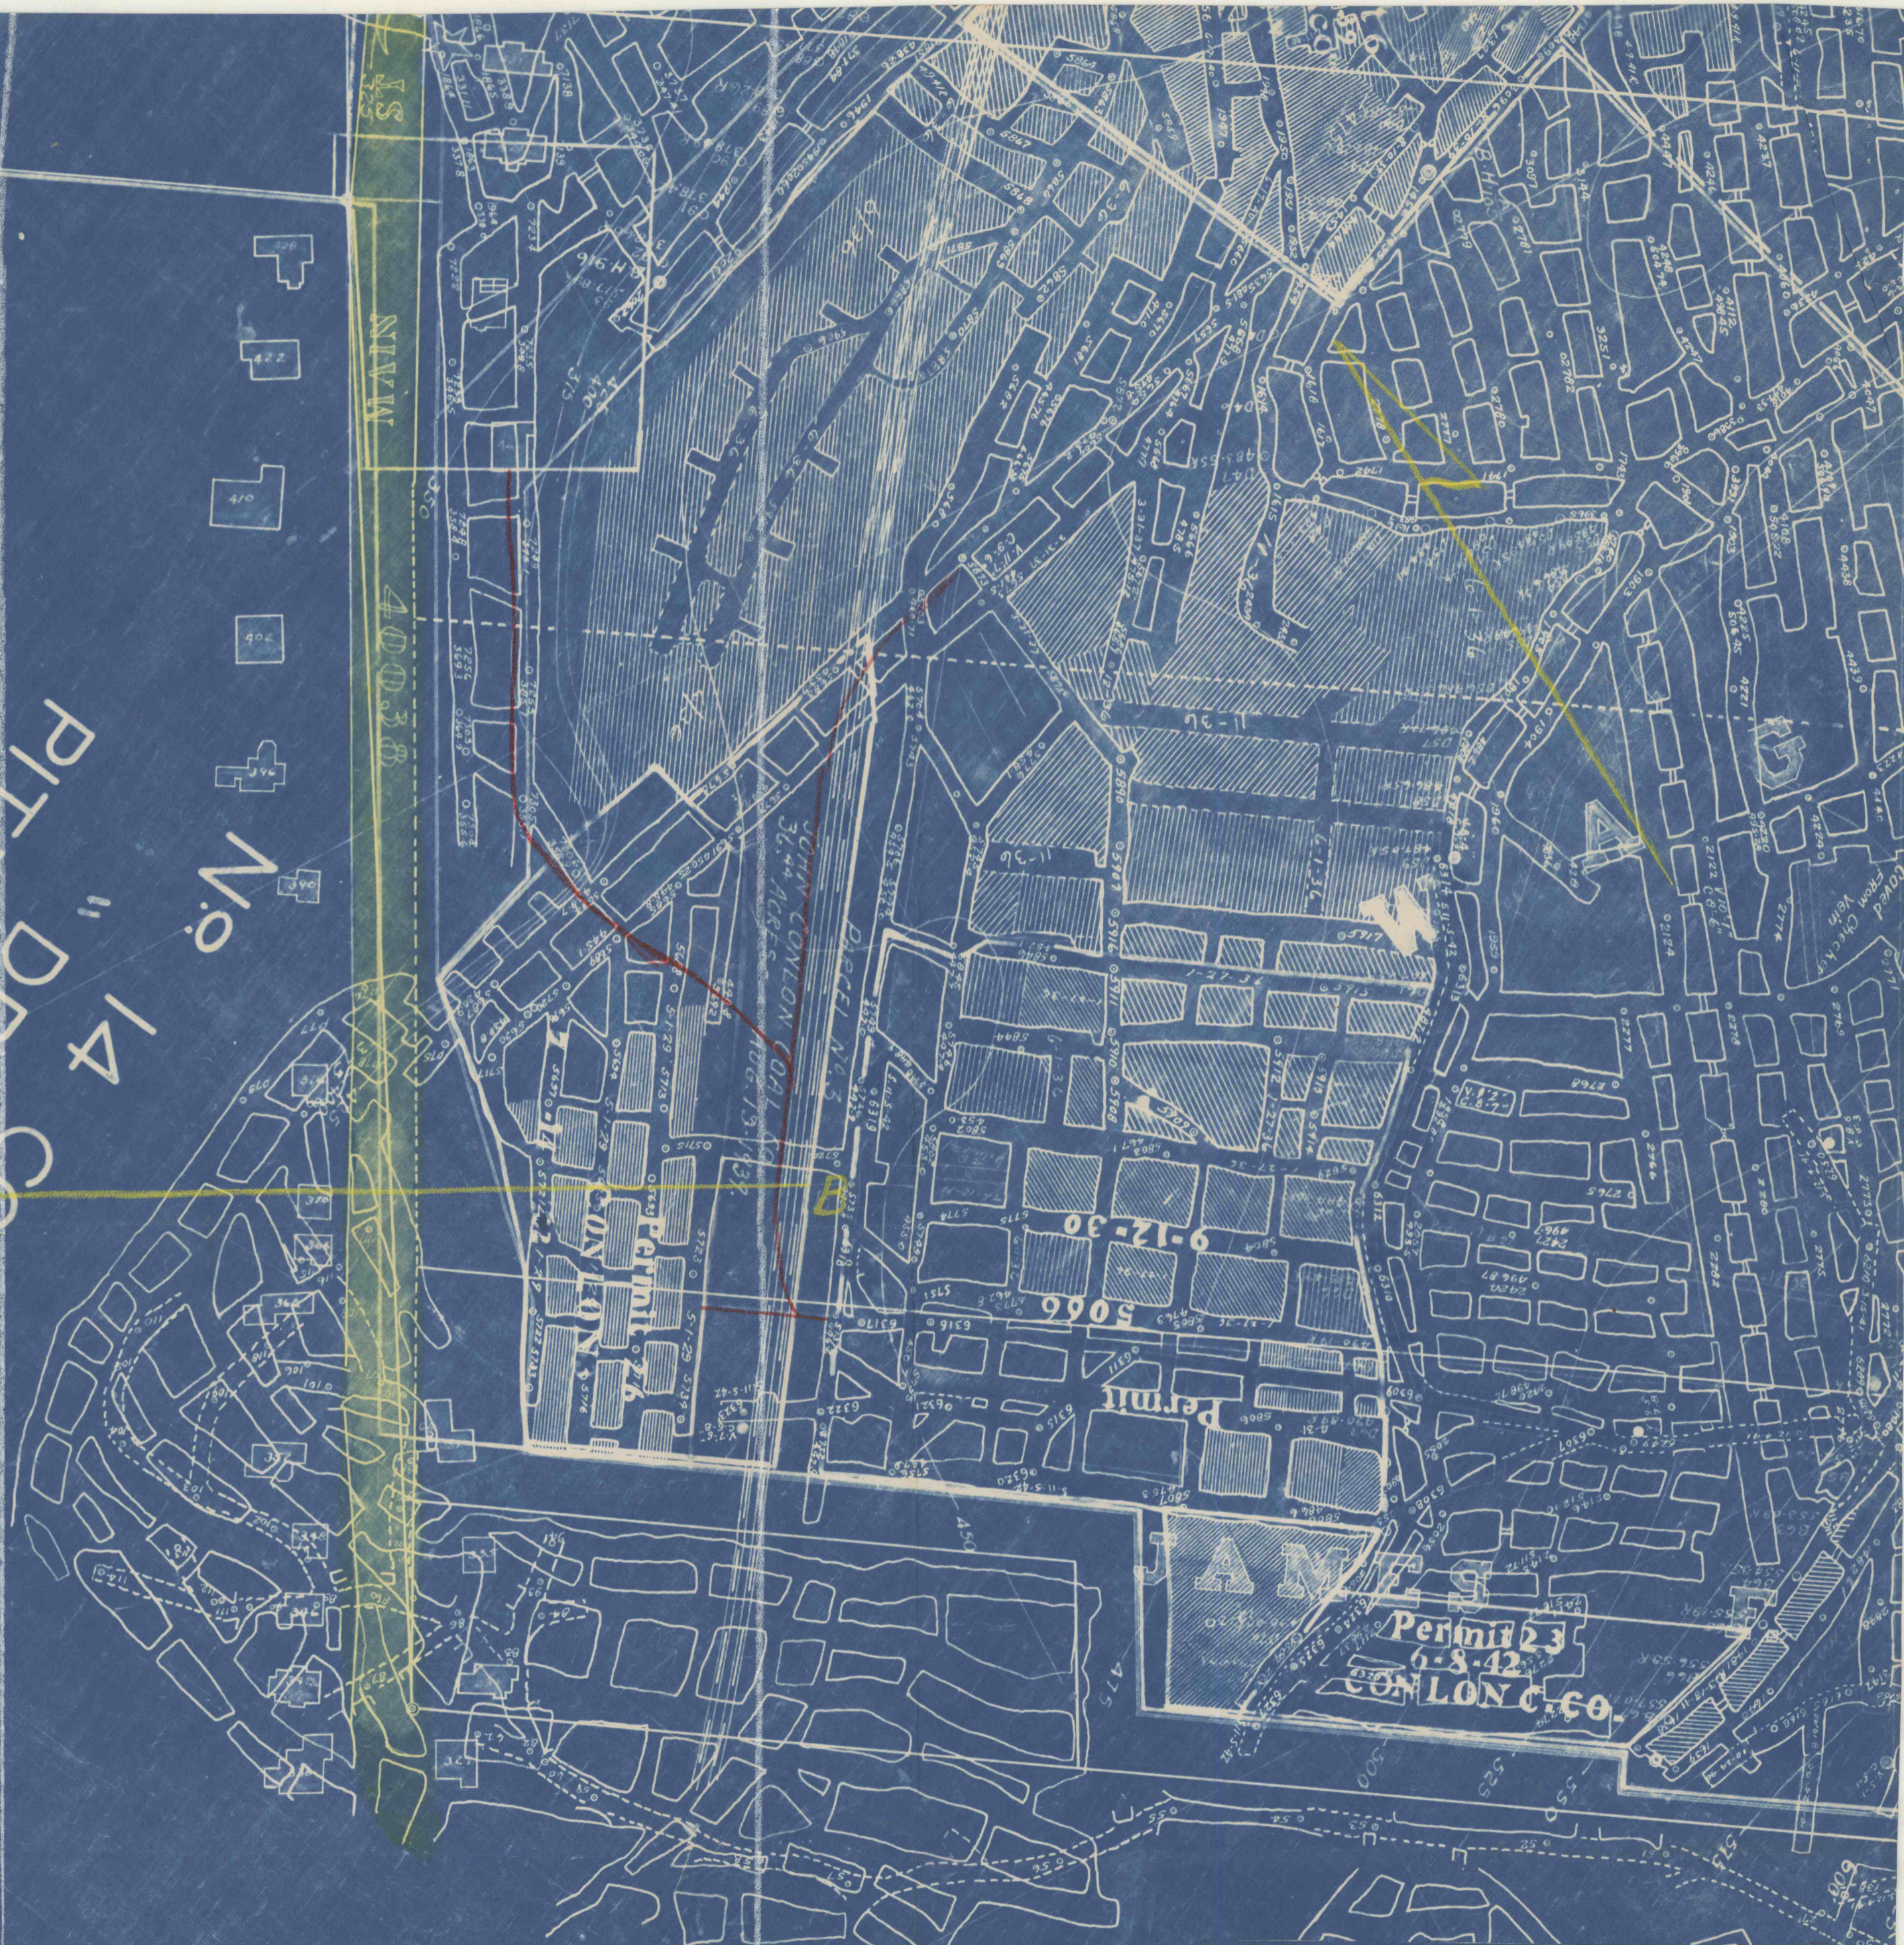

NO. 14 COLLIERY
 NO. 14 DRIFTS - PITTSTON VEIN
 Scale 1" - 100'

PENNSYLVANIA COAL CO. (Owner)	SMITH & MILL STS., DUNMORE, PA.
CONLON COAL CO. (Operator)	STARK ST., HUDSON, WILKES-BARRE, PA.

No Mining Engineer at present.

GREEN - Leg. Route #40038
 YELLOW - Cross Sections
 WHITE - 300 Ft. line adjacent to center
 of road.
 VIOLET - 6 months contemplated second mining.
 RED - 6 months contemplated first mining.