


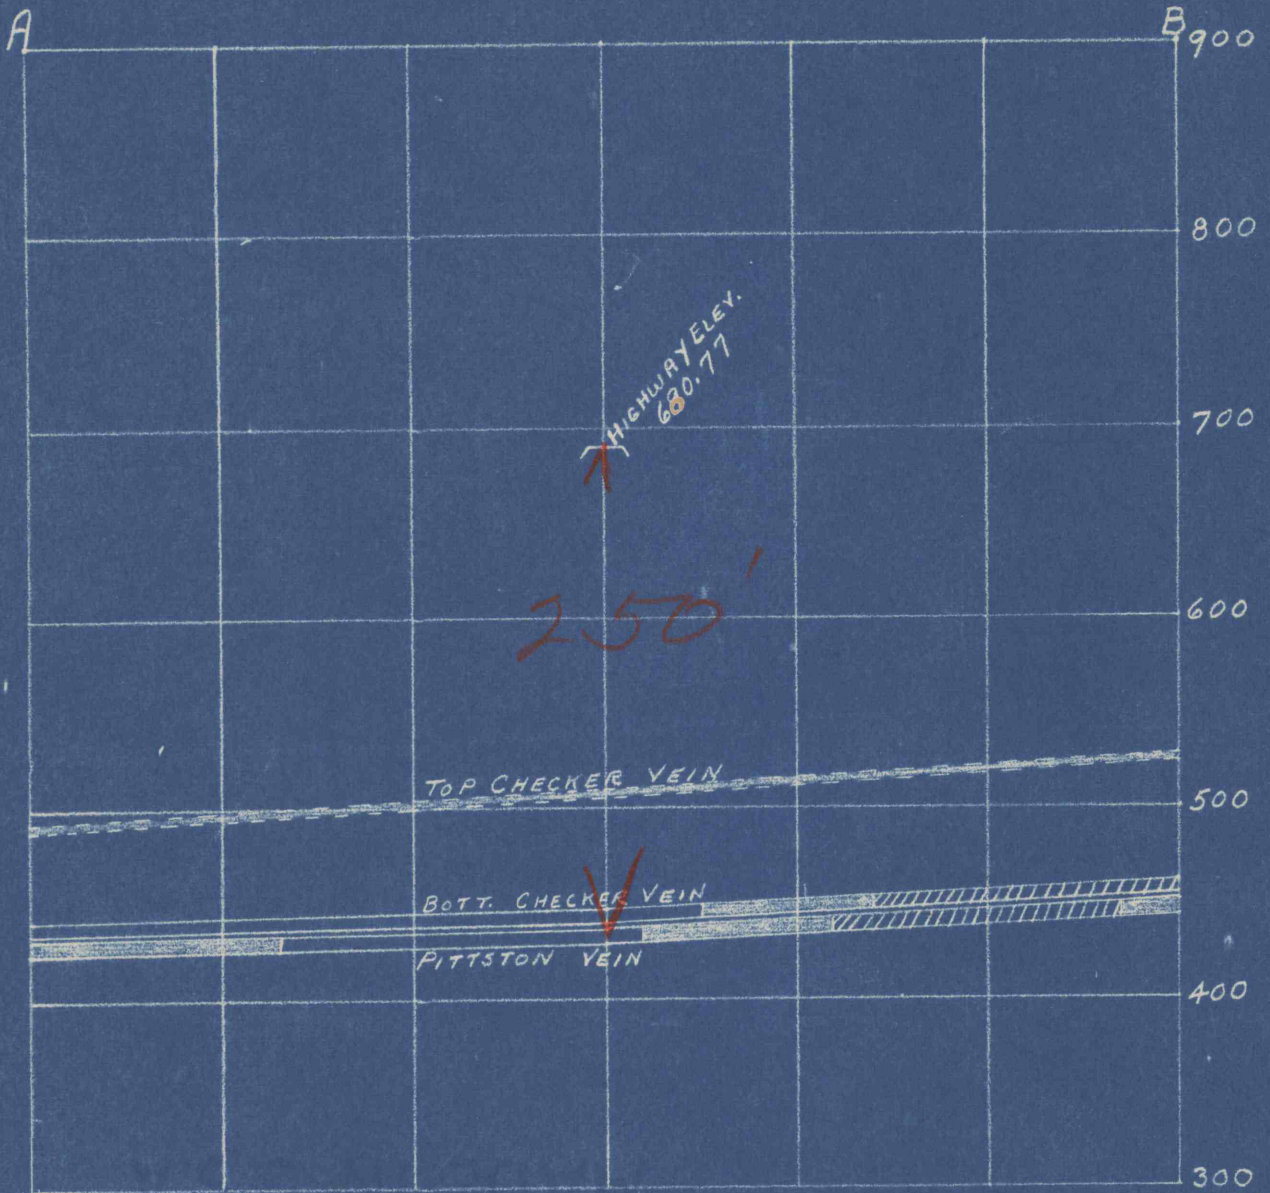


SECTION A - B



NO. 14 COLLIERY
 No. 14 Drifts - Pittston Vein
 Scale 1" - 100'

Cross section of Pittston Vein
 underlying Leg. Route #40038 in
 Plains Twp., Luzerne Co., Penna.

-  Virgin coal
-  First mining
-  Complete mining