


SECTION A - B:

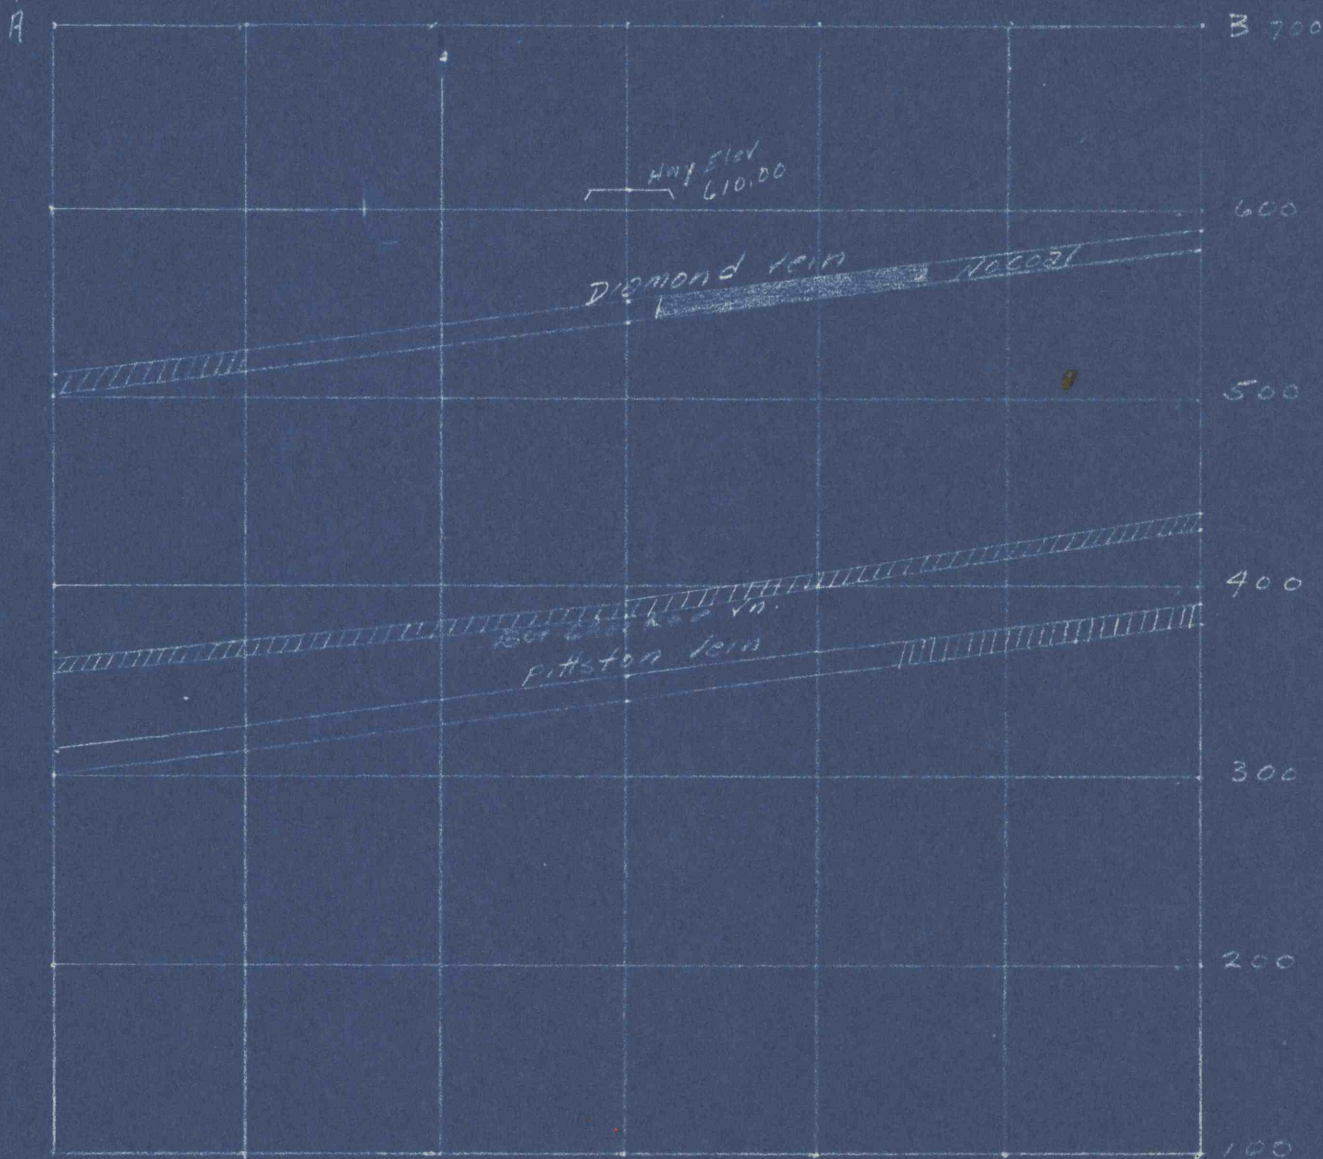




4

1st mining under + within 300'
144+00 & 149+00

NO. 14 COLLIERY
No. 14 Shaft - - - - Pittston Vein
Scale 1" = 100'

Cross section of Pittston Vein underlying Leg. Route #40038 in Plains Township, Luzerne County, Penna.

-  Virgin coal
-  First mining
-  Complete mining